



SOUTH

18 17 16 15 14 13 12 11 10 9 8 7 6 5 4

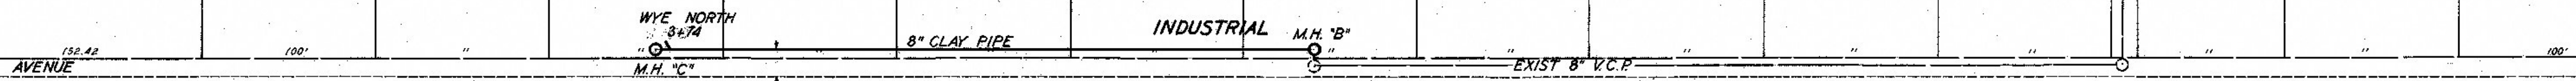


19 20 21 22 23 24 25 26 27 28 29 30


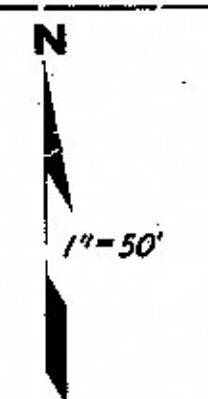


AS BUILT PLAN
71-540 EARTH EXCAVATION CO.
MARCH 1972

PLAN
 SURVEYED
 ALIGNED
 NOTE BOOK ALIGNED CHECKED
 RT. OF WAY CHECKED
 NO.

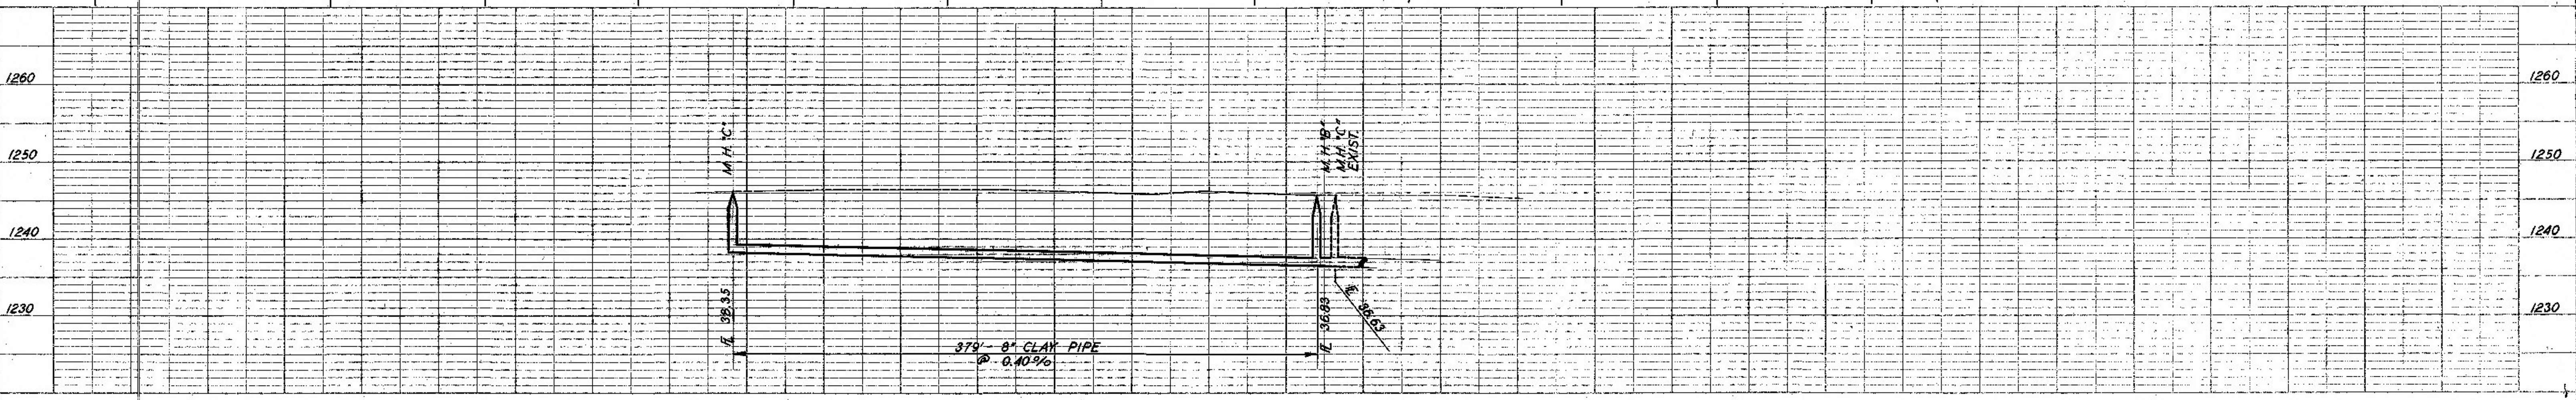

PROFILE
 SURVEYED
 NOTED
 NOTE BOOK NOTED
 B. A. S. NOTED
 STRUCTURE NOTATIONS CHECKED
 NO.

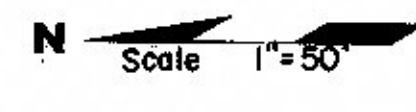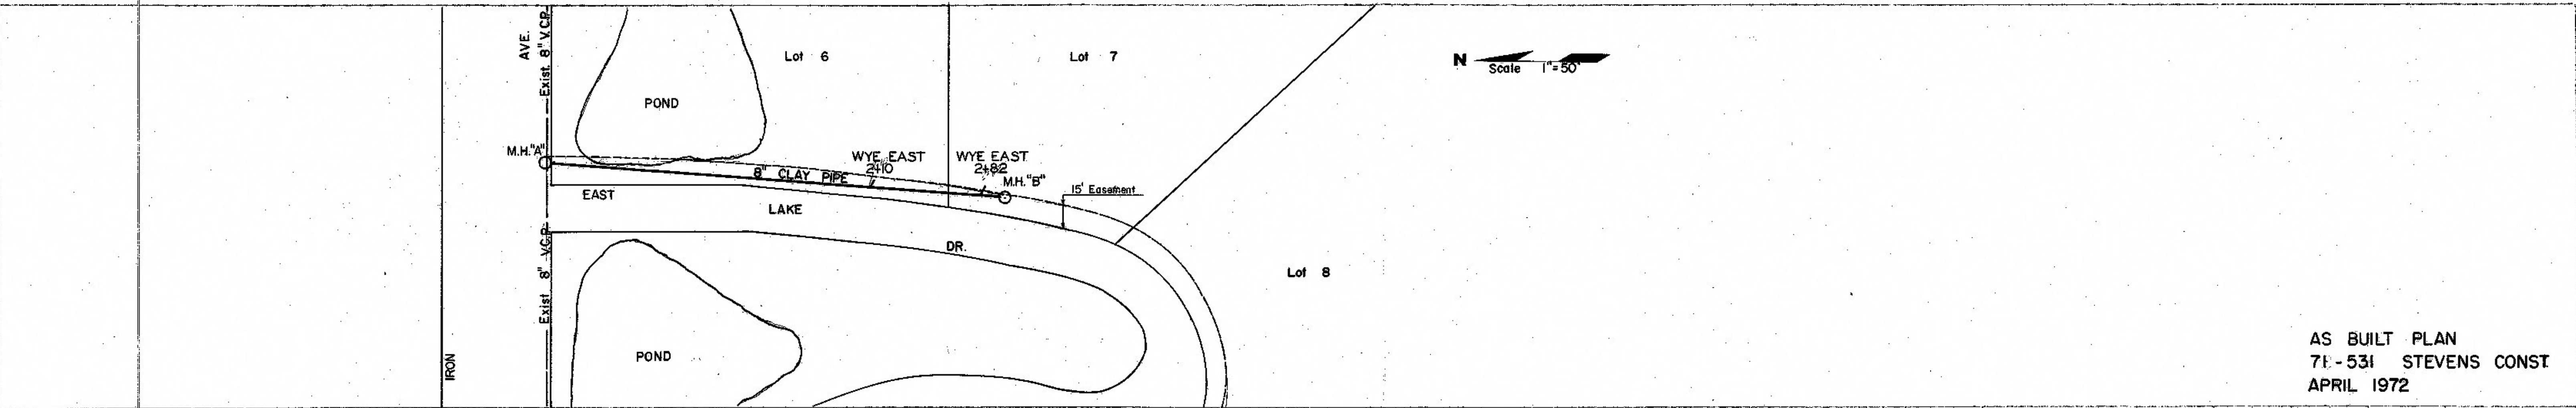

AS BUILT PLAN
71-531 STEVENS CONST
APRIL 1972

