


Scale 1" = 50'



Scale 1" = 50'

PLAN	SUBMITTED BY	DATE
	NOTED	
	APPROVED	
	DATE	
	BY	
	NO.	
	NO.	

PROFILE	SUBMITTED BY	DATE
	NOTED	
	APPROVED	
	DATE	
	BY	
	NO.	
	NO.	

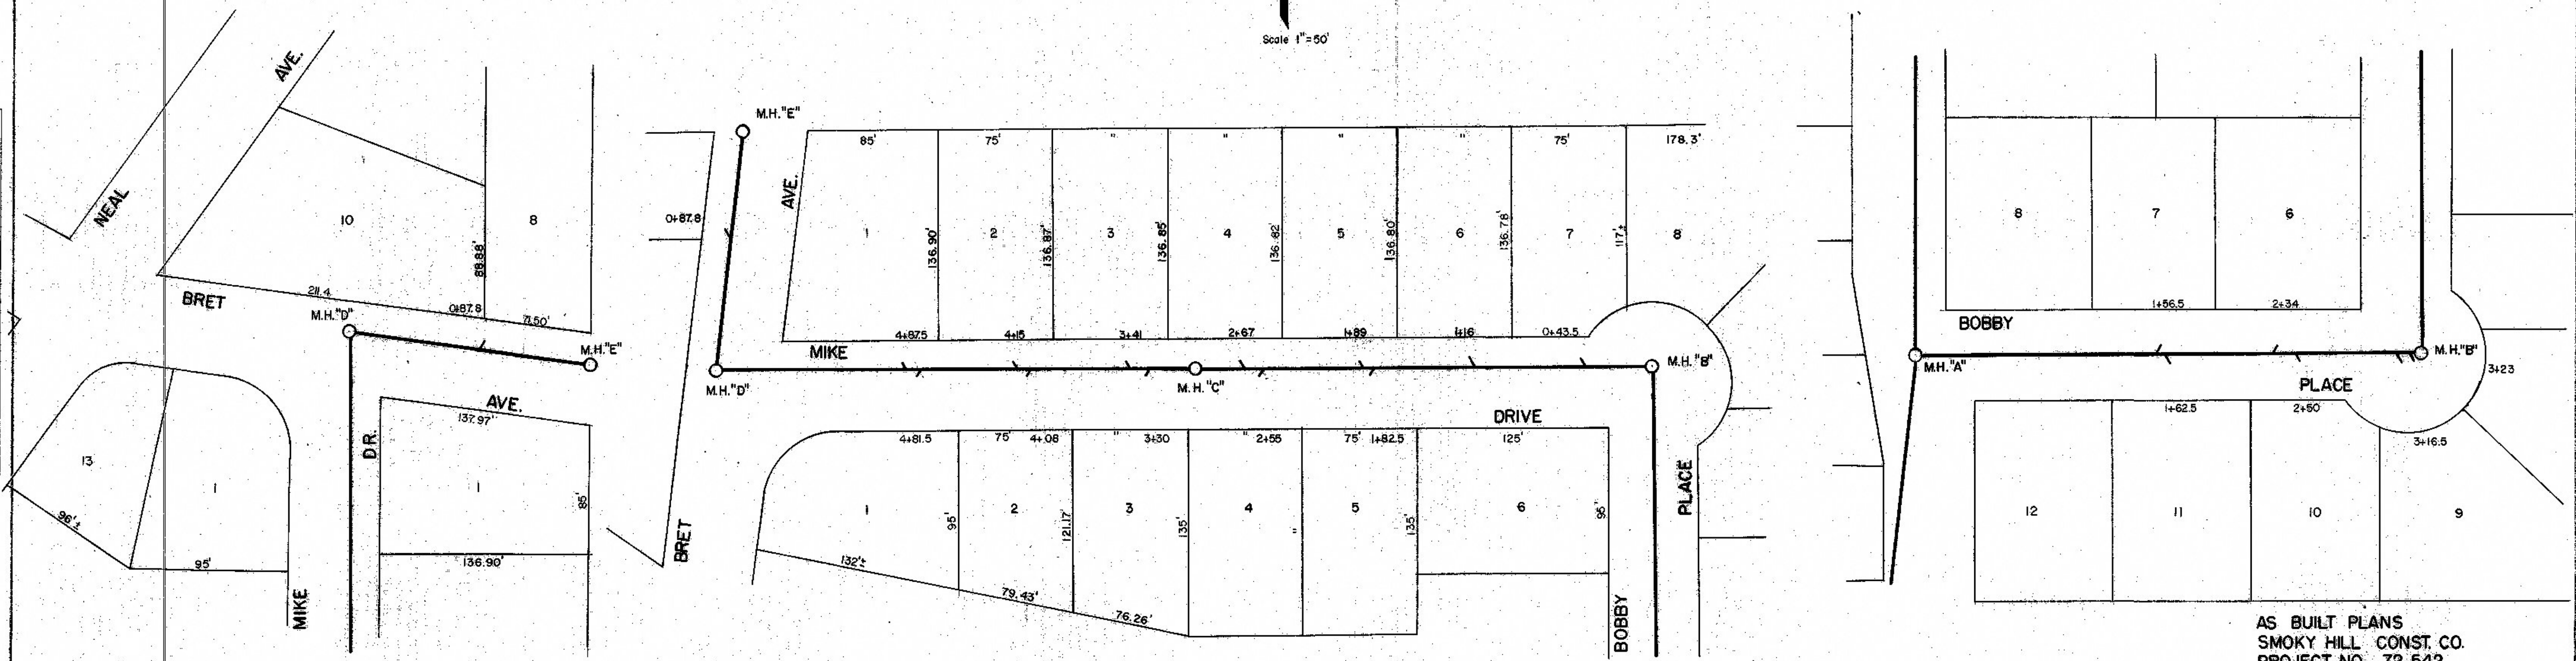

AS BUILT PLANS
SMOKY HILL CONST. CO.
PROJECT NO. 72-542
APRIL 1972

