
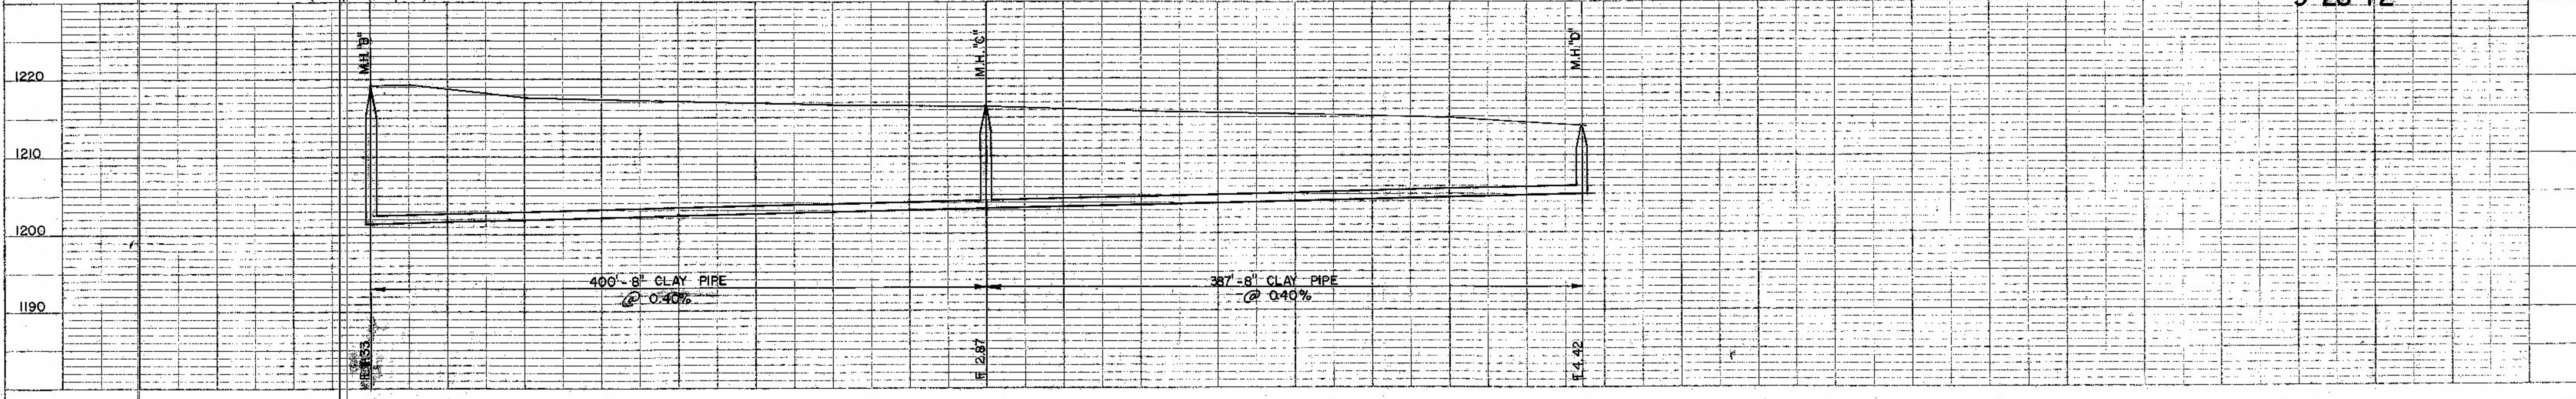
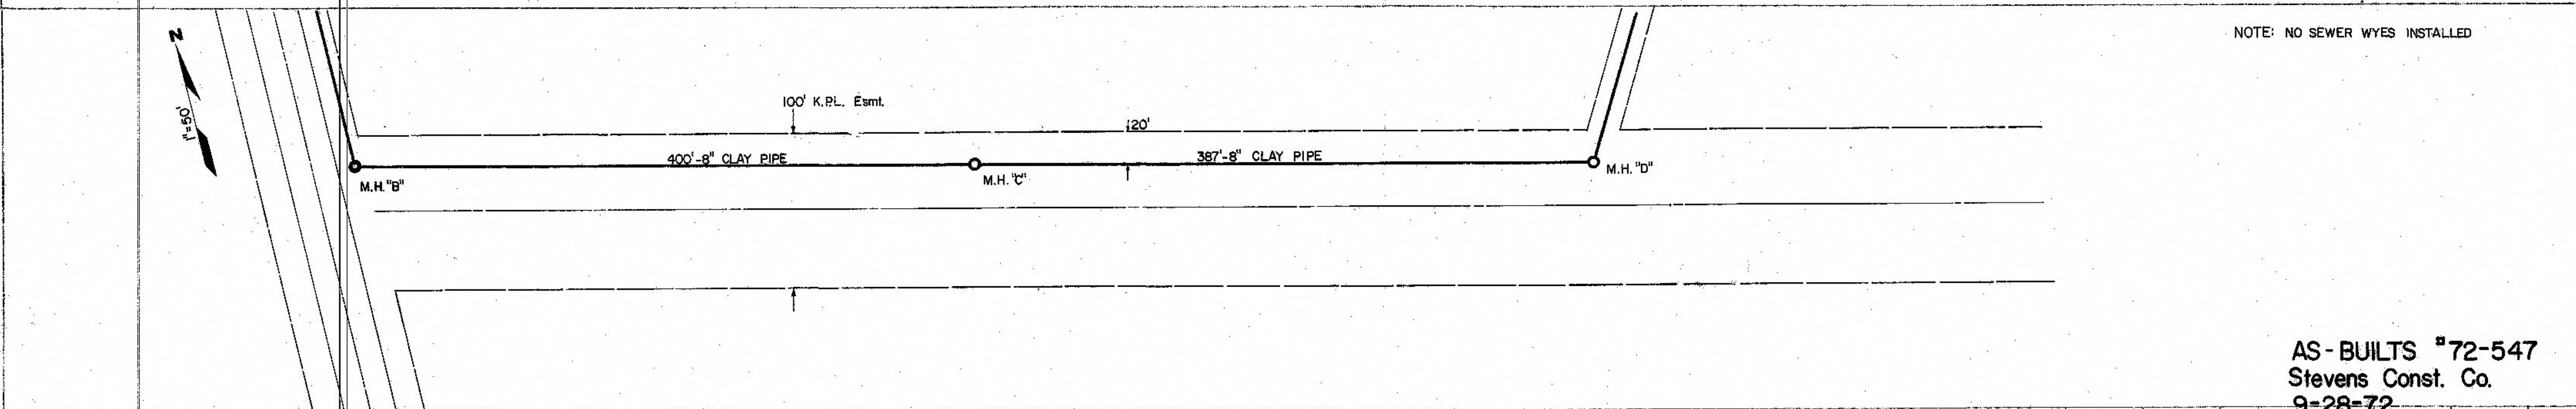
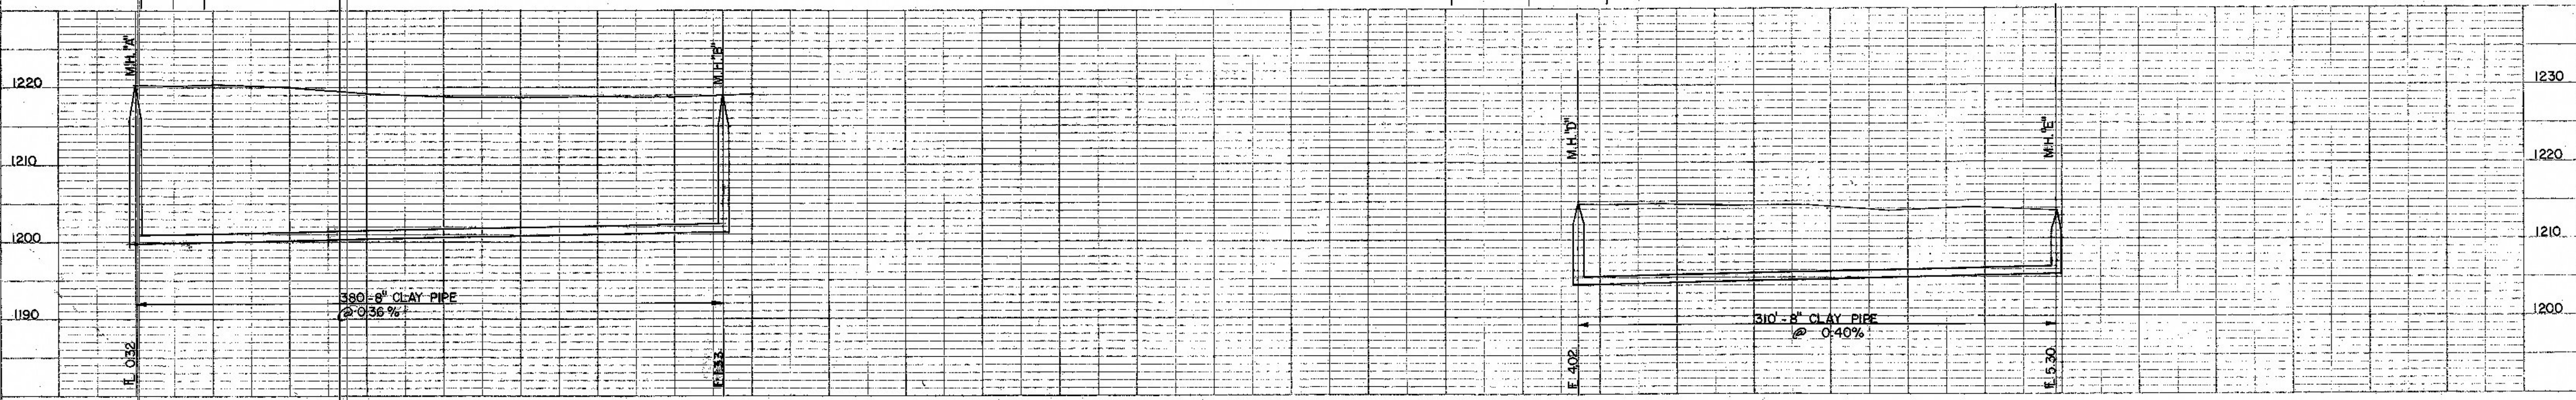


PLAN
 DRAWN BY: []
 CHECKED BY: []
 DATE: []
 NO. []

PROFILE
 DRAWN BY: []
 CHECKED BY: []
 DATE: []
 NO. []

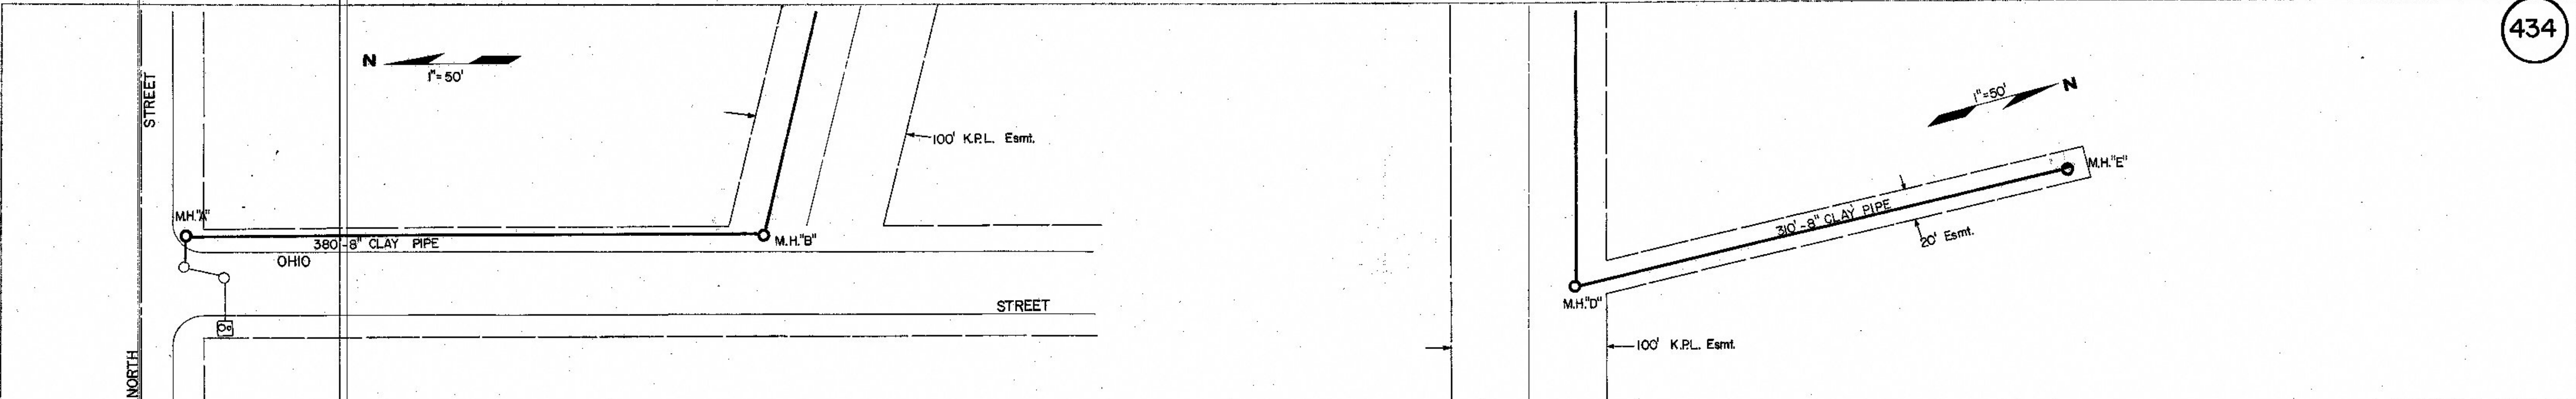

NOTE: NO SEWER WYES INSTALLED

AS-BUILTS #72-547
 Stevens Const. Co.
 9-28-72