
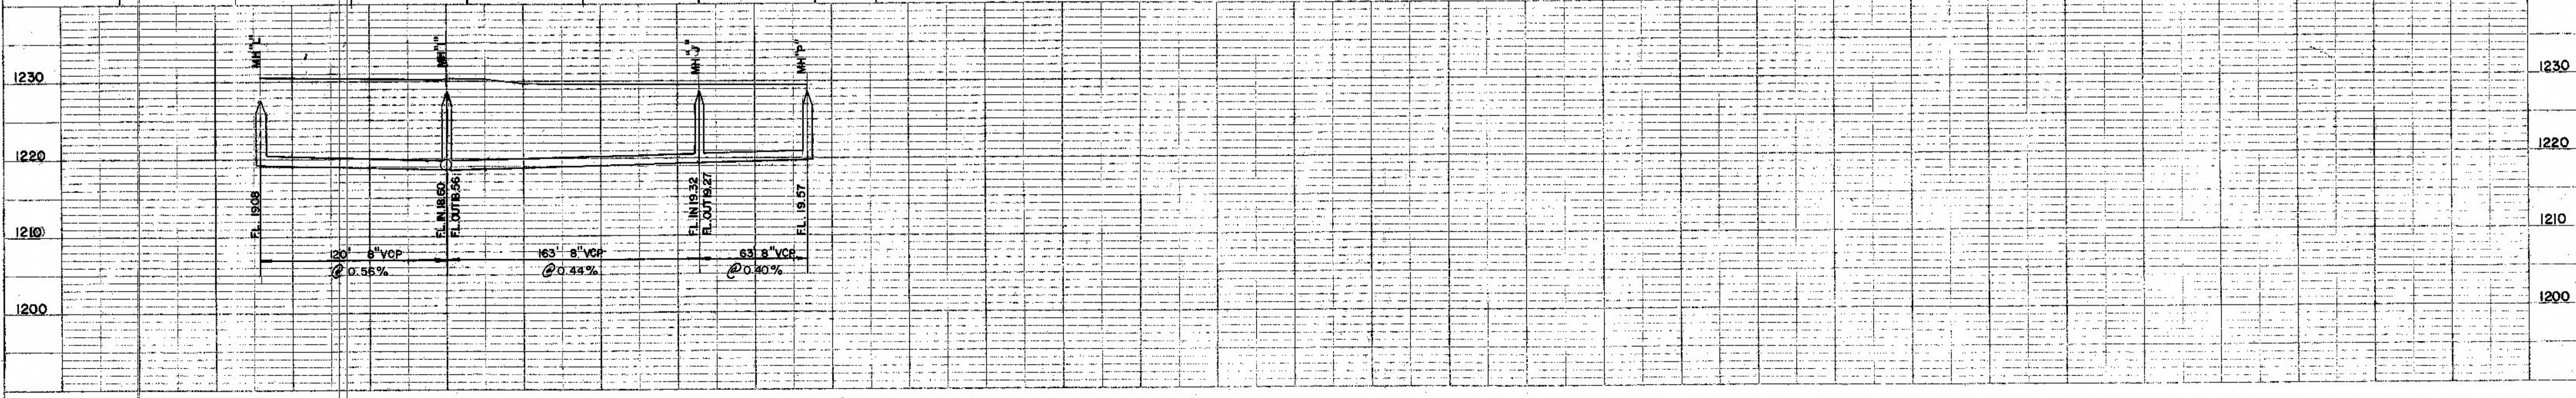
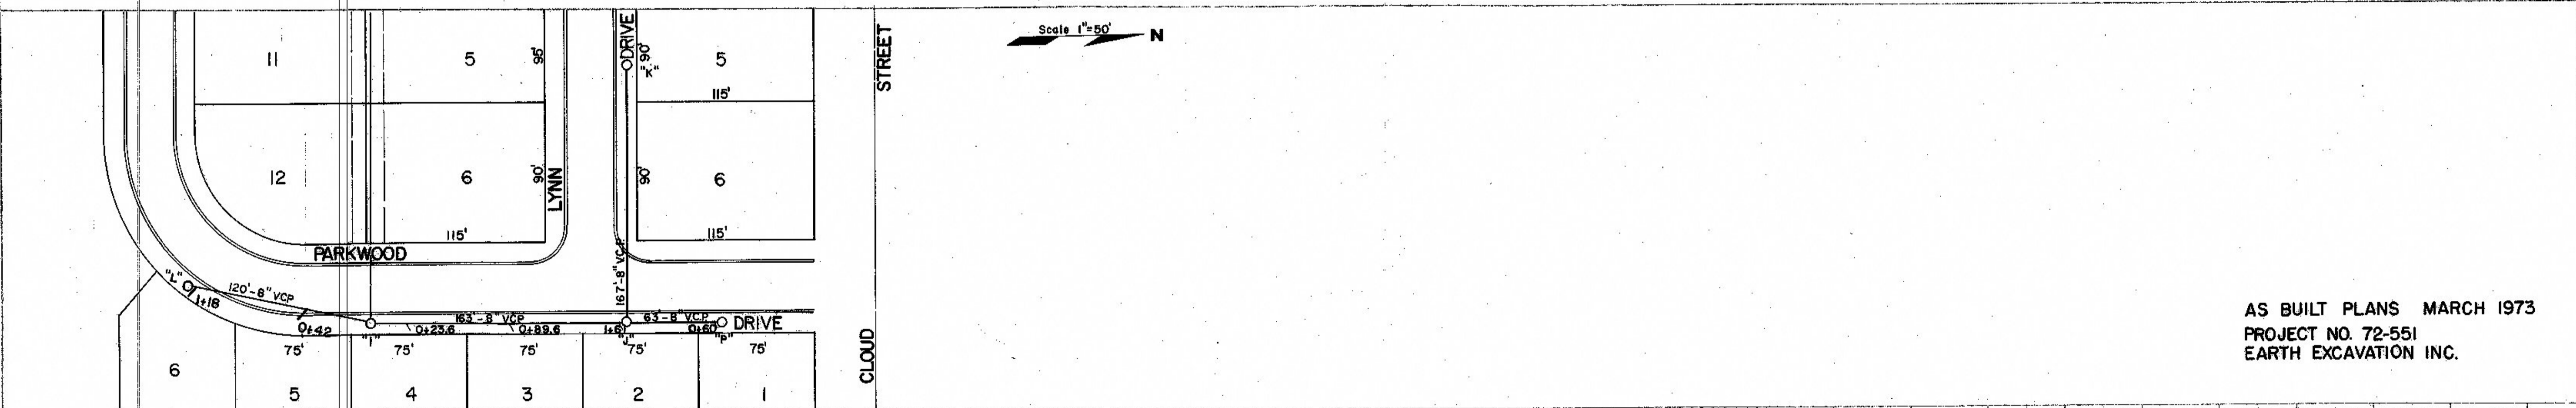
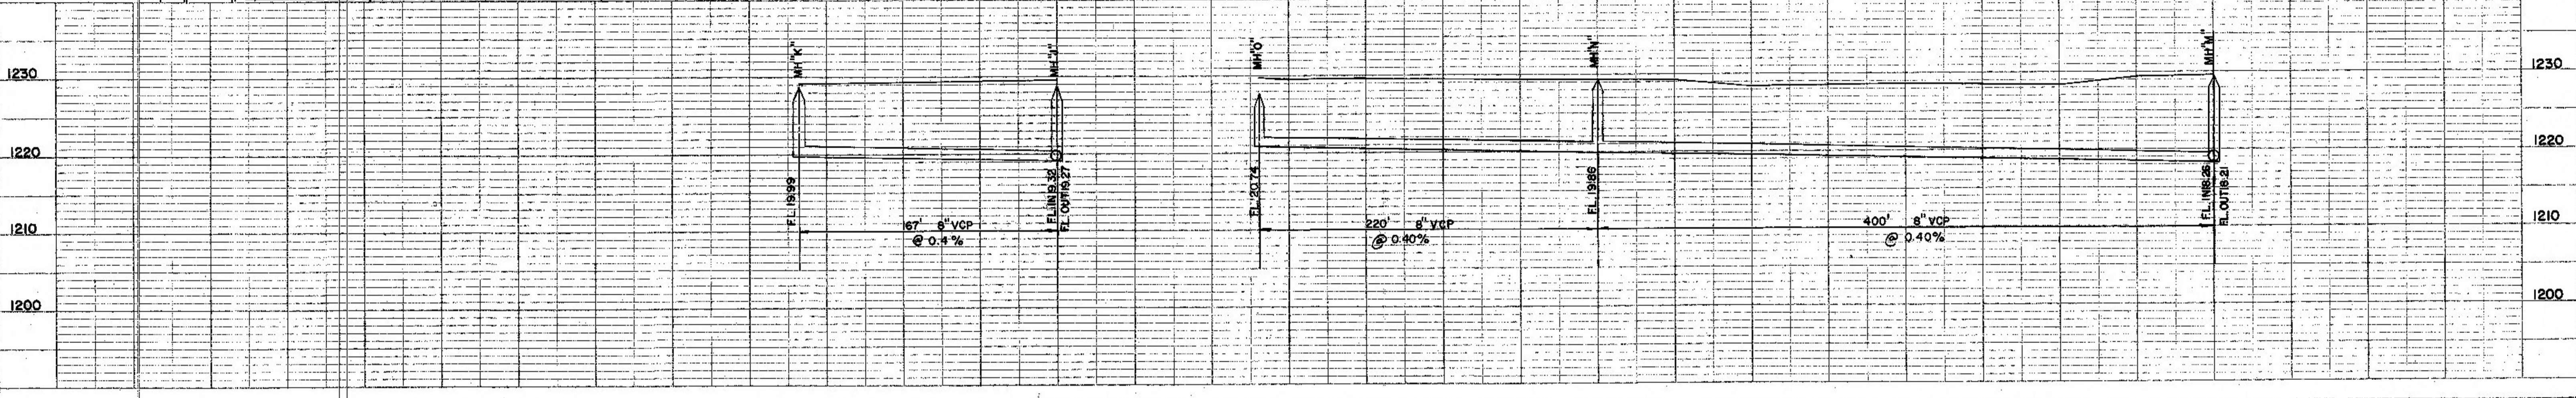


PLAN SURVEYED BY DATE
 NOTES BOON JAMES W. CHECKED
 REVISIONS BY DATE
 NO. OF WAYS CHECKED

PROFILE SURVEYED BY DATE
 PLOTTED BY DATE
 GRADES CHECKED BY DATE
 STRONG POINTS IN FEET

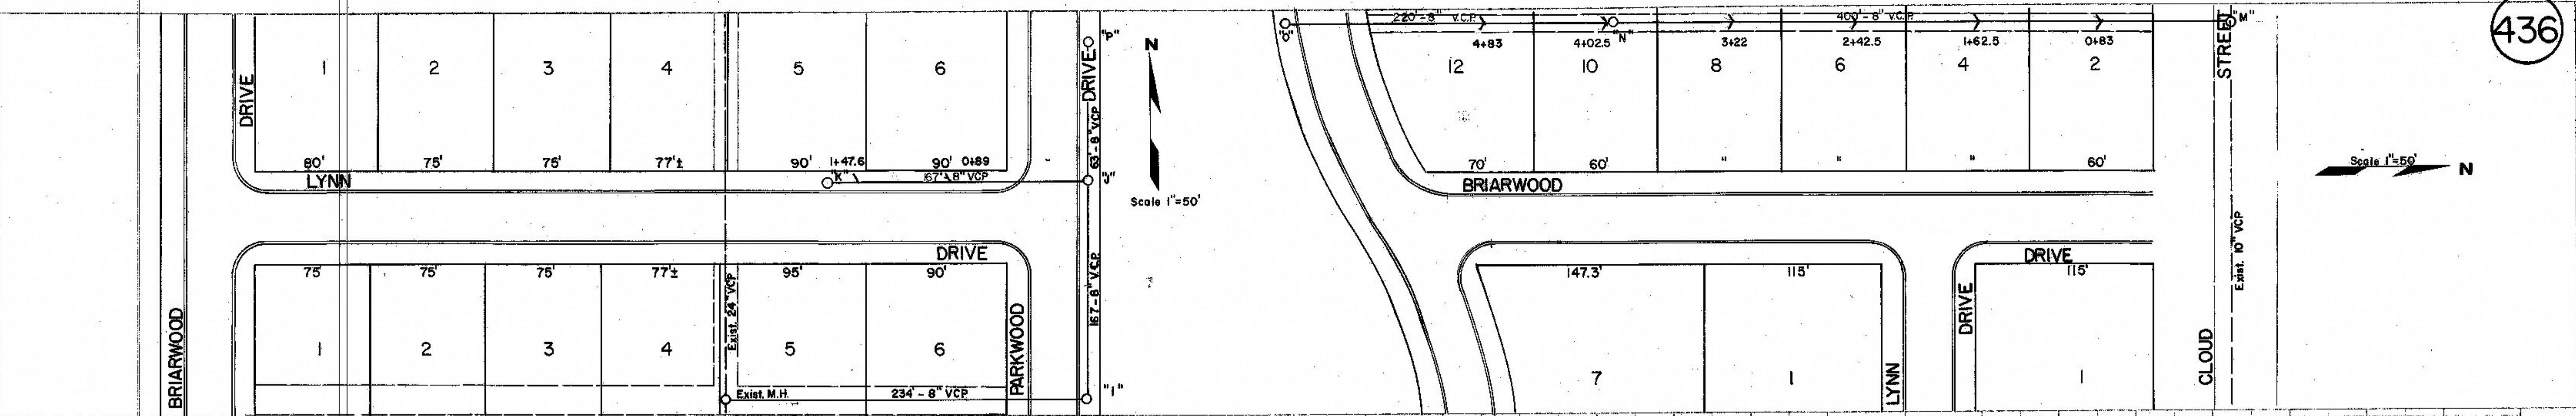

AS BUILT PLANS MARCH 1973
 PROJECT NO. 72-551
 EARTH EXCAVATION INC.