


BROWN & BROWN

437




Scale 1"=50'

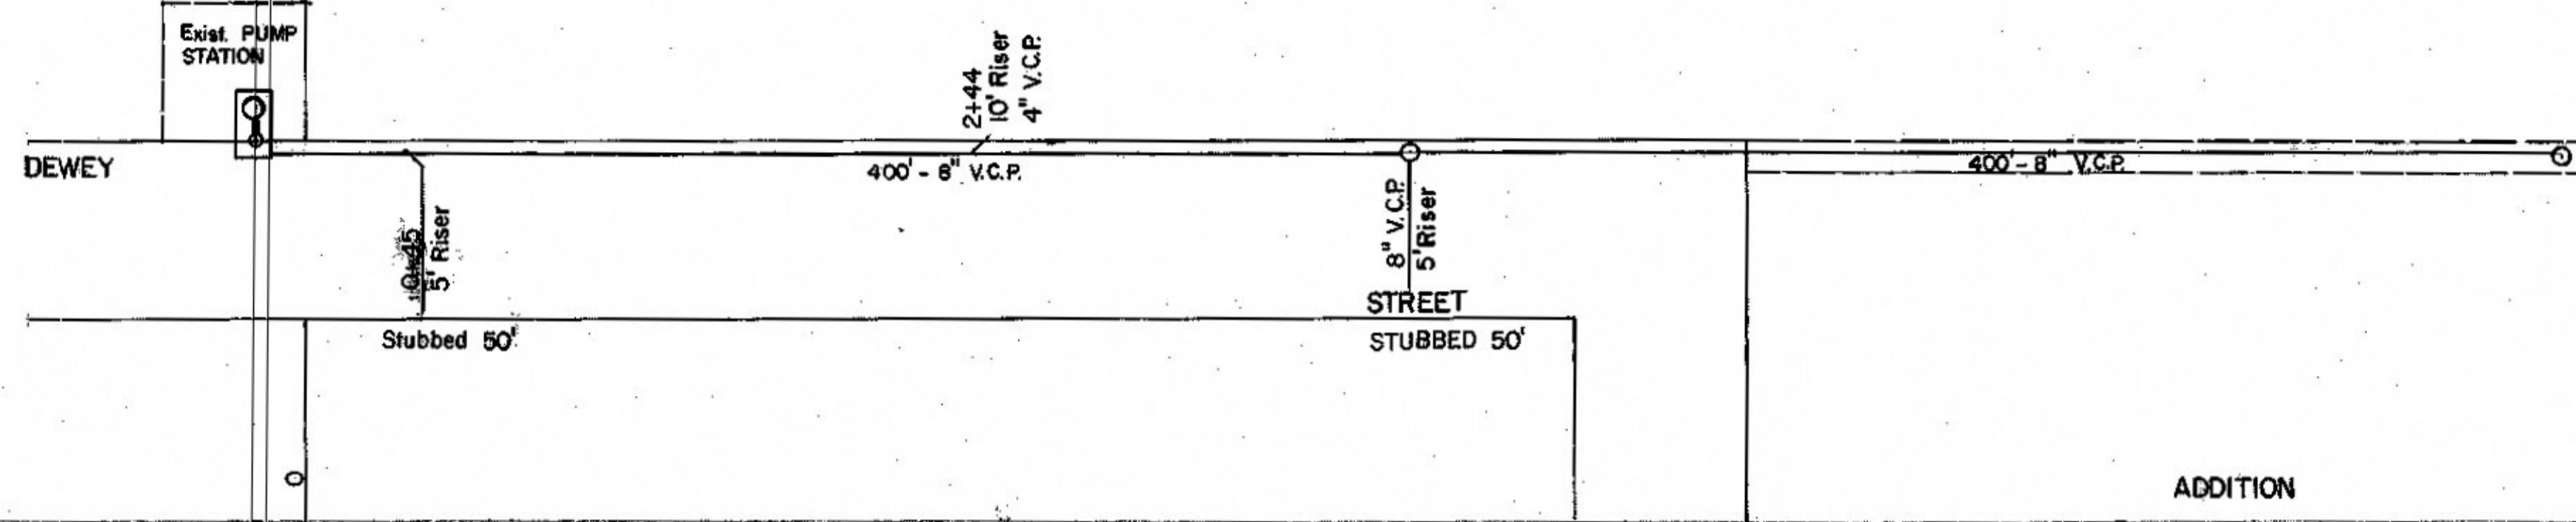


AS-BUILT PLANS
PROJECT NO. 72-552
CONTRACTOR EARTH EXCAVATION

PLAN
SUBMITTED BY DATE
PLOTTED BY DATE
NOTE BOOK ALIGNMENT CHECKED BY DATE
NO. OF REVISIONS

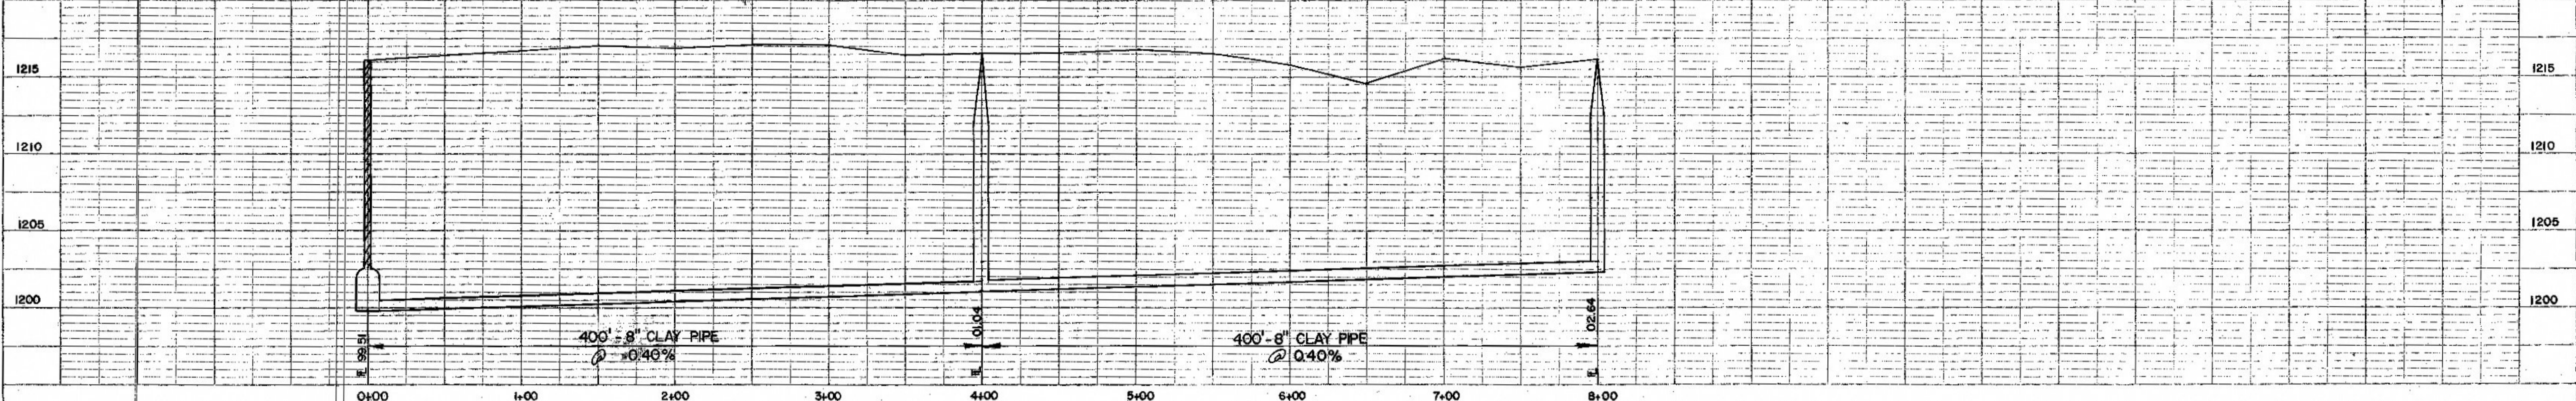

PROFILE
SUBMITTED BY DATE
PLOTTED BY DATE
NOTE BOOK GRADES CHECKED BY DATE
STRUCTURE DATA CHECKED BY DATE

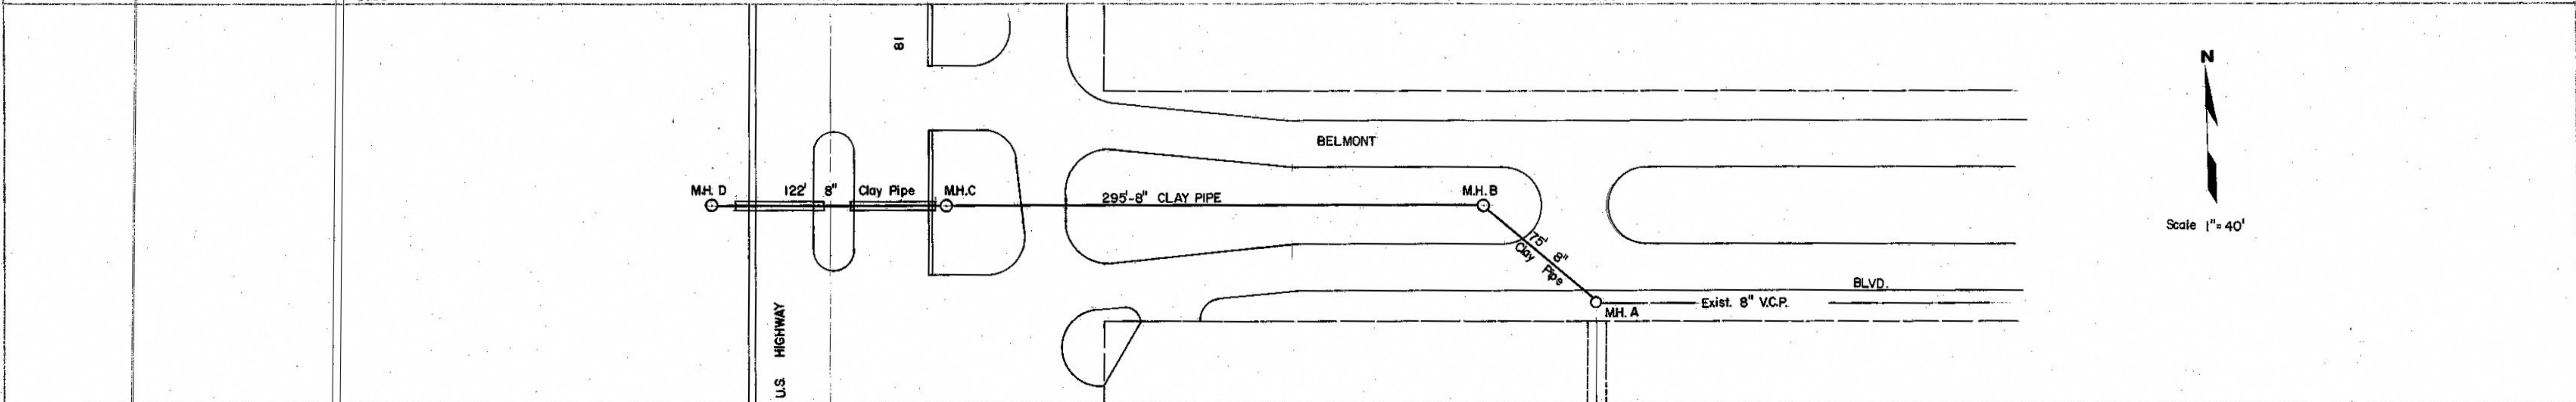

Scale 1"=40'

