
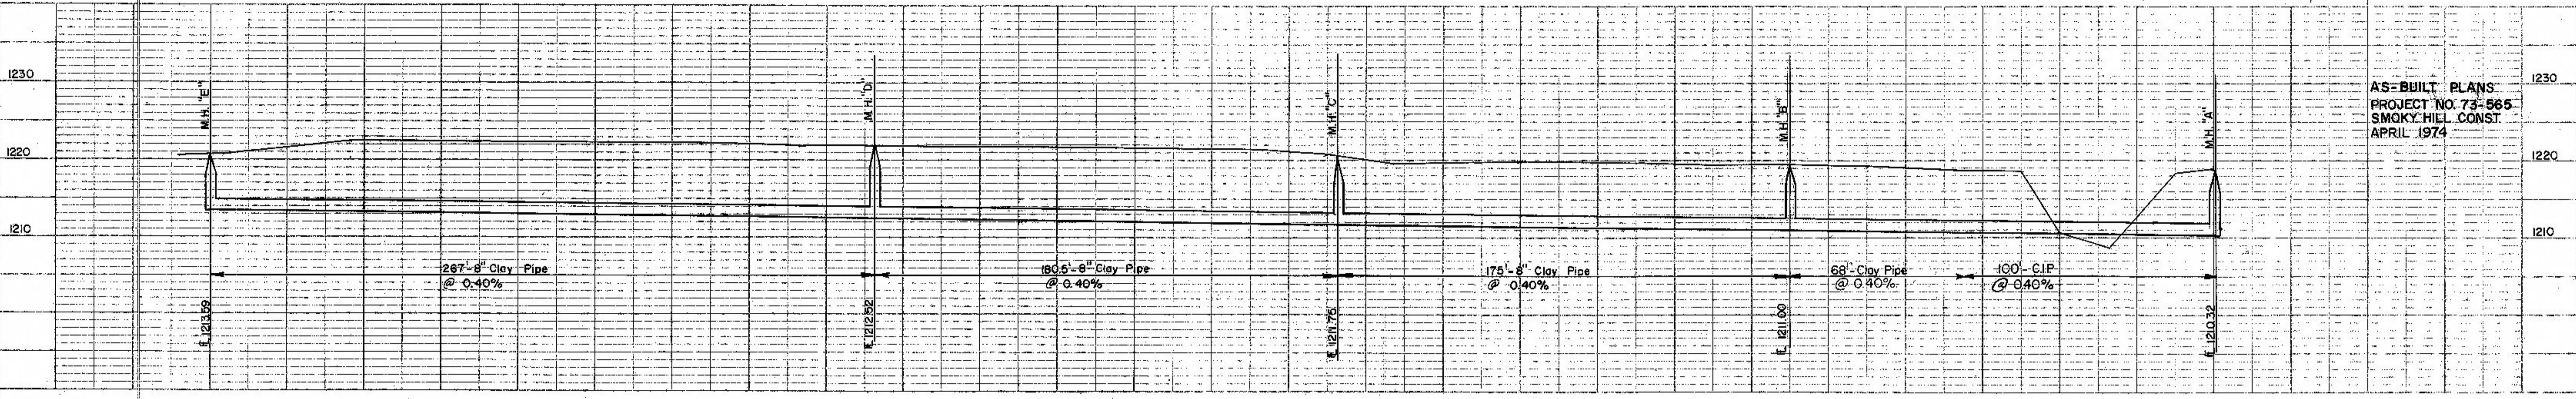


PLAN
 SURVEYED BY
 DATE
 CHECKED BY
 DATE
 NOTE BOOK NO.
 BY OF WAY CHECKED

PROFILE
 SURVEYED BY
 DATE
 CHECKED BY
 DATE
 NOTE BOOK NO.
 BY OF WAY CHECKED

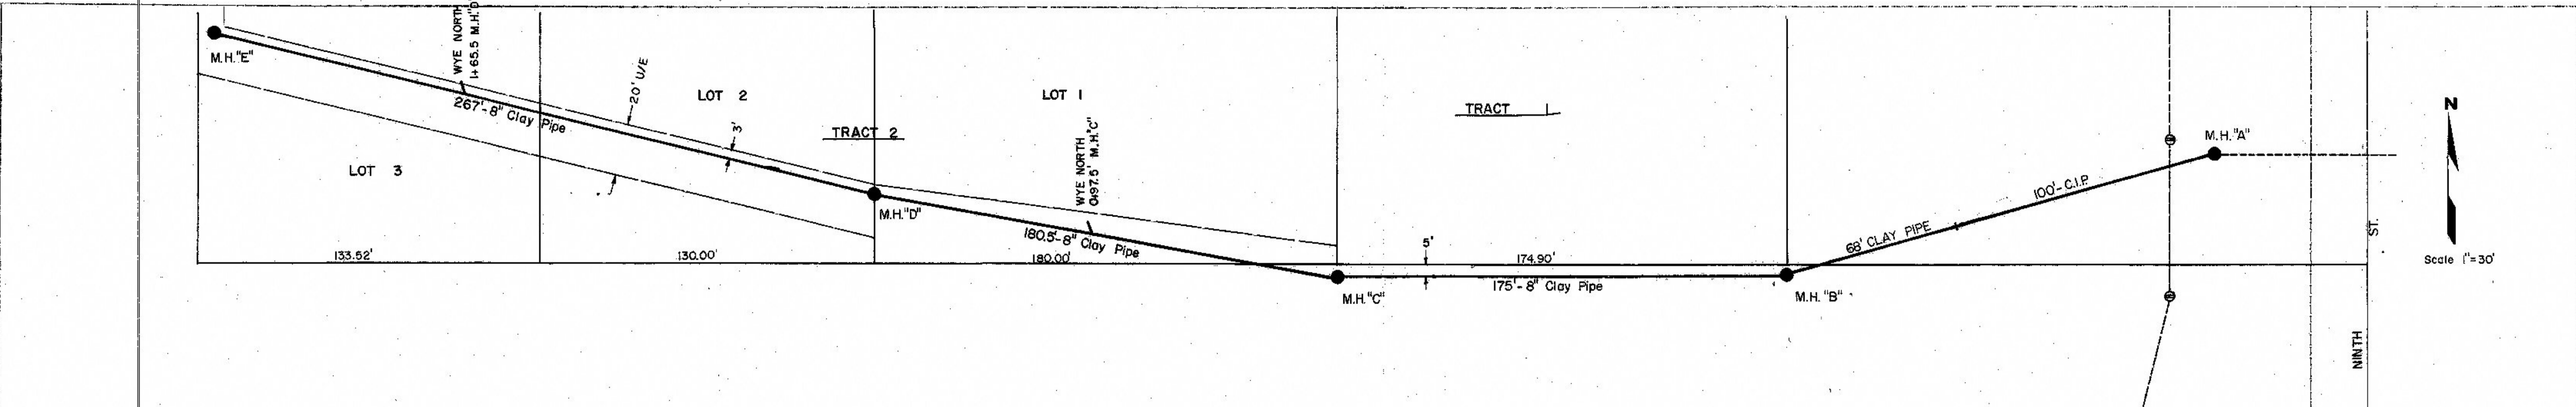

AS-BUILT PLANS
 PROJECT NO. 73-565
 SMOKY HILL CONST.
 APRIL 1974

440