



PLAN	SURVEYED	BY	DATE
	NOTED		
	BOOK		
	ALIGNED		
	CHECKED		
	NO.		
	RT. OF WAY		
	CHECKED		

PROFILE	SURVEYED	BY	DATE
	NOTED		
	BOOK		
	GRADES		
	CHECKED		
	NO.		
	STRUCTURE		
	ADJUST		
	PER		
	CH		
	NO.		

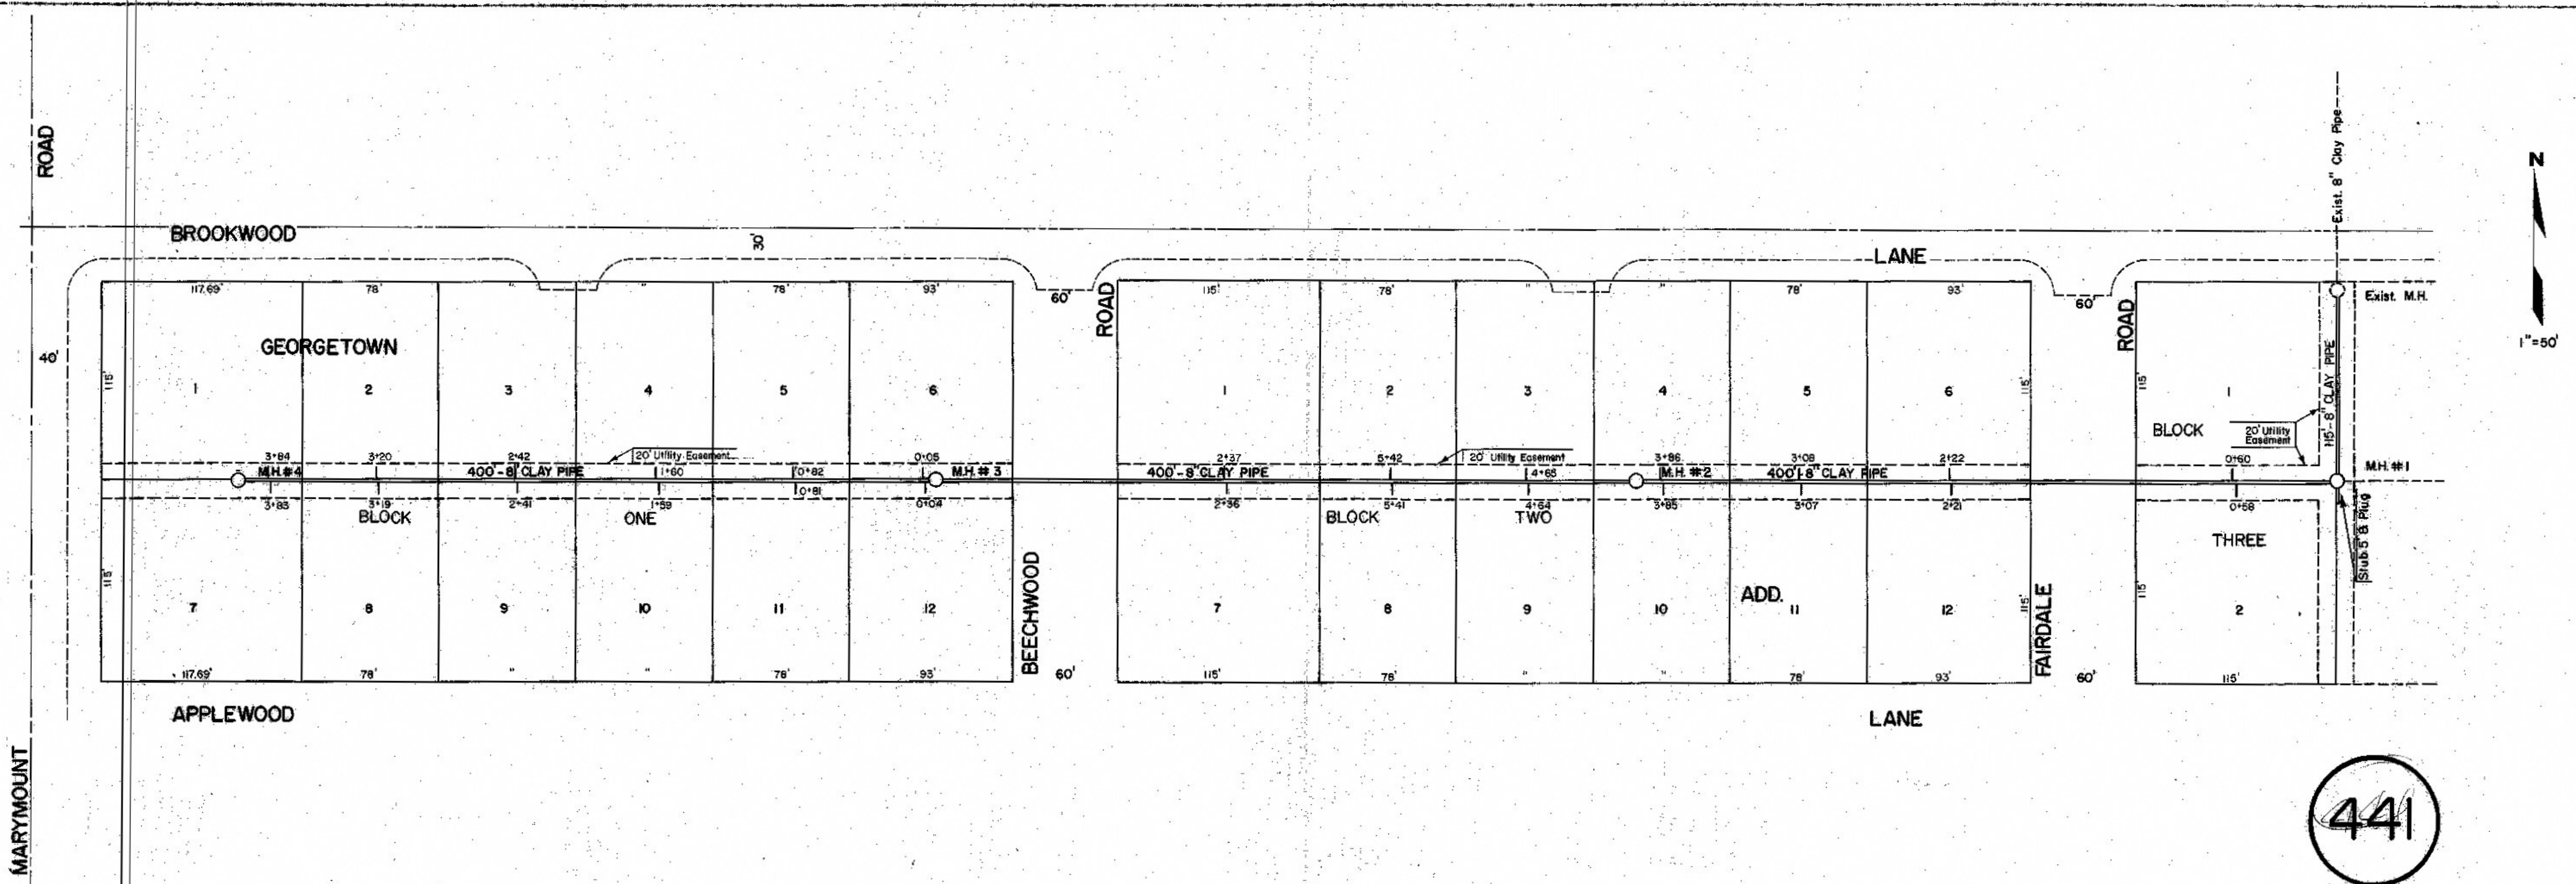

441

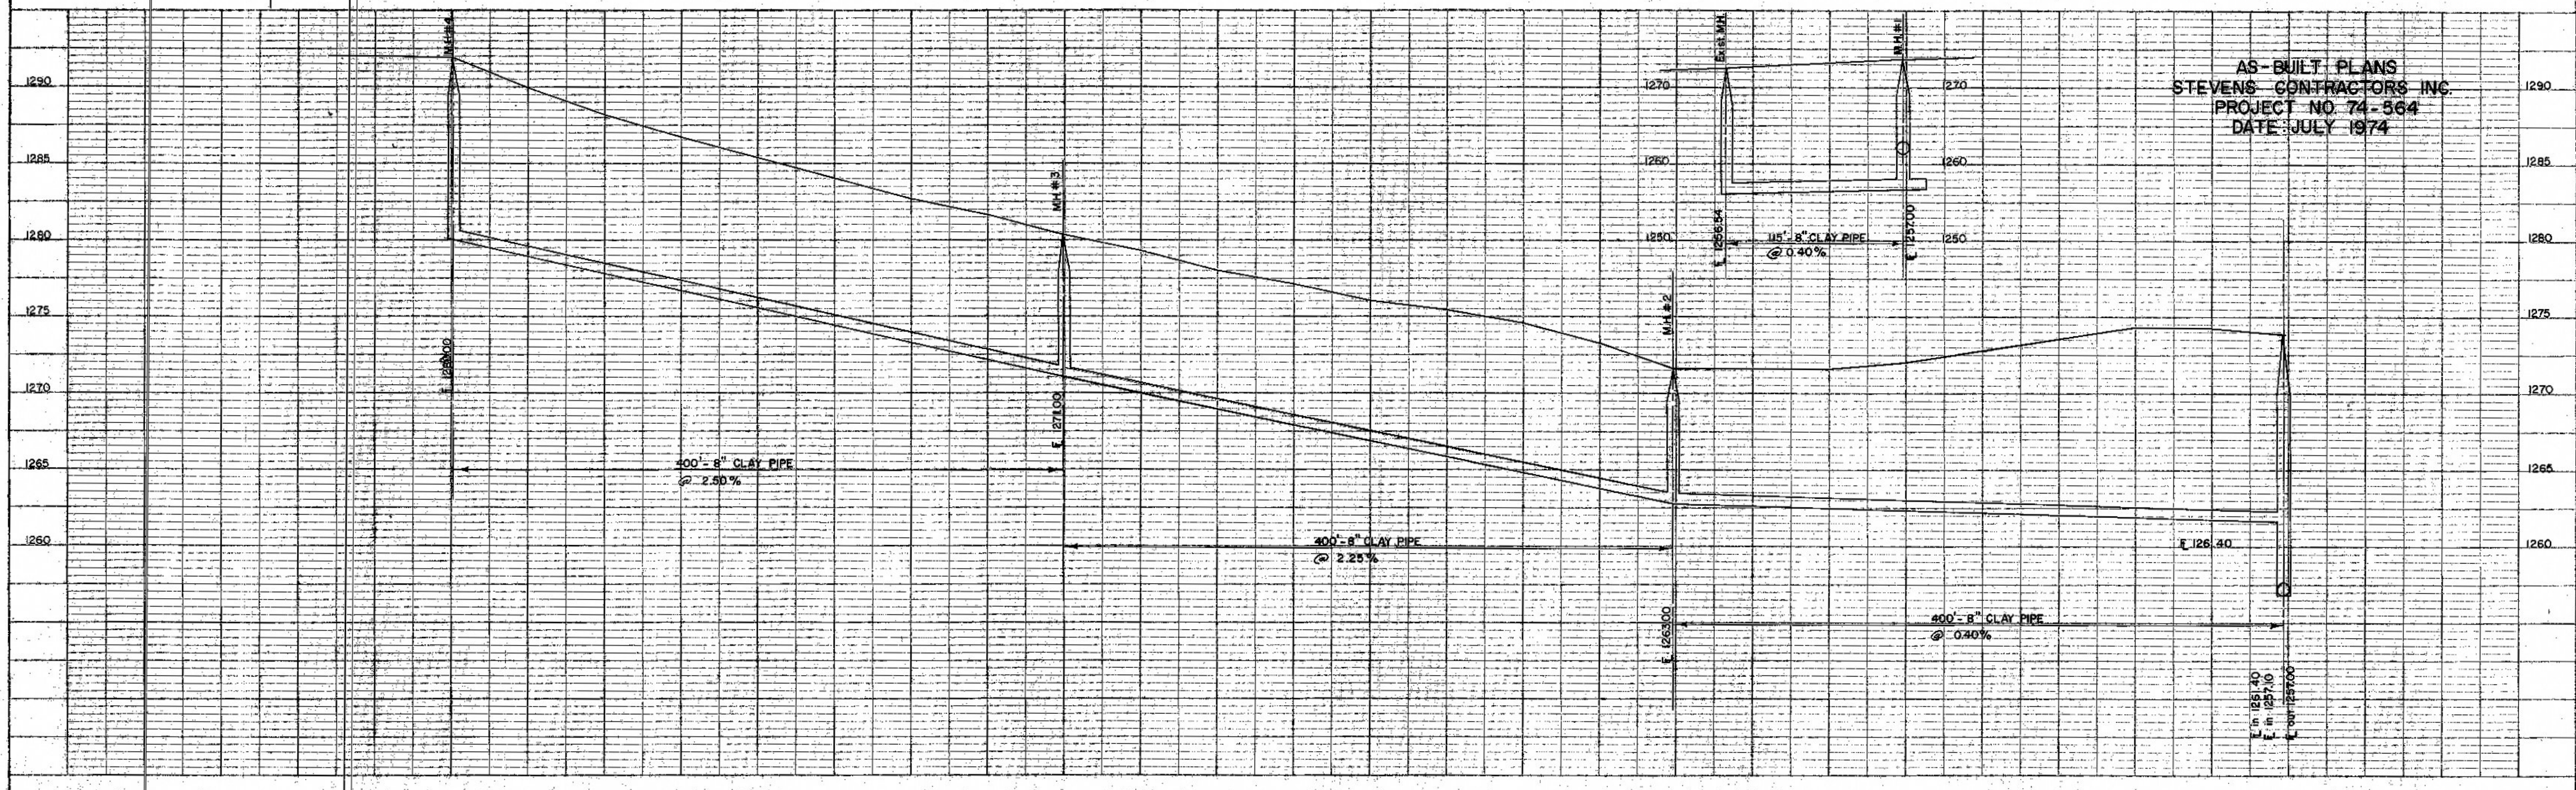

AS-BUILT PLANS
 STEVENS CONTRACTORS INC.
 PROJECT NO 74-564
 DATE JULY 1974