


PLAN
 SURVEYED BY _____ DATE _____
 PLOTTED BY _____
 NOTE BOOK ALIGNMENT CHECKED _____
 RT. OF WAY CHECKED _____
 NO. _____

PROFILE
 SURVEYED BY _____ DATE _____
 PLOTTED BY _____
 NOTE BOOK GRADES CHECKED _____
 S. U. S. NOTED _____
 STRUCTURE WORKING CHECKED _____
 NO. _____

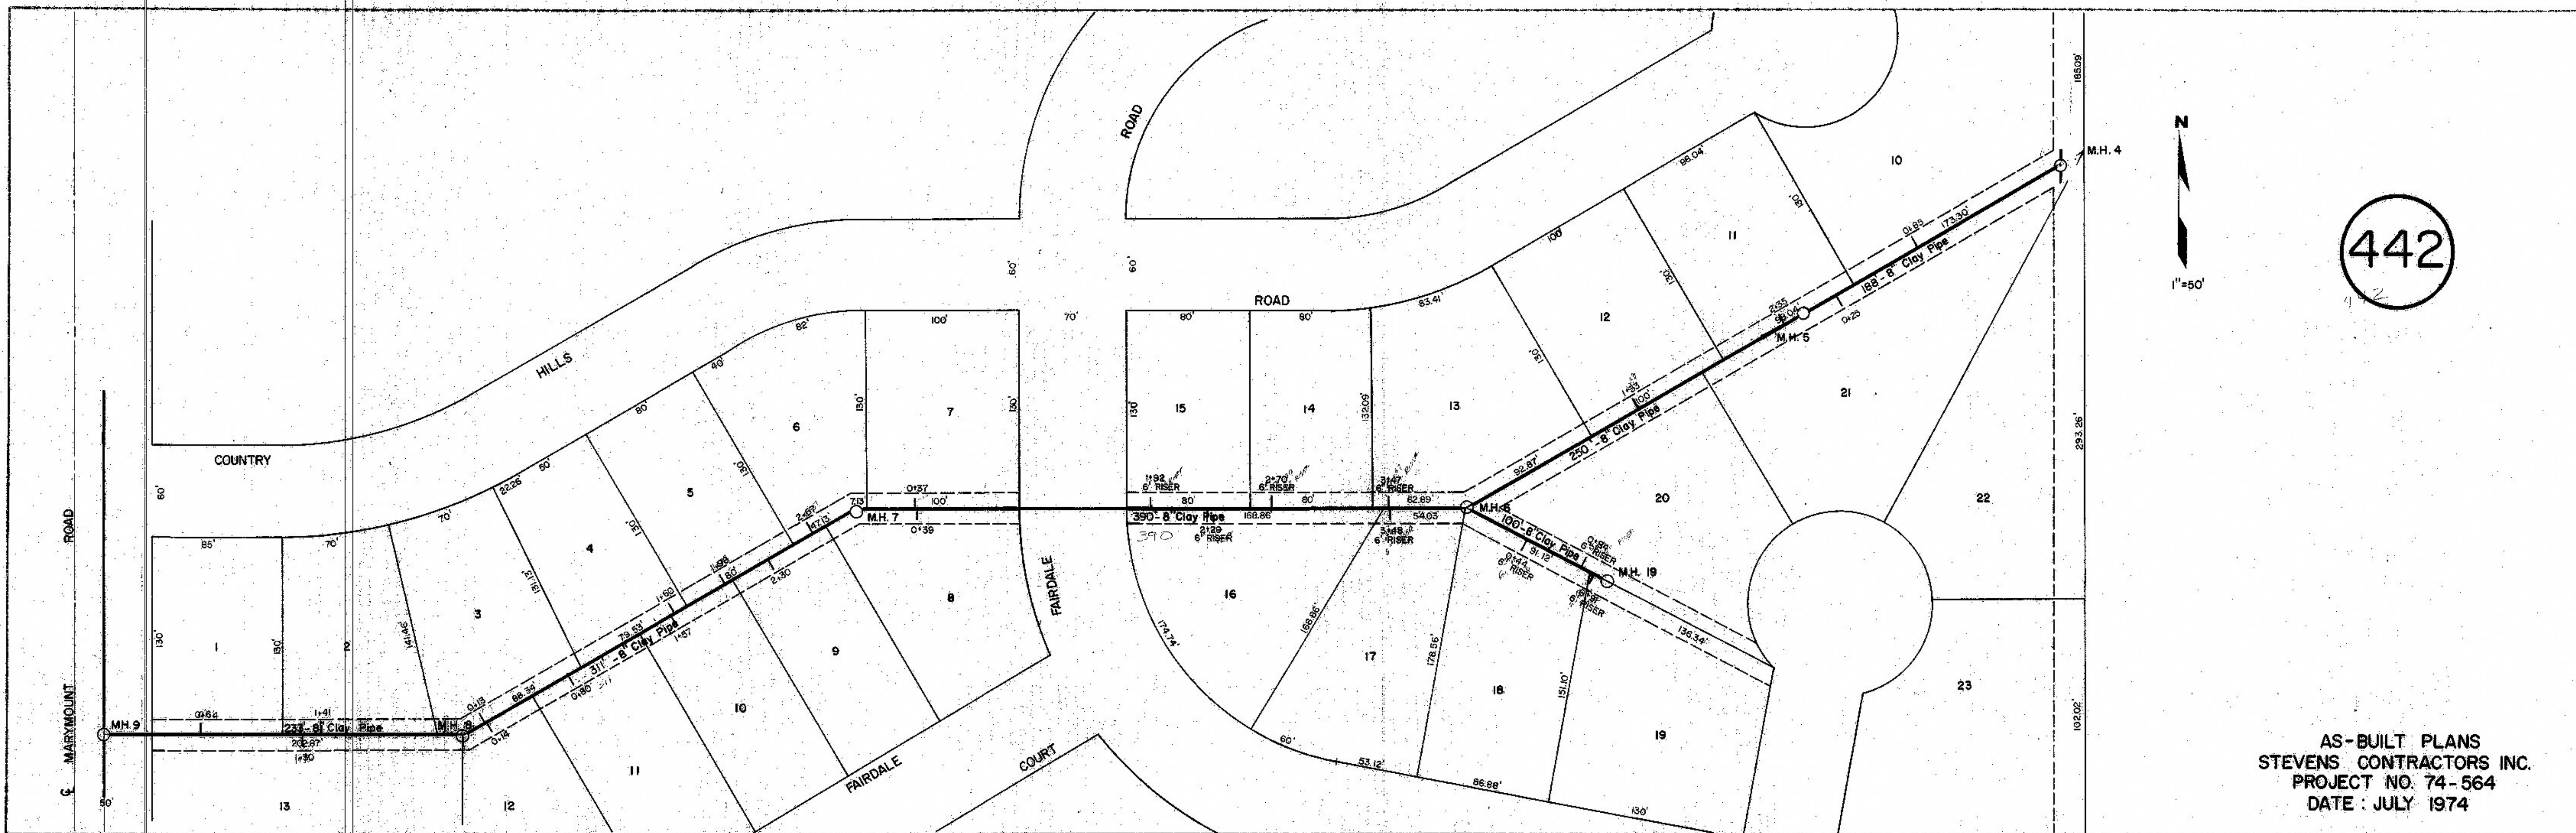

442

AS-BUILT PLANS
 STEVENS CONTRACTORS INC.
 PROJECT NO. 74-564
 DATE: JULY 1974

