
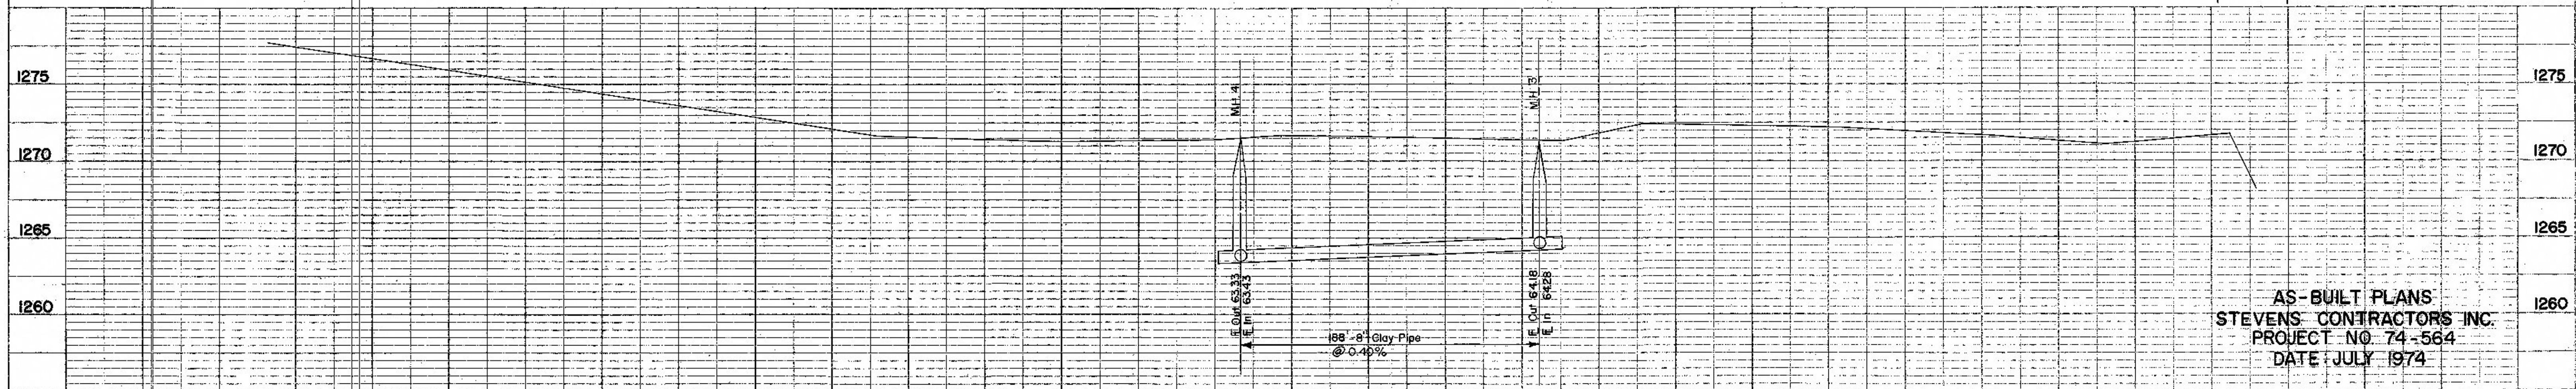
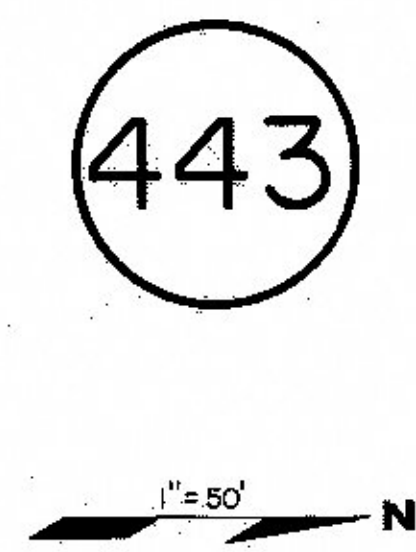


PLAN  
 DATE  
 BY  
 CHECKED  
 NO. OF WAY CHECKS

PROFILE  
 DATE  
 BY  
 CHECKED  
 NO. OF WAY CHECKS

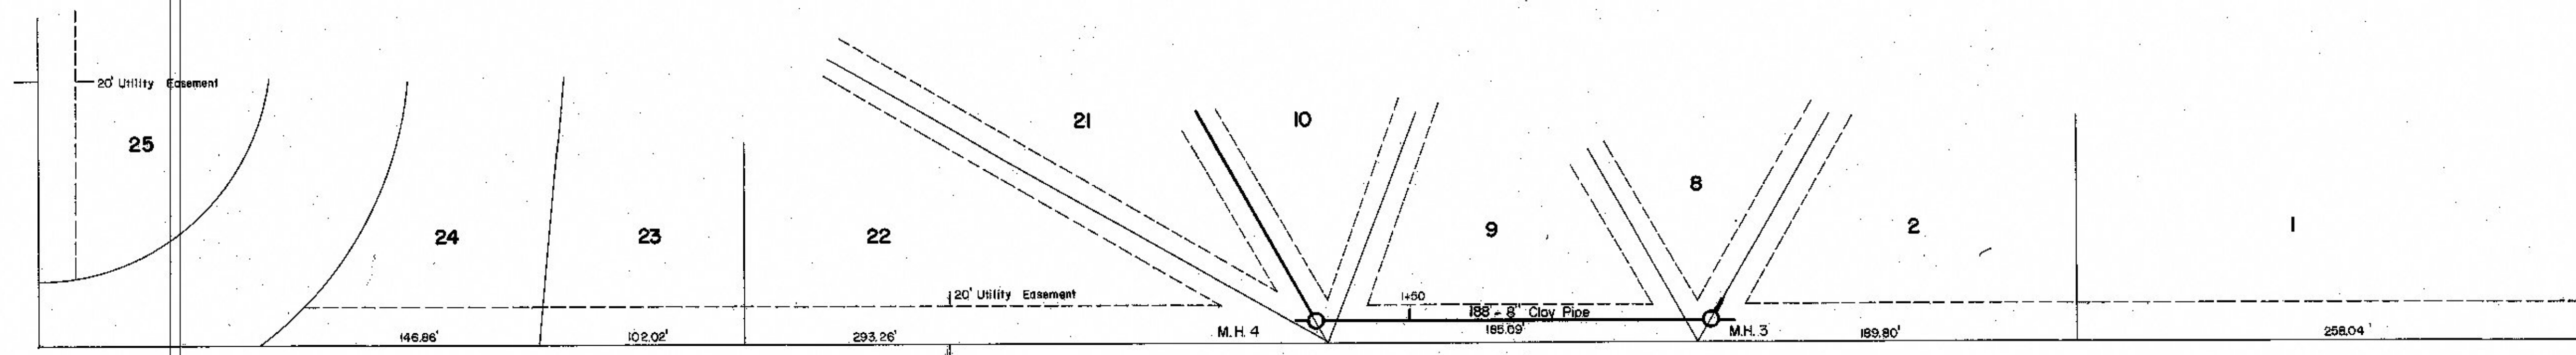

AS-BUILT PLANS  
 STEVENS CONTRACTORS INC.  
 PROJECT NO. 74-564  
 DATE JULY 1974

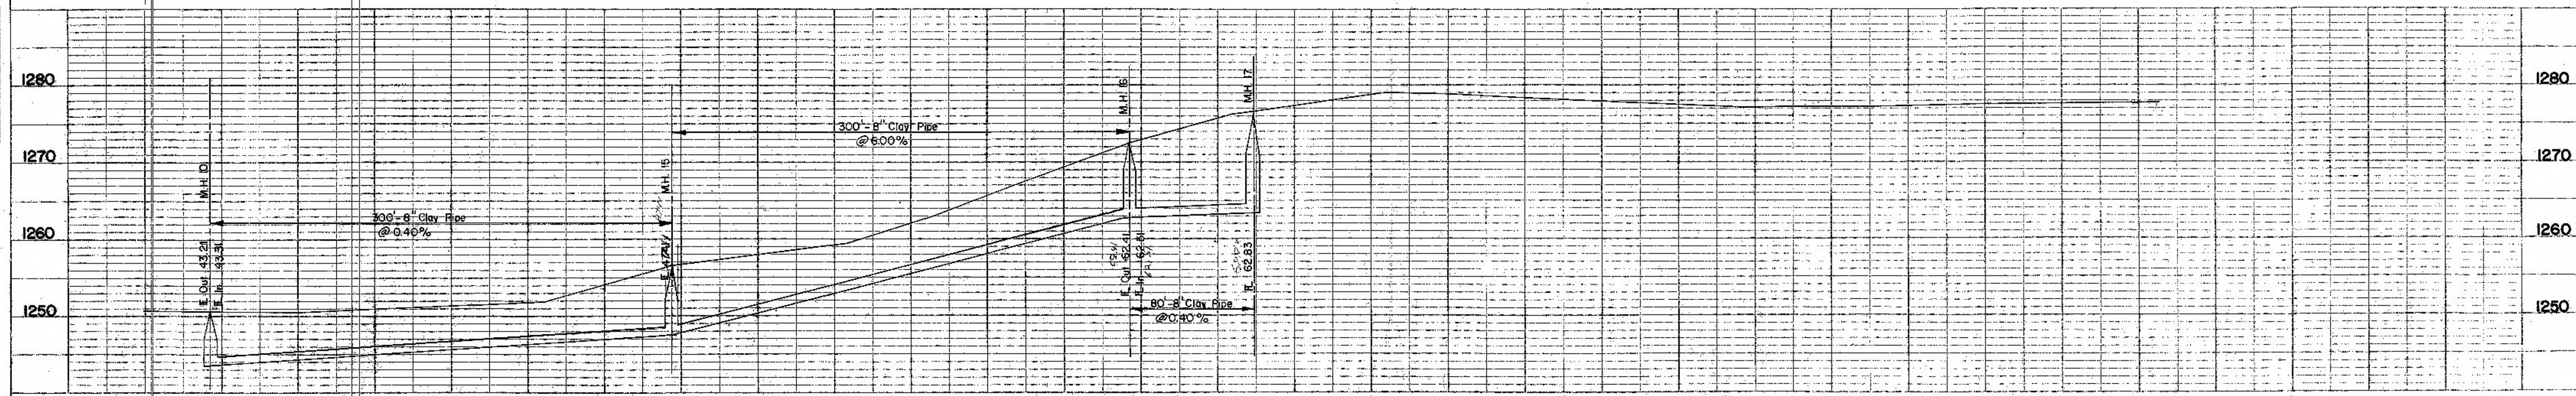
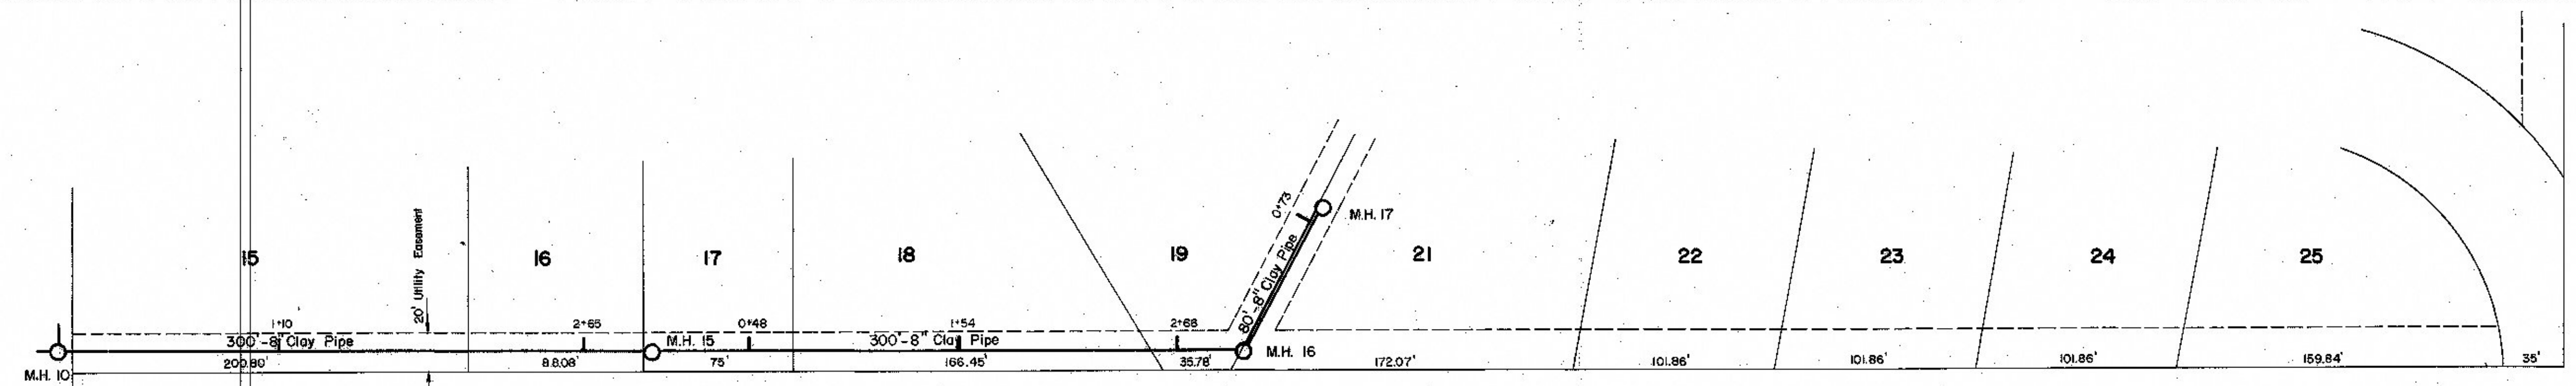


PLATE 2 - PLAN - PROFILE S. P. S. & M. F.  
 MADE AND PRINTED IN U.S.A.  
 CHARLES BRUNING COMPANY, INC.