


444

PLAN	SURVEYED	DATE
	PLOTTED	
	BY	
	NO. OF WAY CHECKS	
	NO.	

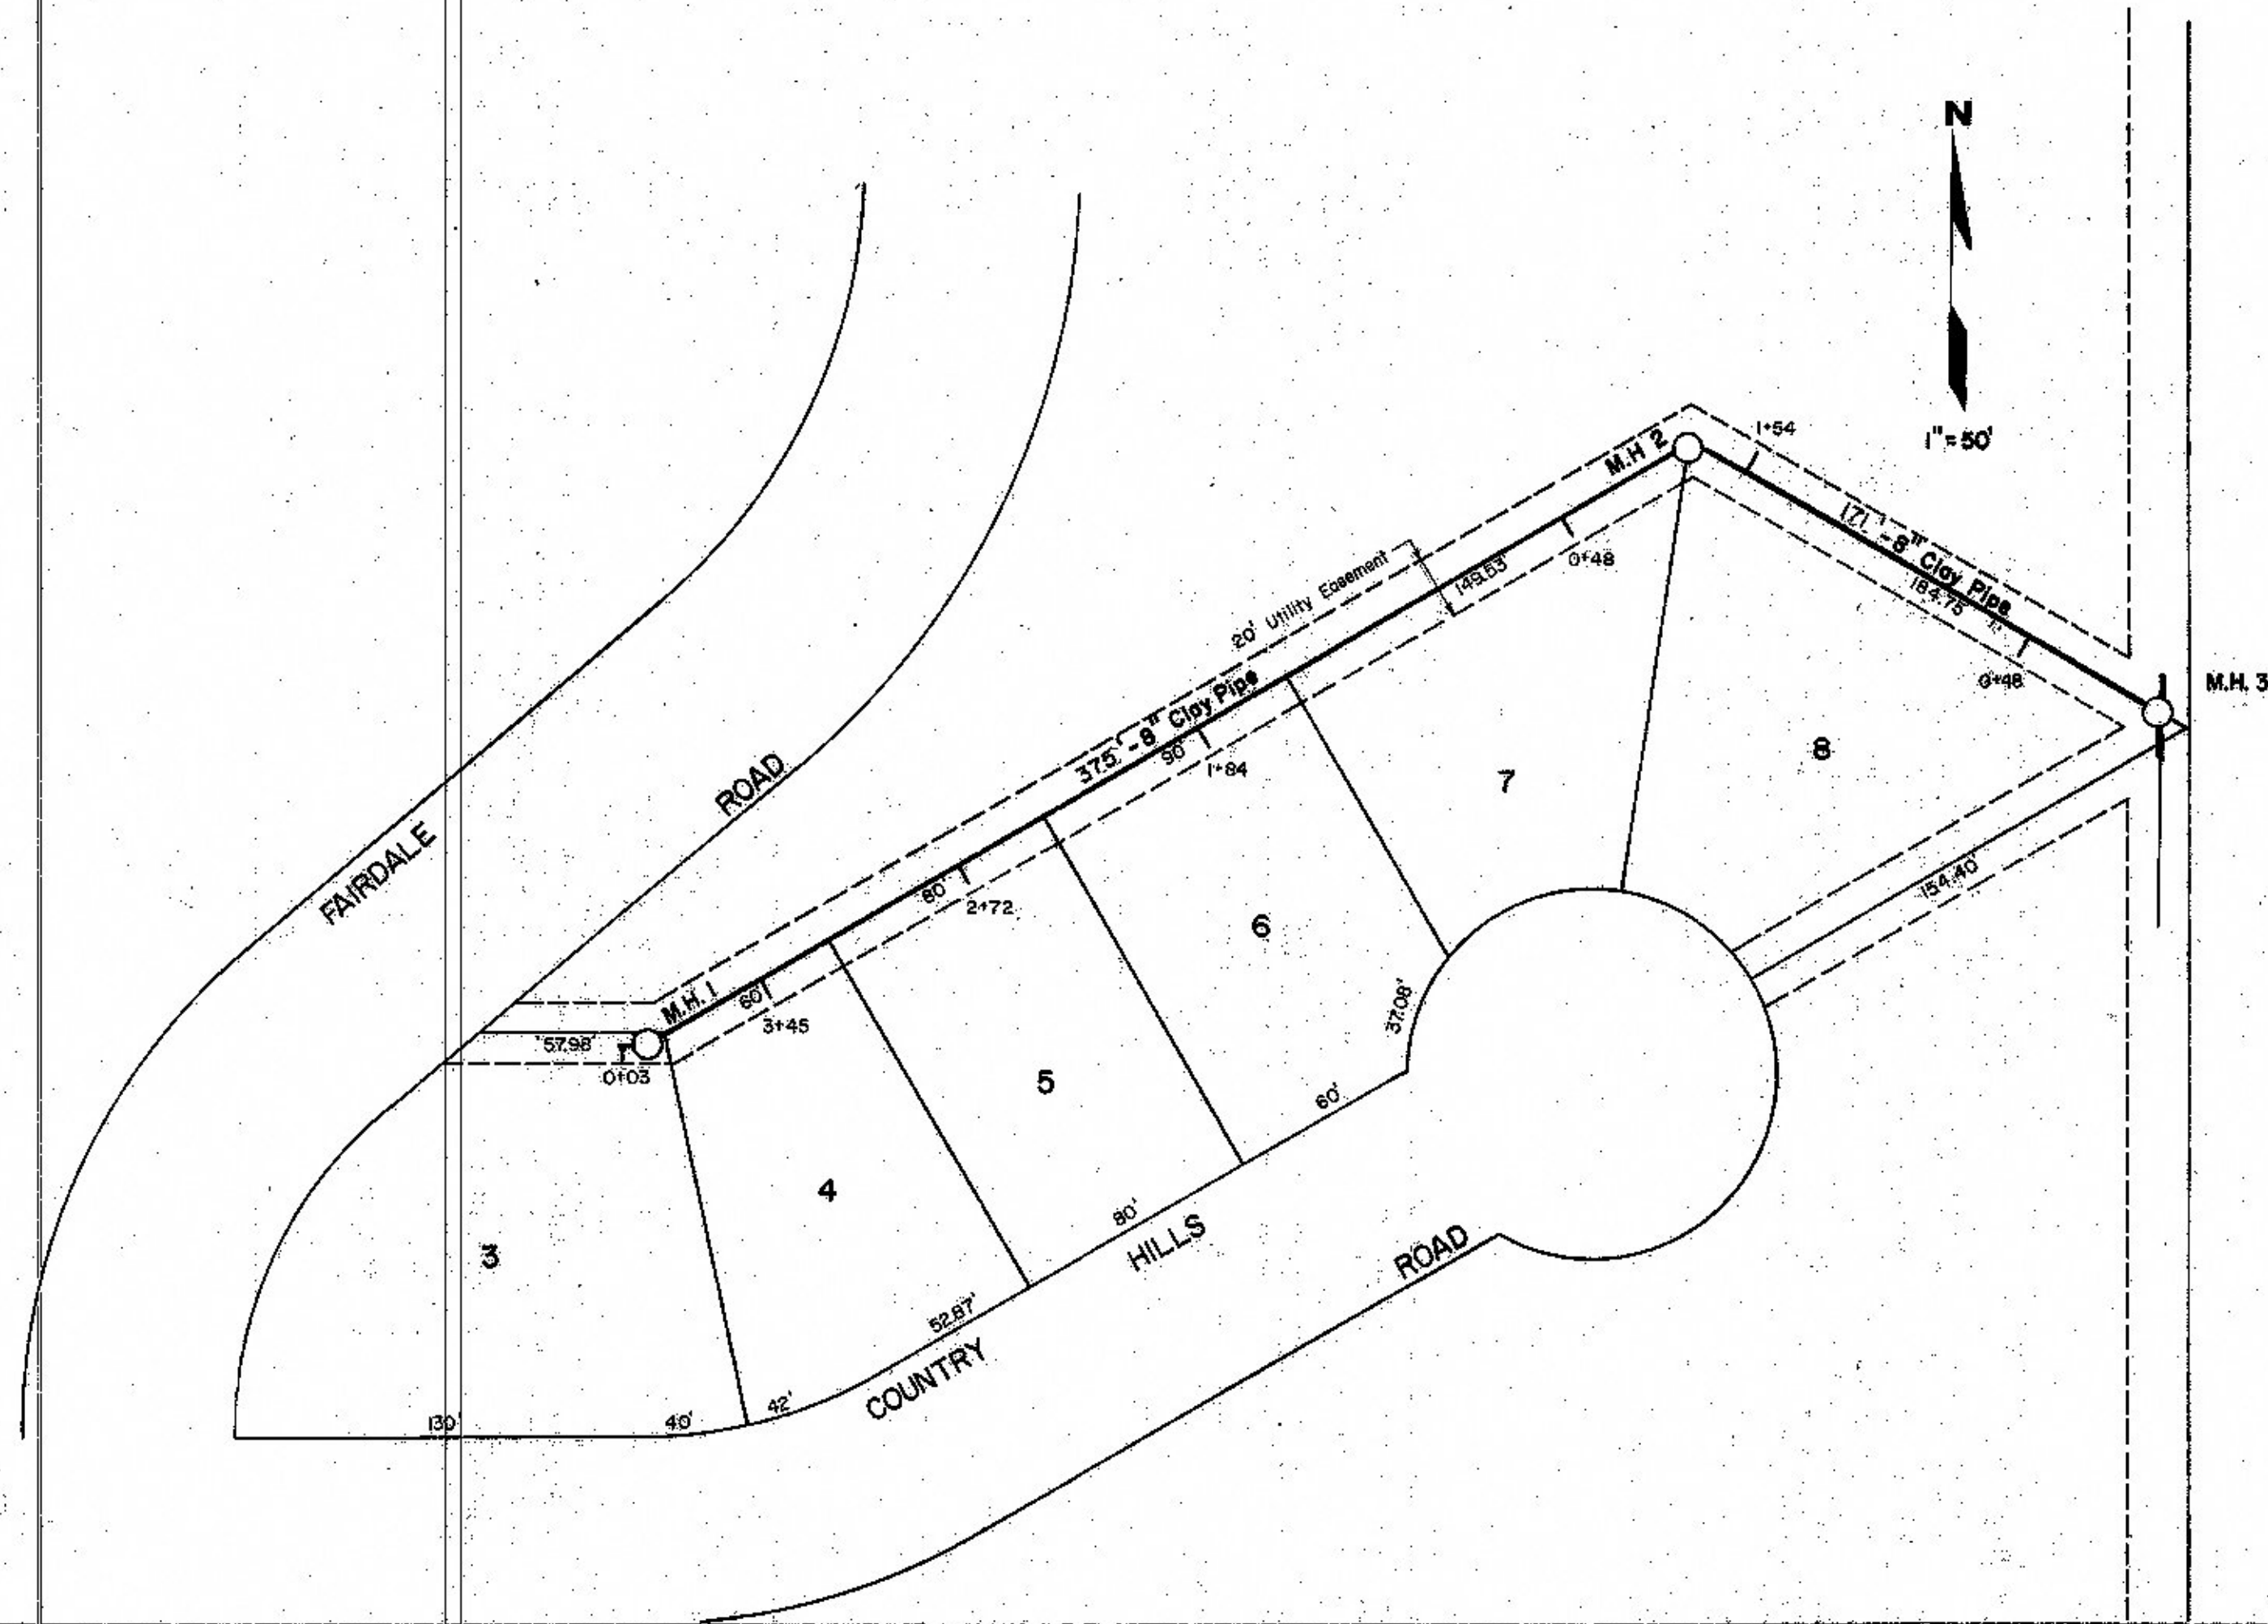

AS-BUILT PLANS  
 STEVENS CONTRACTORS INC.  
 PROJECT NO. 74-564  
 DATE: JULY 1974

PROFILE	SURVEYED	DATE
	GRADES CHECKED	
	BY	
	NO.	

