


PLAN	SURVEYED	BY	DATE
	PLOTTED		
	ALIGNED CHECKED		
	NO. OF WKS. OREGNO.		

PROFILE	SURVEYED	BY	DATE
	GRADES CHECKED		
	B. M. NOTED		
	STRUCTURE NOTATION CHECKED		

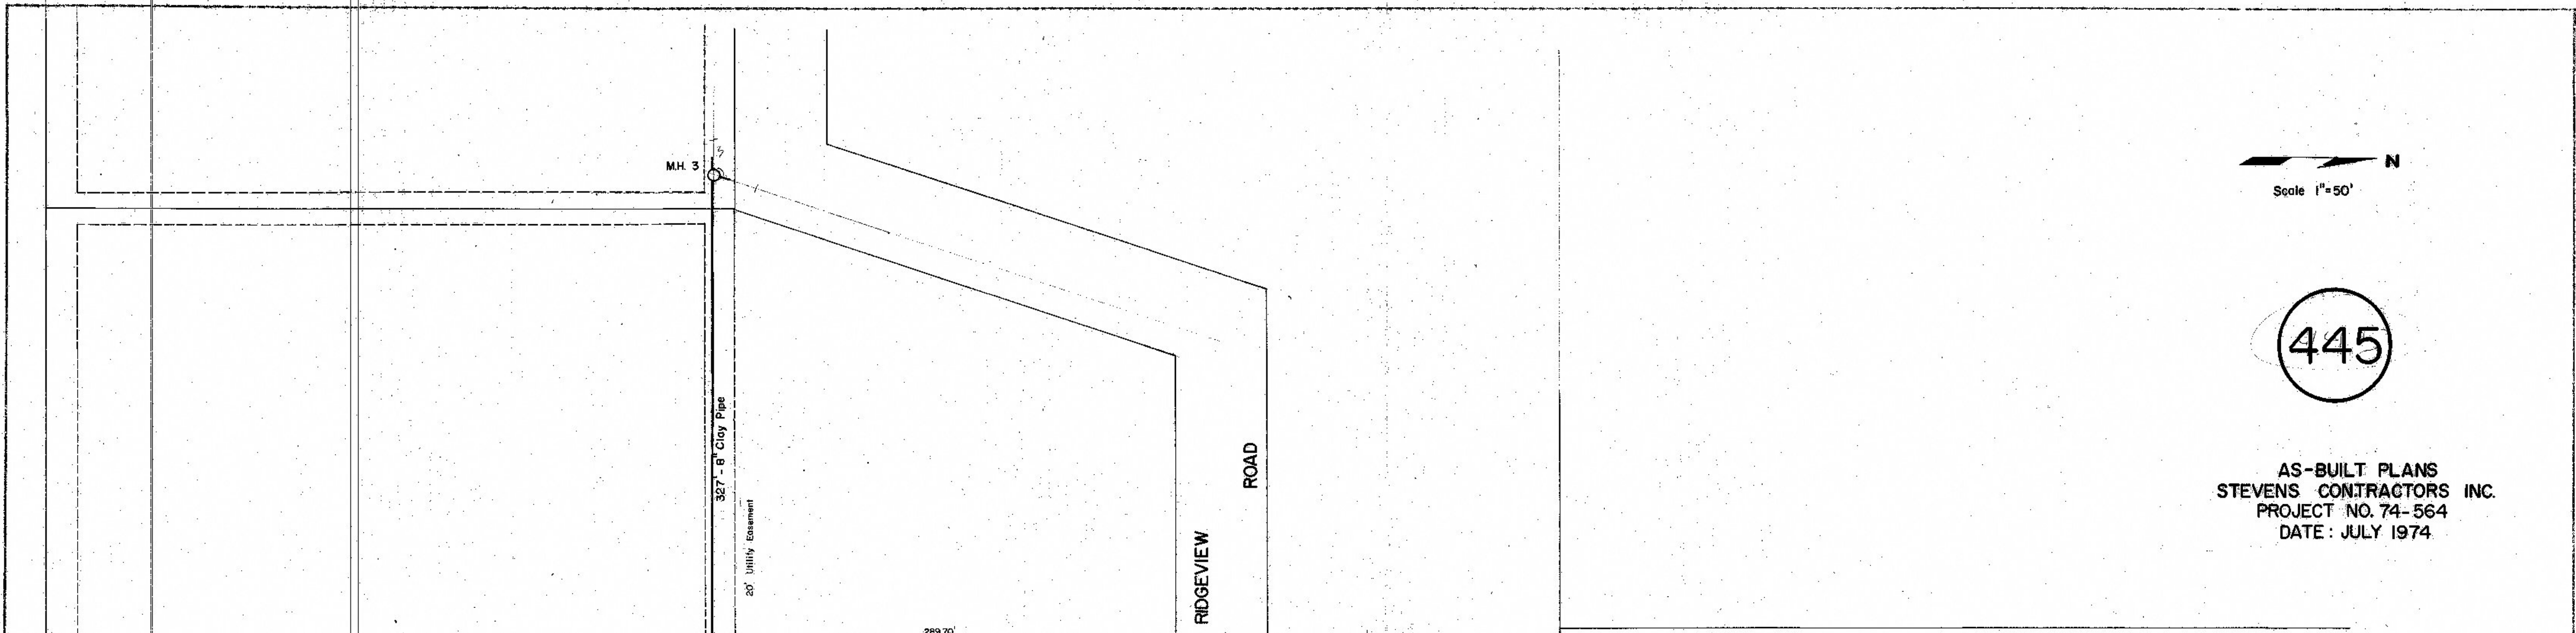

Scale 1"=50'

445

AS-BUILT PLANS
STEVENS CONTRACTORS INC.
PROJECT NO. 74-564
DATE: JULY 1974

