
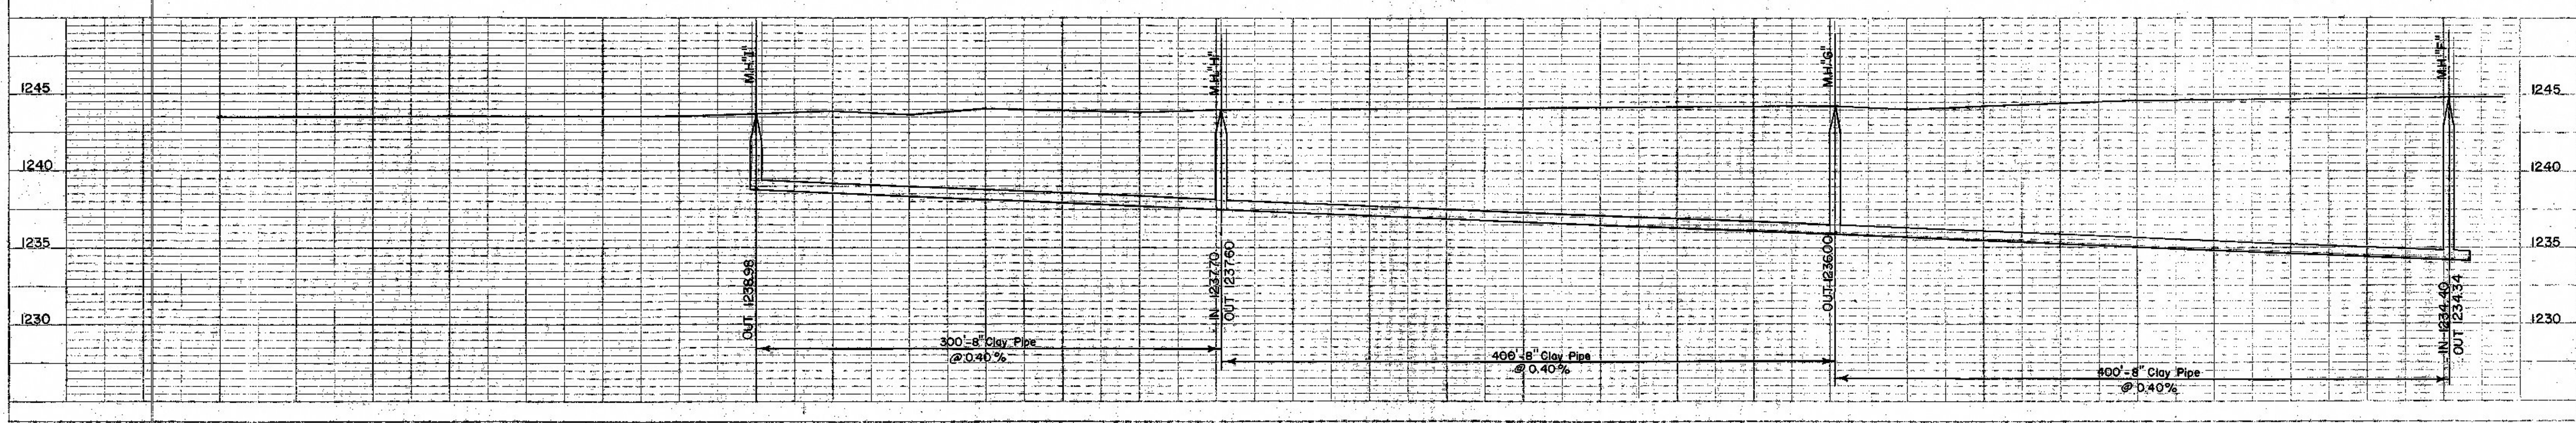
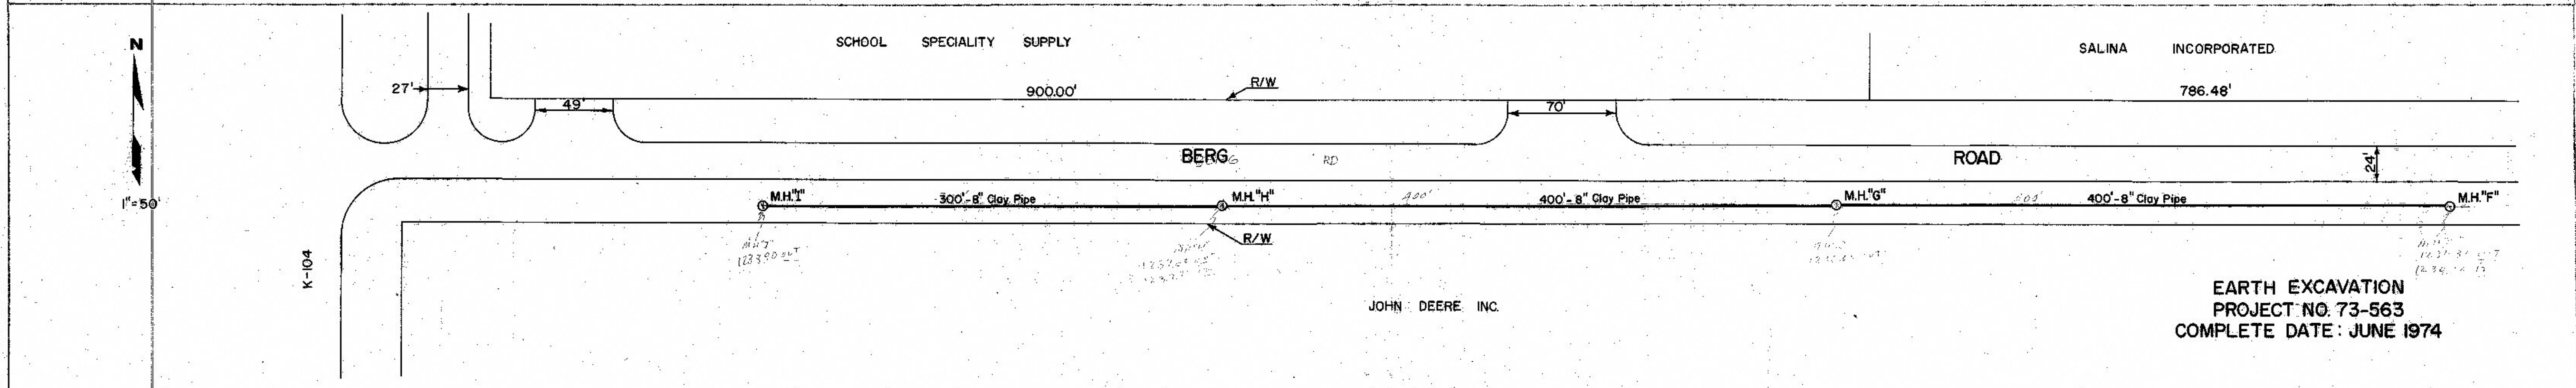
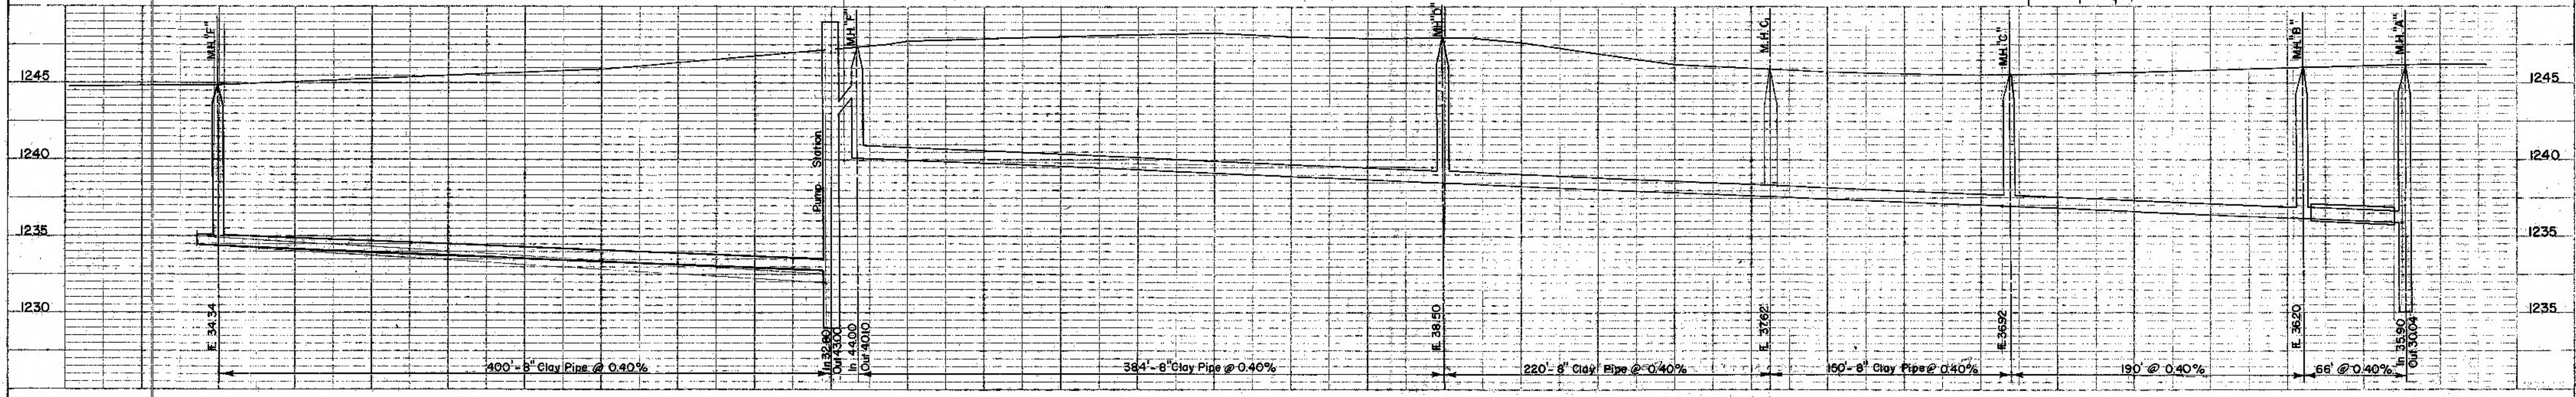


PLAN
 SURVEYED
 PLOTTED
 NOTE BOOK ALIGNED CHECKED
 RT. OF WAY CHECKED
 NO.

PROFILE
 SURVEYED
 NOTE BOOK GRADIES CHECKED
 B. MEASURED
 STRUCTURE PROFILES S.W. 70
 NO.

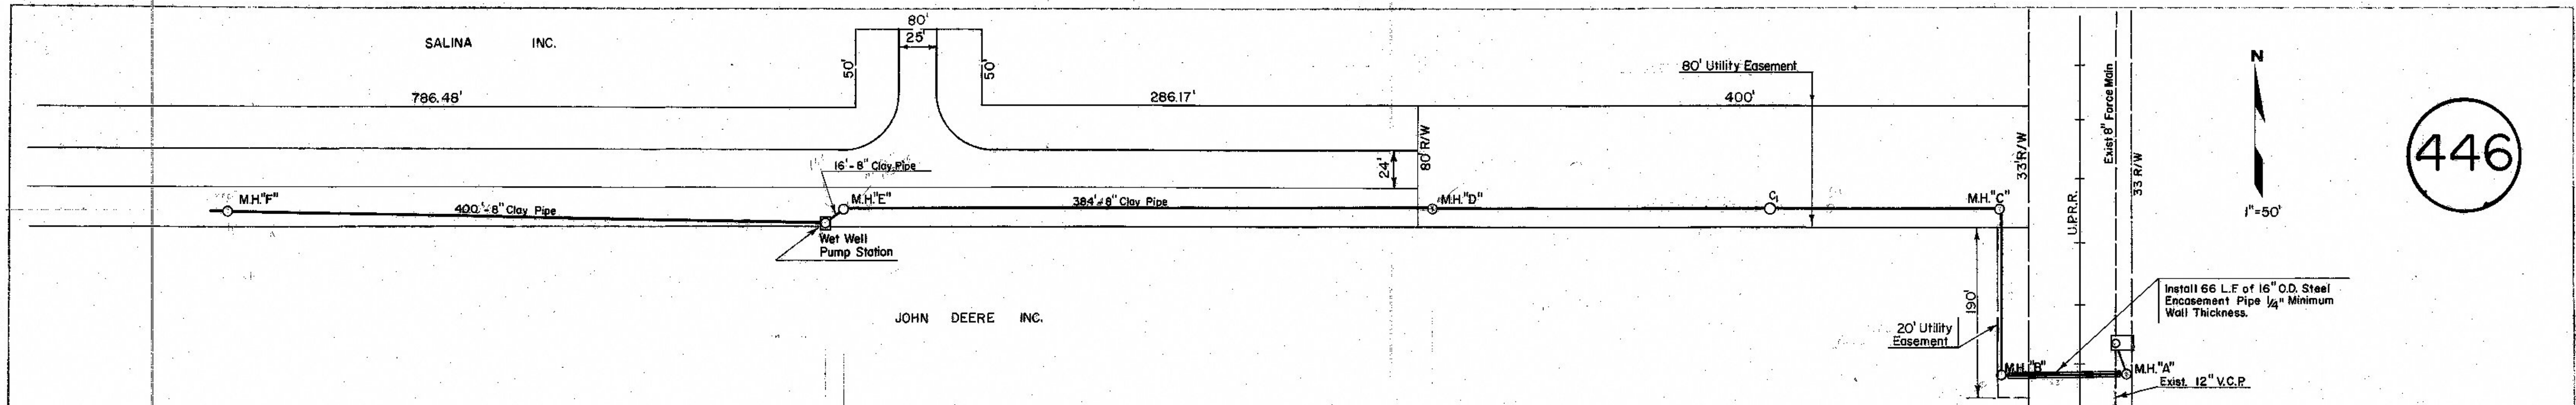

EARTH EXCAVATION
 PROJECT NO. 73-563
 COMPLETE DATE: JUNE 1974