


PLAN	SURVEYED	DATE
	PLOTTED	BY
	NOTE BOOK	NO.
	ALIGNMENT CHECKED	
	STRUCTURE NOTIFIED	
	RT. OF WAY CHECKED	

PROFILE	SURVEYED	DATE
	PLOTTED	BY
	NOTE BOOK	NO.
	ALIGNMENT CHECKED	
	STRUCTURE NOTIFIED	
	RT. OF WAY CHECKED	

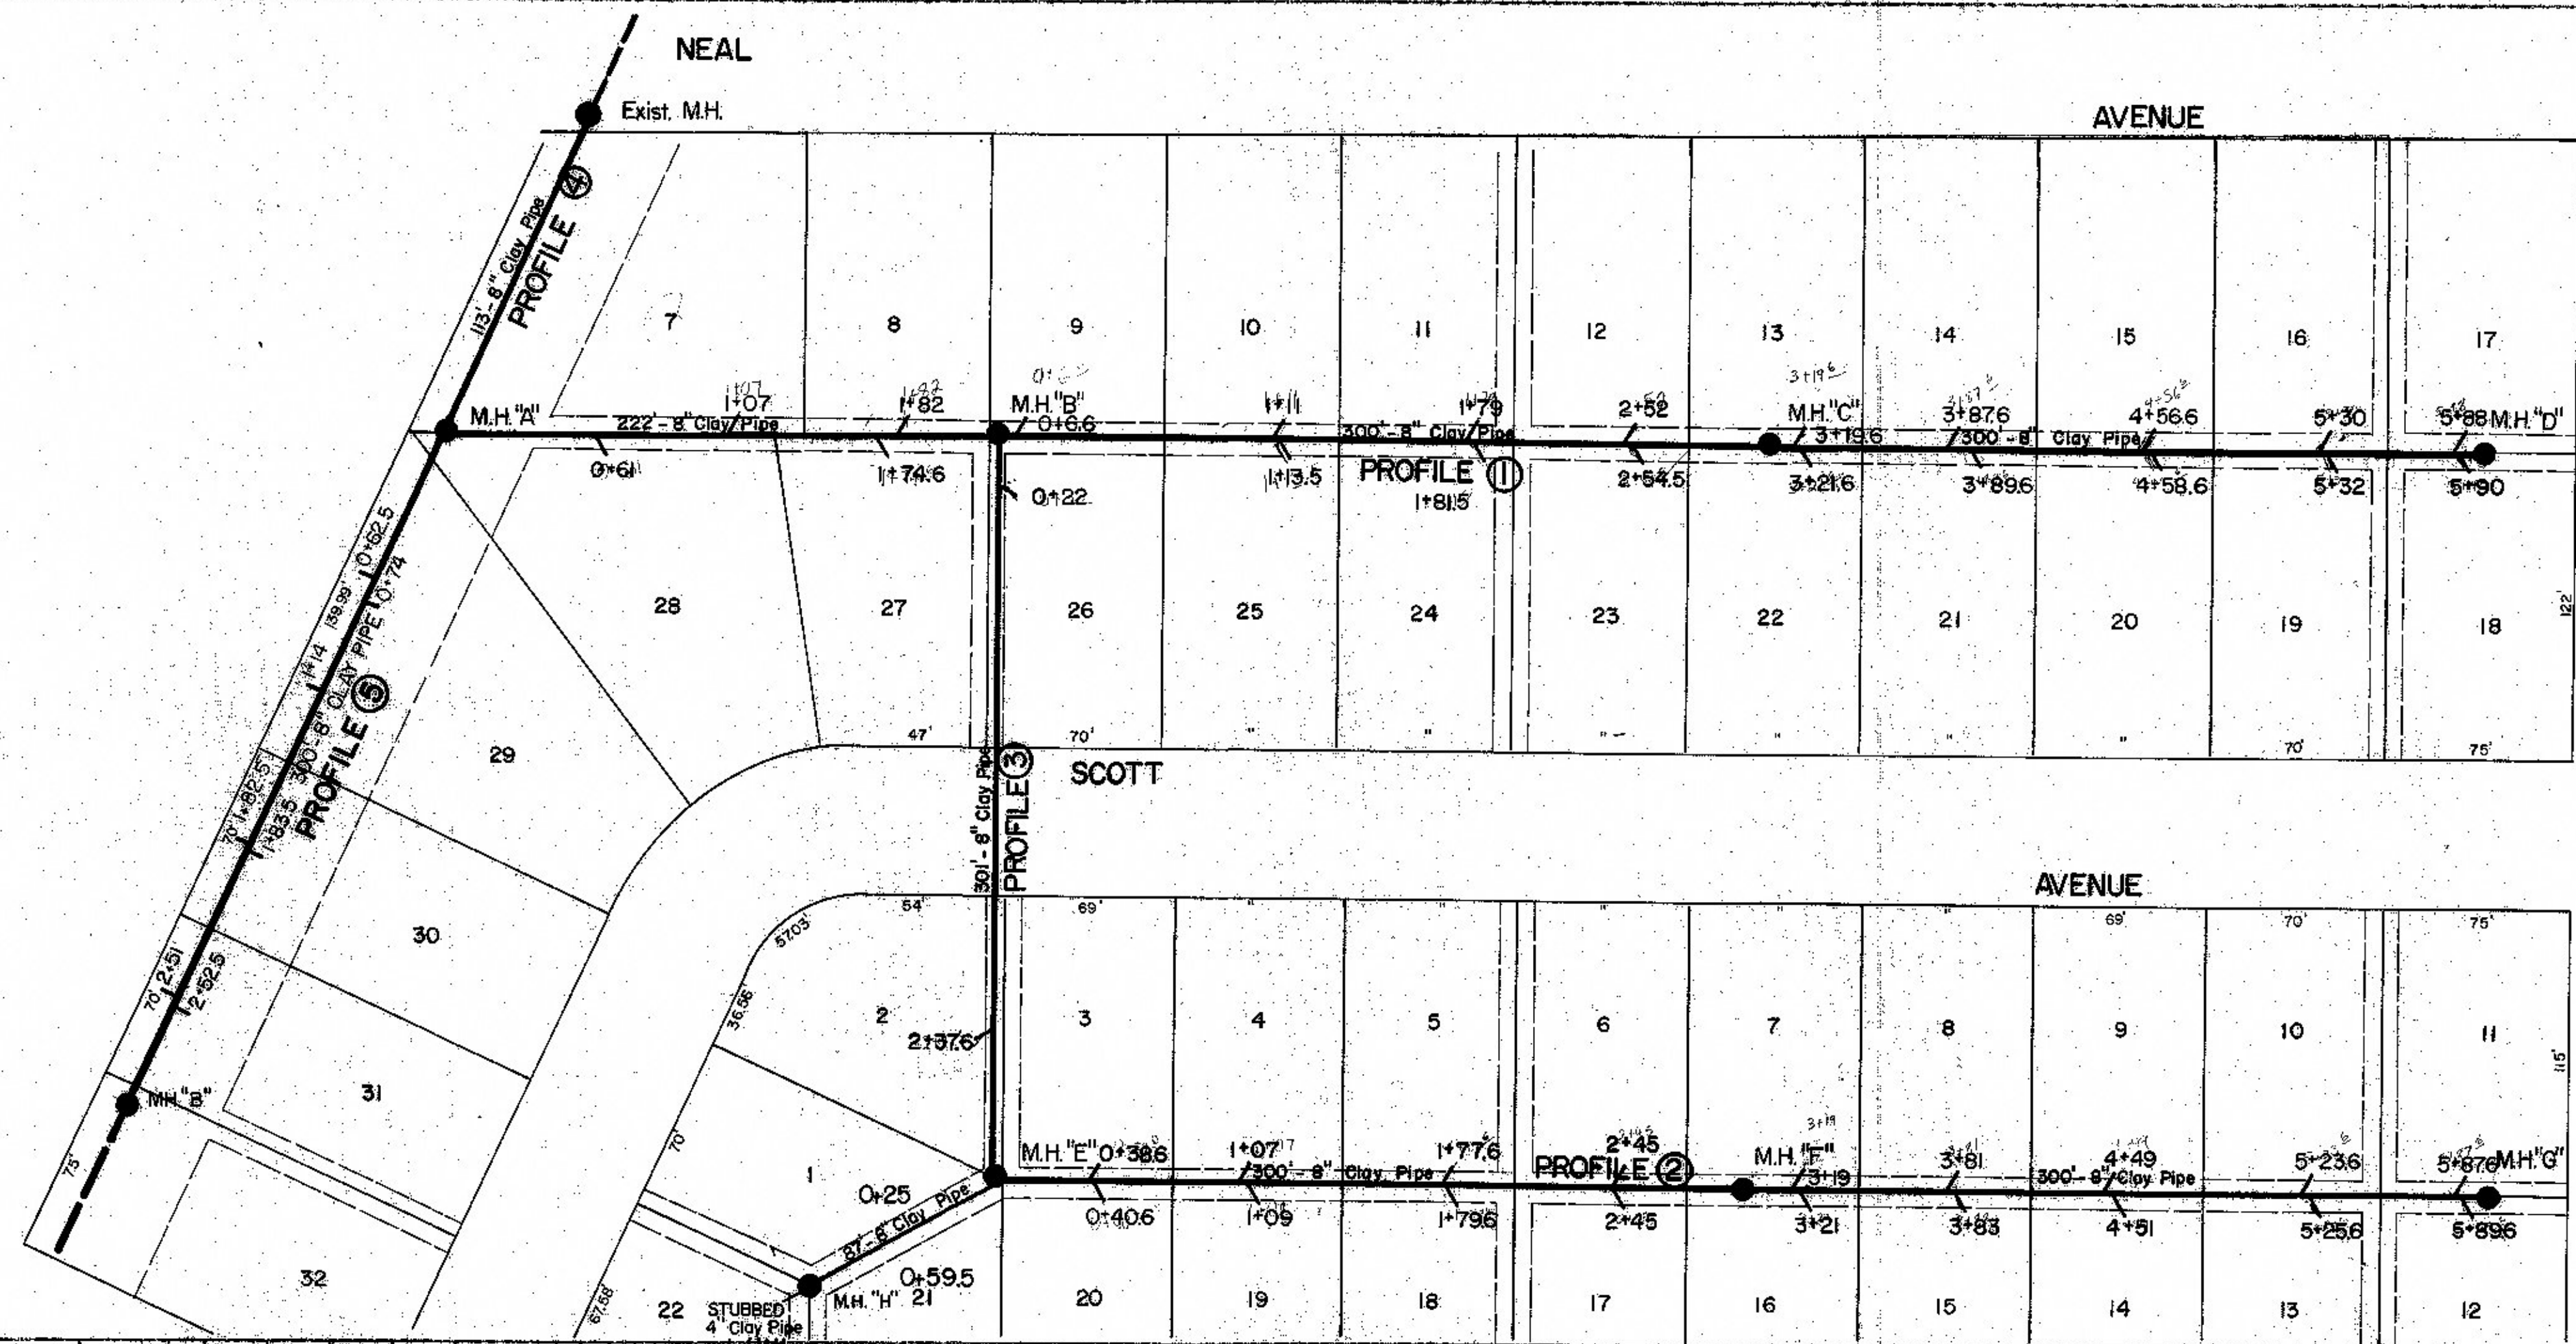

447

AS BUILT PLANS
SMOKY HILL INC.
NOV. 1974 APRIL 1976
74-531 75-586

