



**PLAN**  
 DATE: \_\_\_\_\_  
 SHEET NO.: \_\_\_\_\_  
 PROJECT NO.: \_\_\_\_\_  
 DRAWN BY: \_\_\_\_\_  
 CHECKED BY: \_\_\_\_\_

**PROFILE**  
 DATE: \_\_\_\_\_  
 SHEET NO.: \_\_\_\_\_  
 PROJECT NO.: \_\_\_\_\_  
 DRAWN BY: \_\_\_\_\_  
 CHECKED BY: \_\_\_\_\_

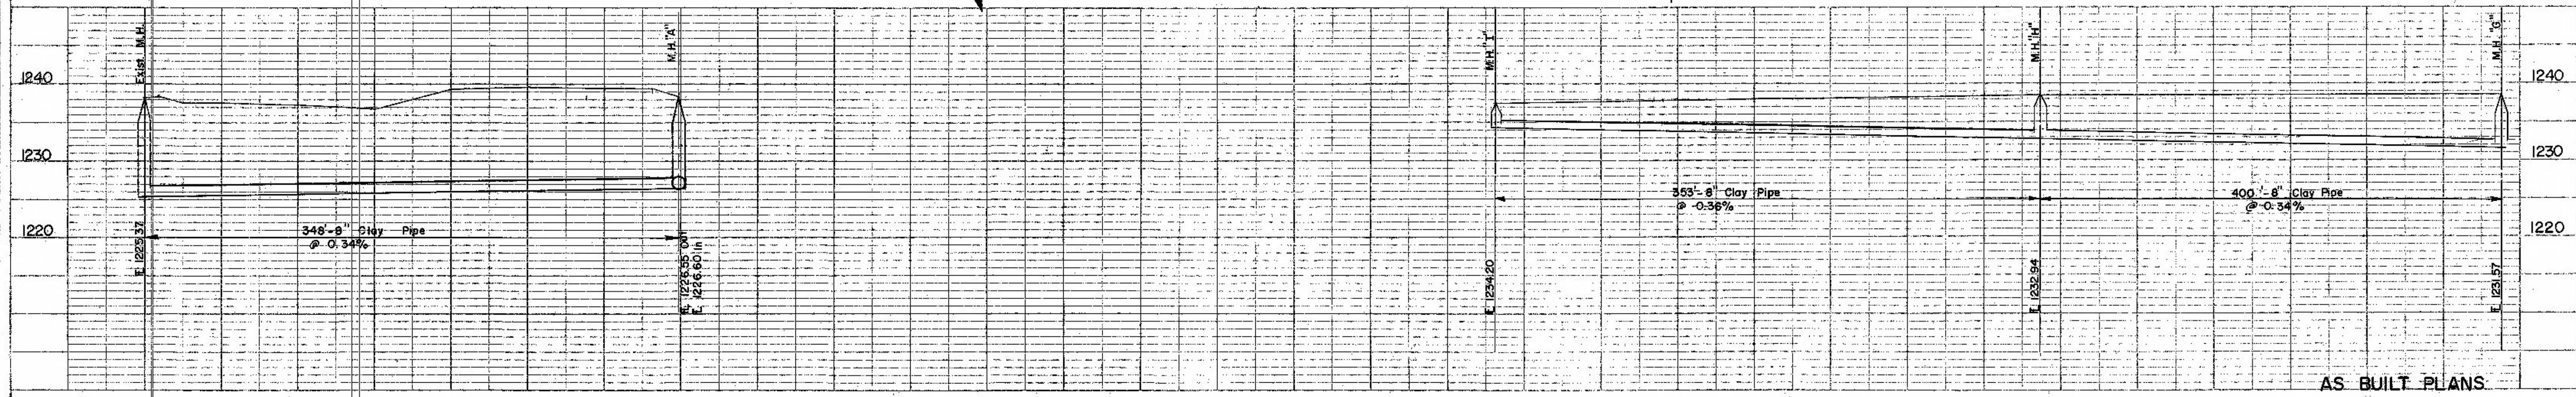

AS-BUILT PLANS  
 STEVENS CONST. COMP.  
 DECEMBER, 1974  
 PROJECT NO. 74-576

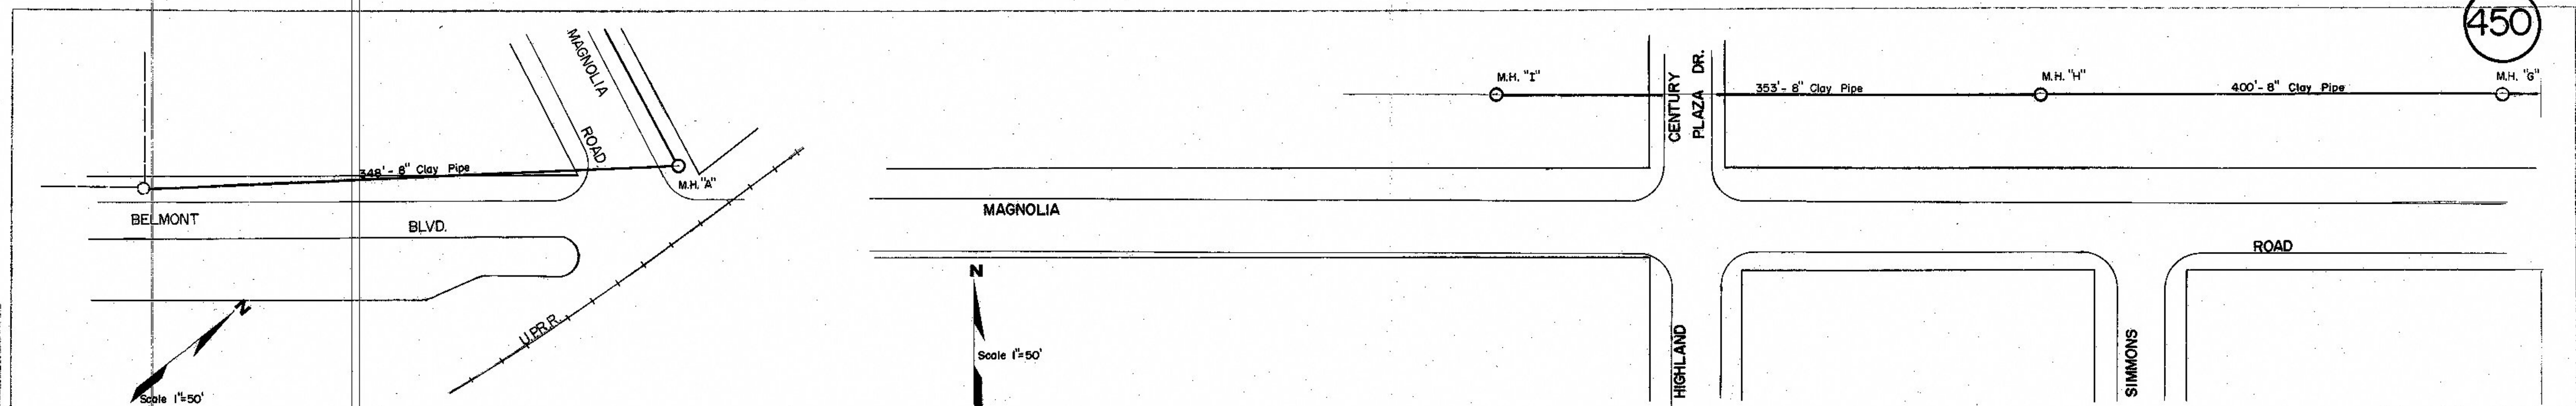