


PLAN  
 SURVEYED BY \_\_\_\_\_ DATE \_\_\_\_\_  
 PLOTTED BY \_\_\_\_\_  
 NOTE BOOK NO. \_\_\_\_\_  
 RT. OF WAY CHECKED BY \_\_\_\_\_

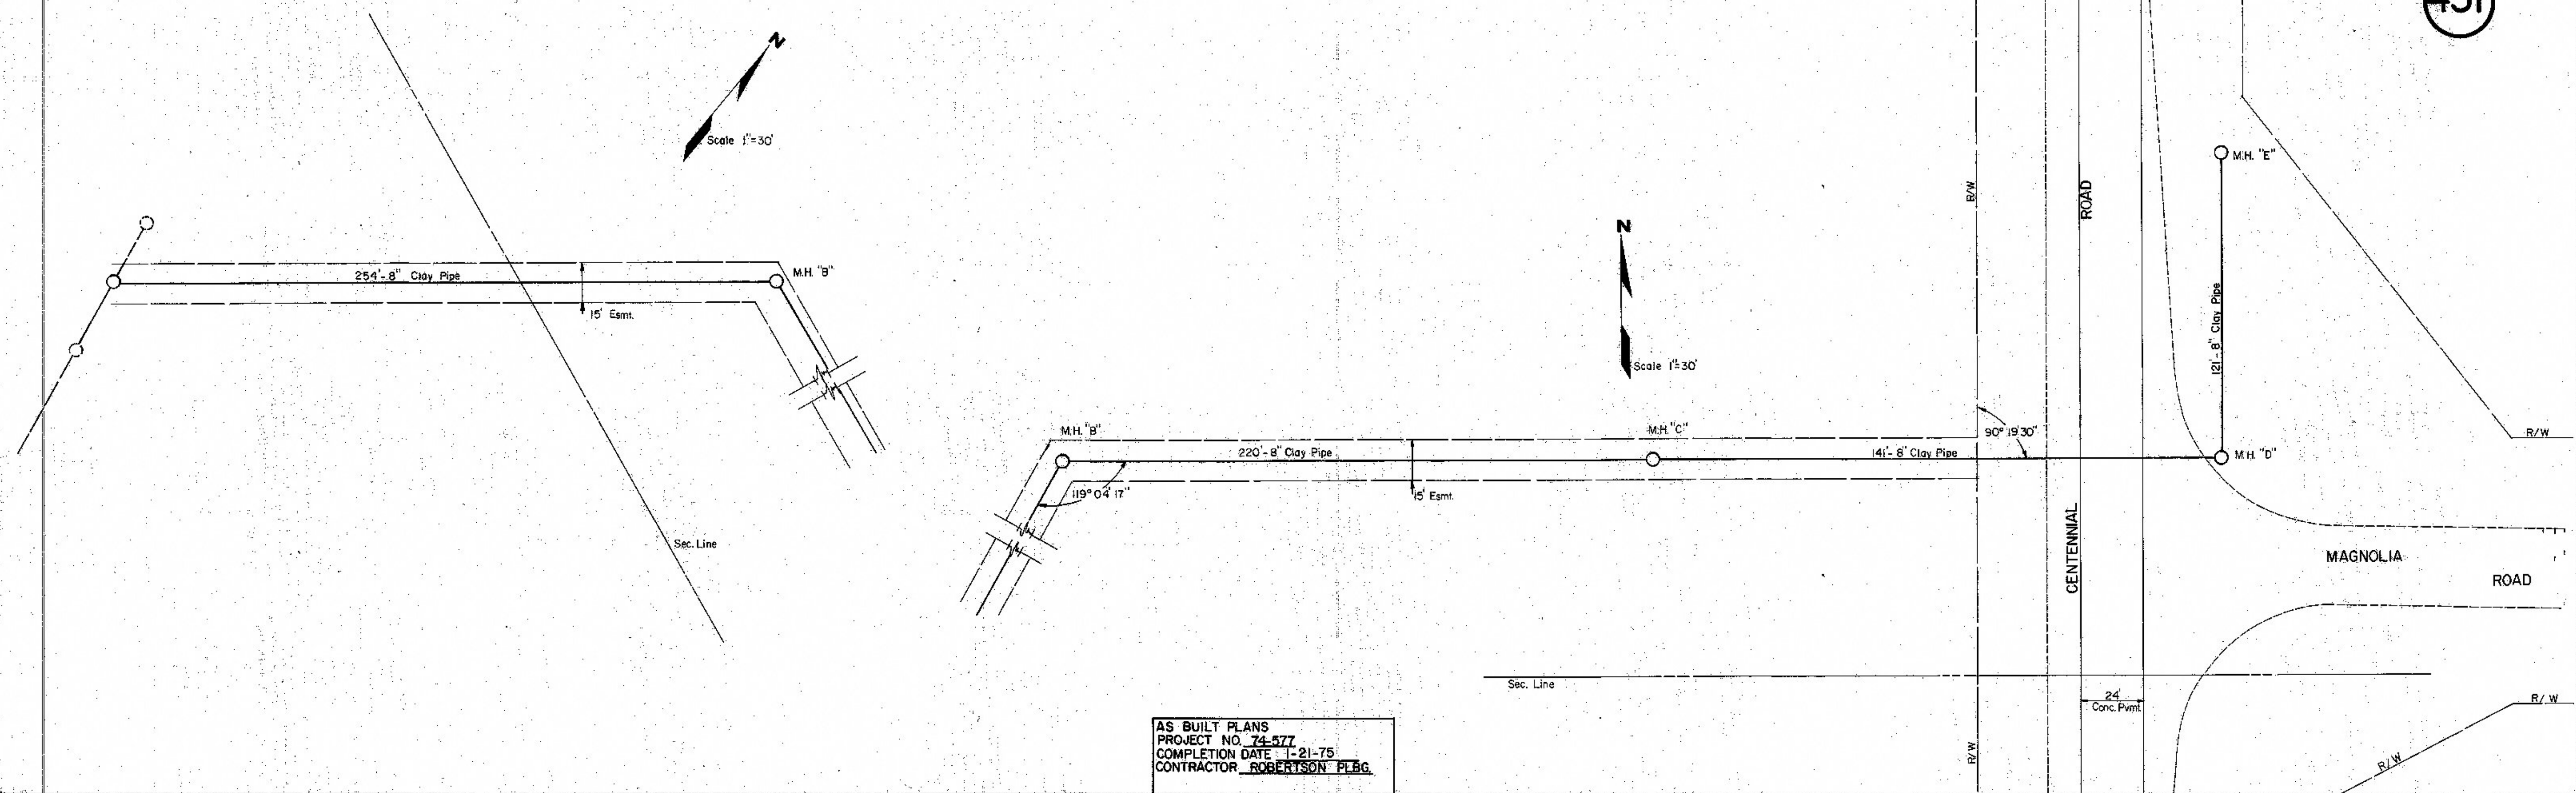

AS BUILT PLANS  
 PROJECT NO. 74-577  
 COMPLETION DATE 1-21-75  
 CONTRACTOR ROBERTSON P.L.C.

PROFILE  
 SURVEYED BY \_\_\_\_\_ DATE \_\_\_\_\_  
 PLOTTED BY \_\_\_\_\_  
 NOTE BOOK NO. \_\_\_\_\_  
 GRADES CHECKED BY \_\_\_\_\_  
 S. M. NOTED BY \_\_\_\_\_  
 STRUCTURE NOTATION CHECKED BY \_\_\_\_\_

