



PLAN
 SURVEYED BY DATE
 PLOTTED BY
 NOTE BOOK NO.
 REVISIONS
 DATE
 BY
 DESCRIPTION

PROFILE
 SURVEYED BY DATE
 PLOTTED BY
 NOTE BOOK NO.
 REVISIONS
 DATE
 BY
 DESCRIPTION

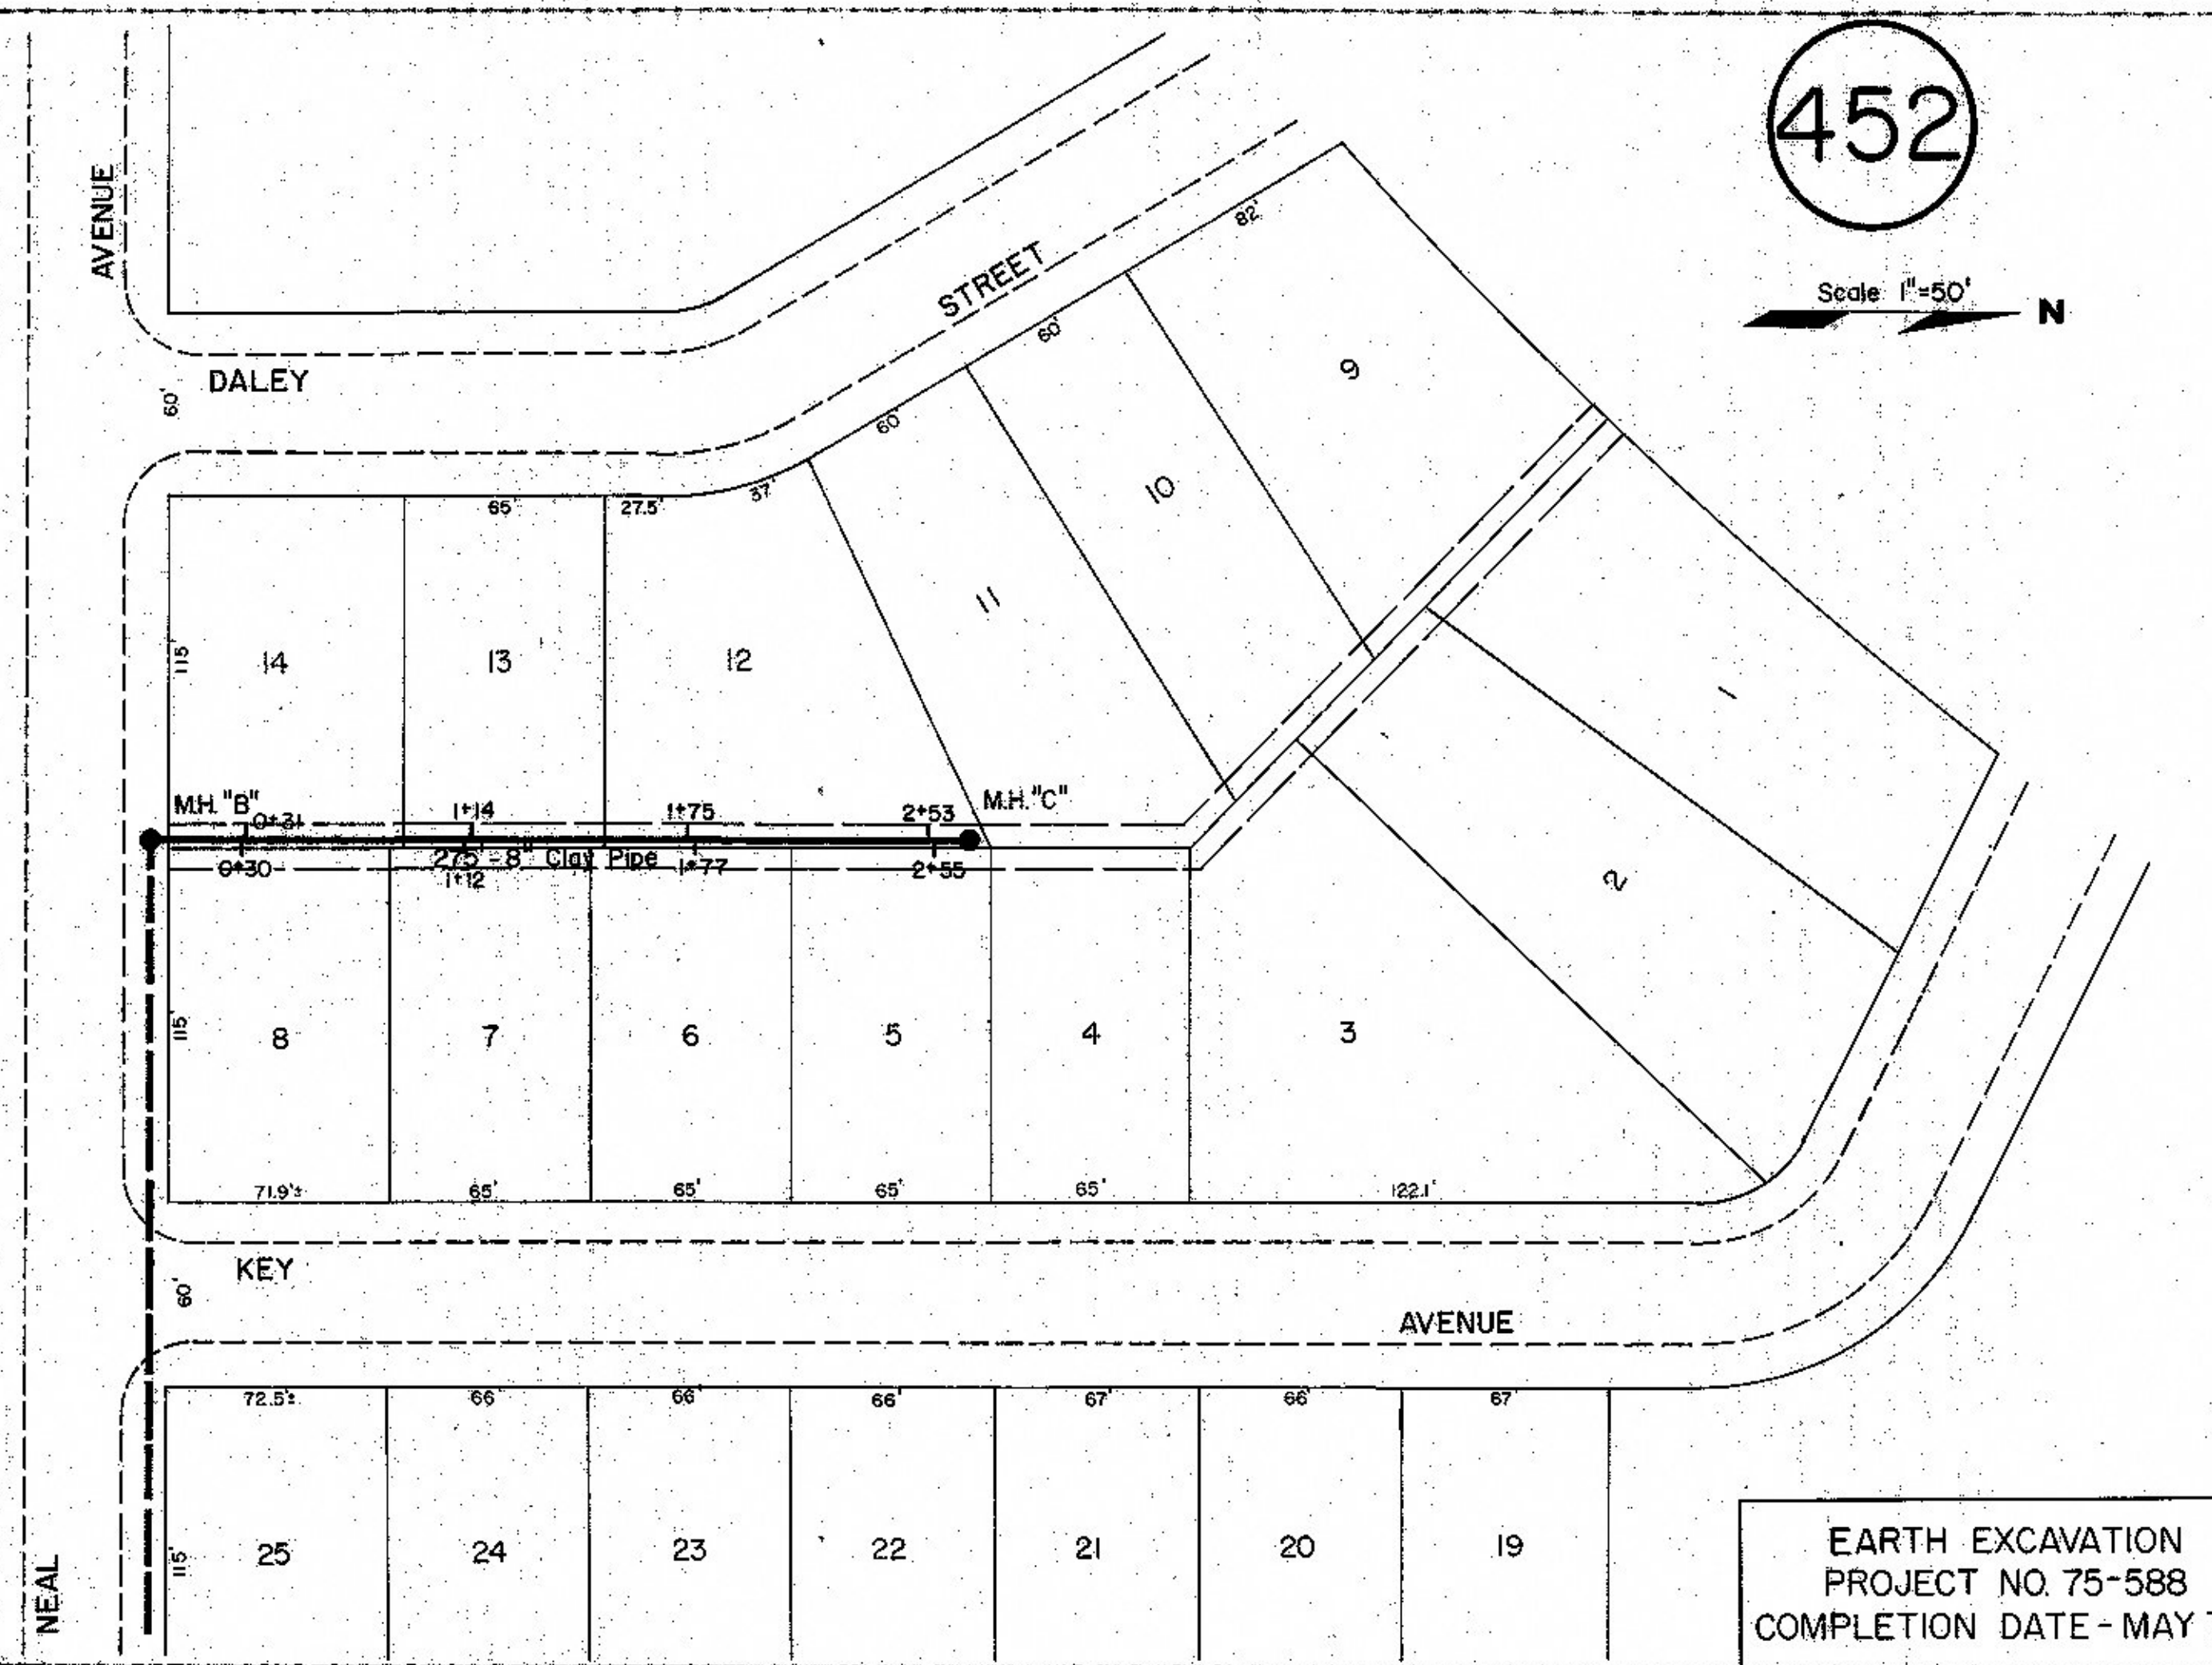

EARTH EXCAVATION
 PROJECT NO. 75-588
 COMPLETION DATE - MAY 75

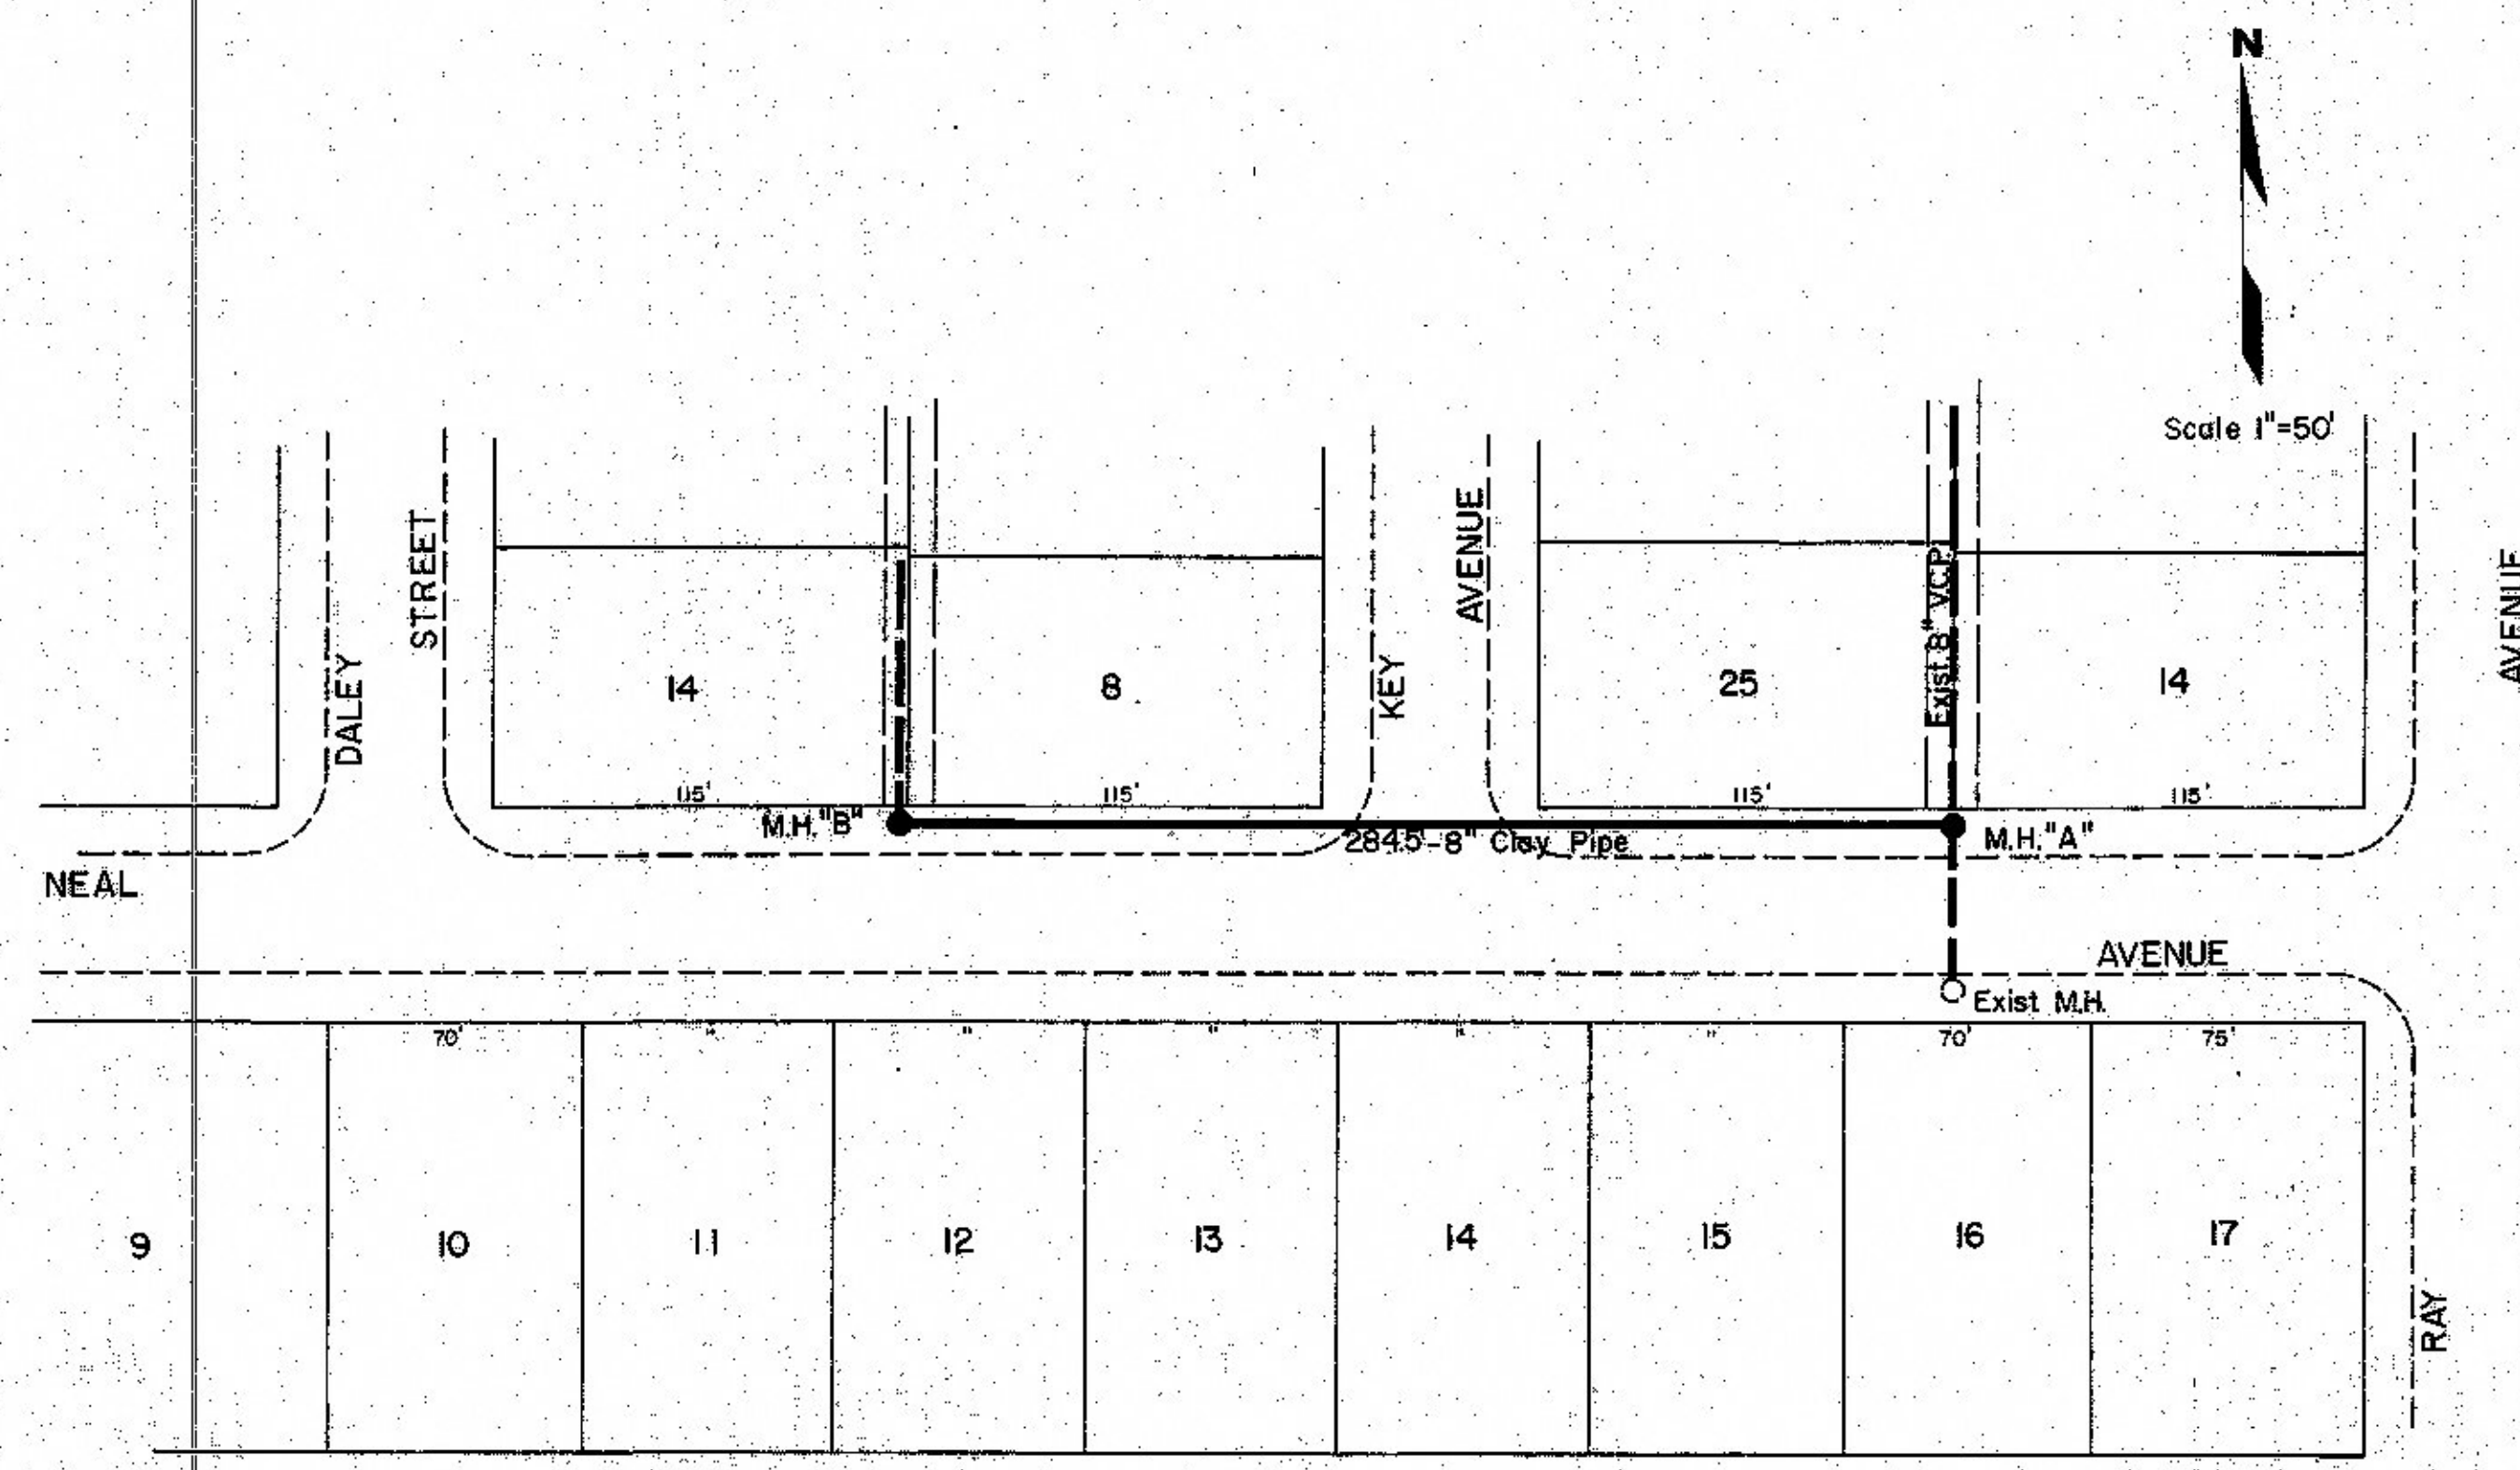