


455

AS-BUILT PLANS
STEVENS CONST. COMP
DECEMBER, 1974
PROJECT NO. 74-576

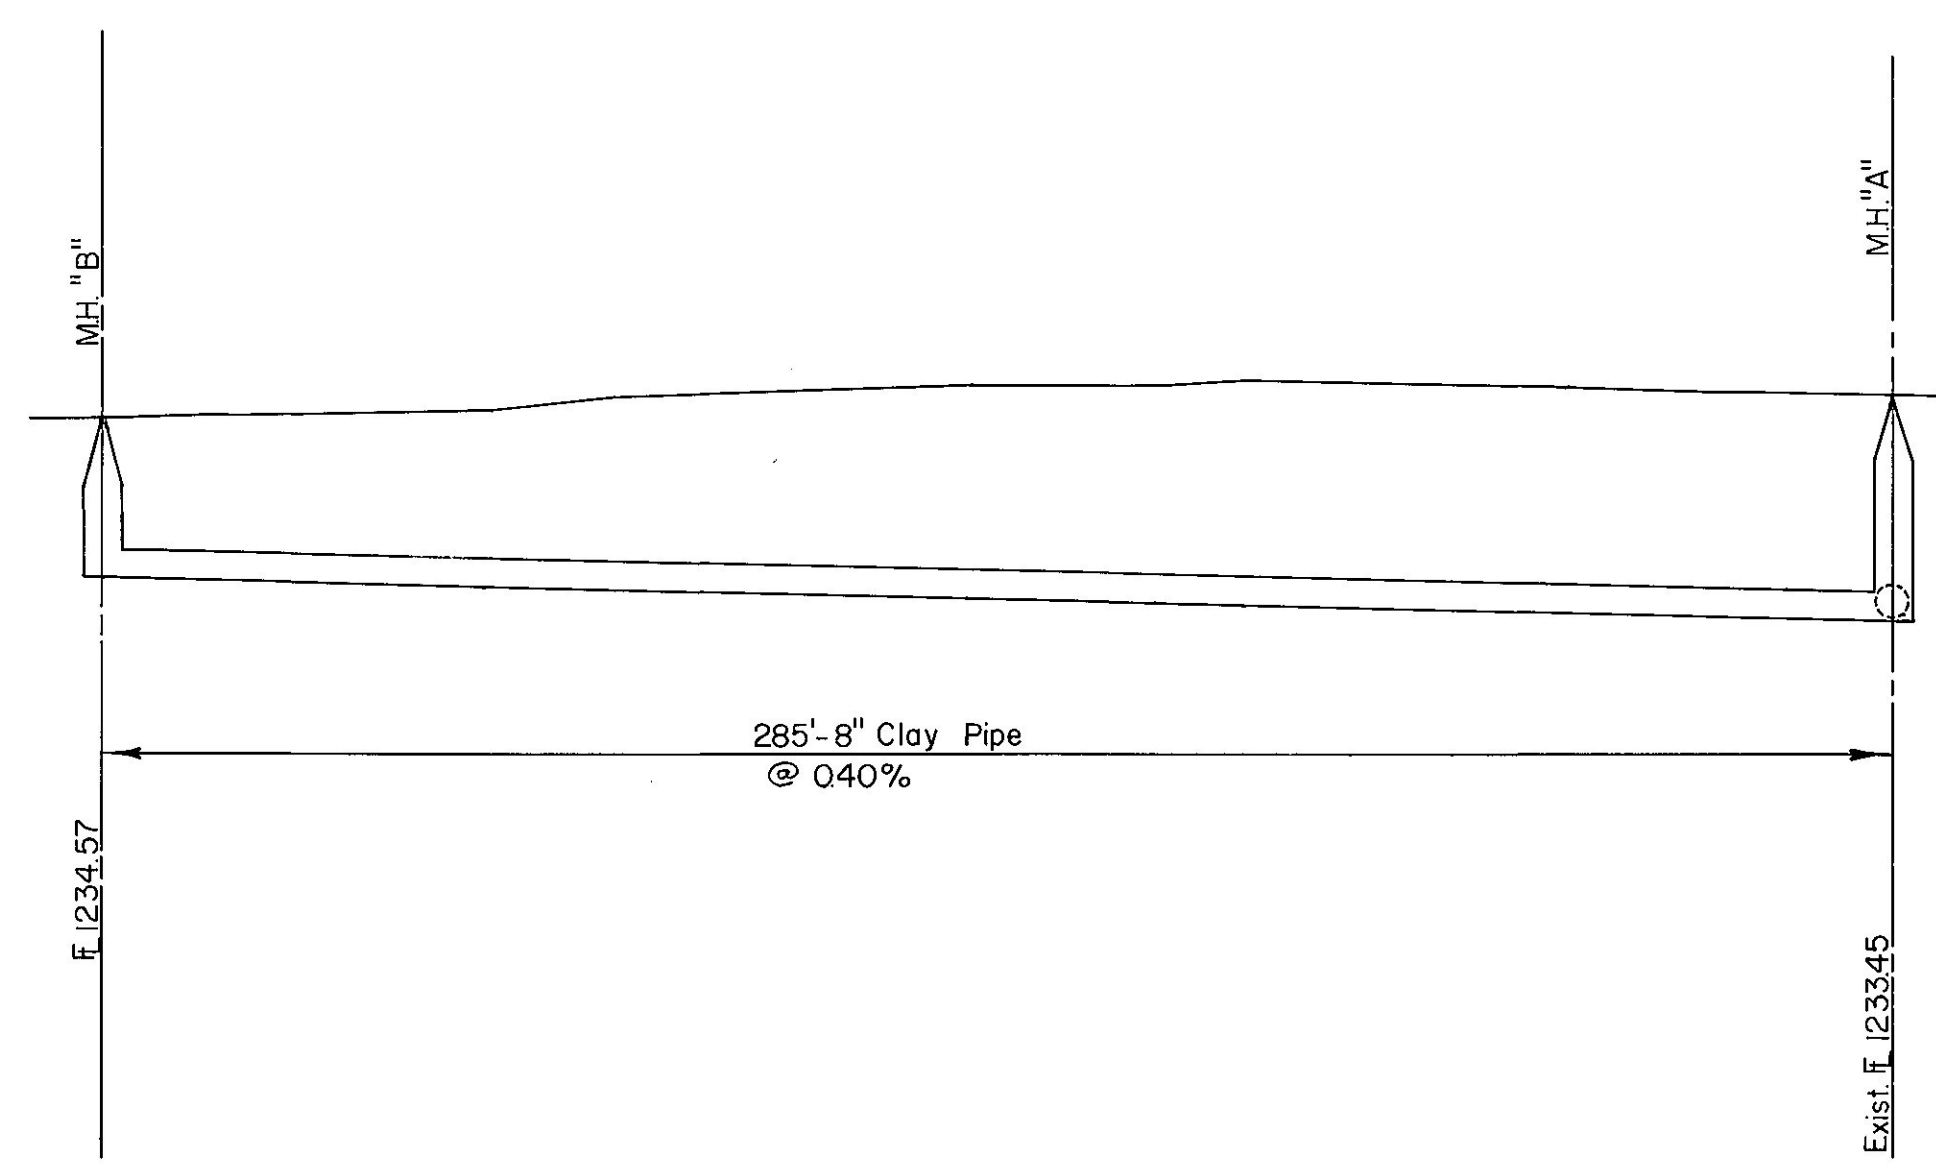

1240

1235

1230