



MARYMOUNT ROAD




Scale 1"=50' N

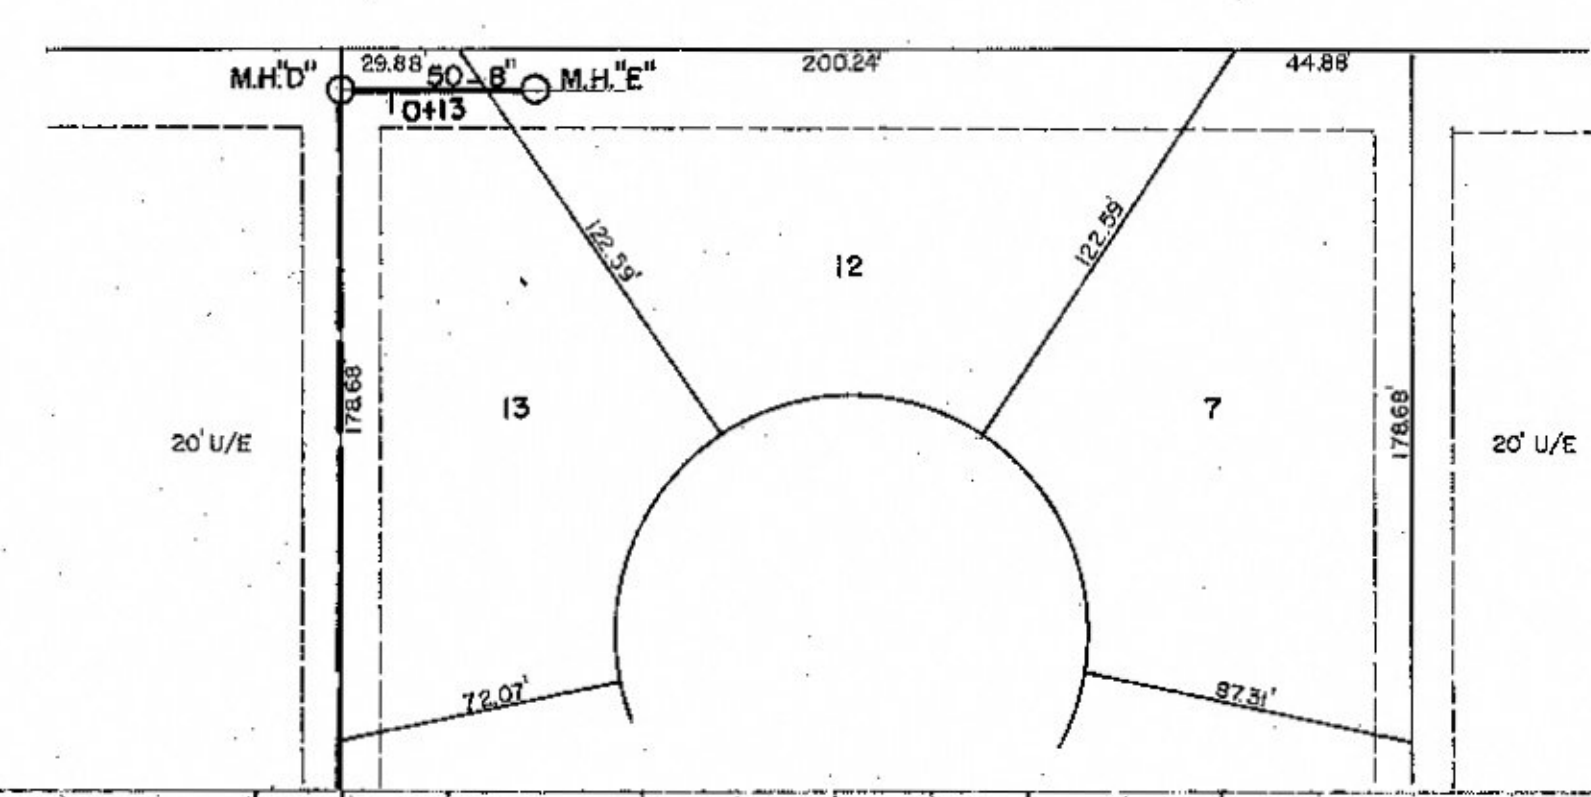

GLEN AVENUE

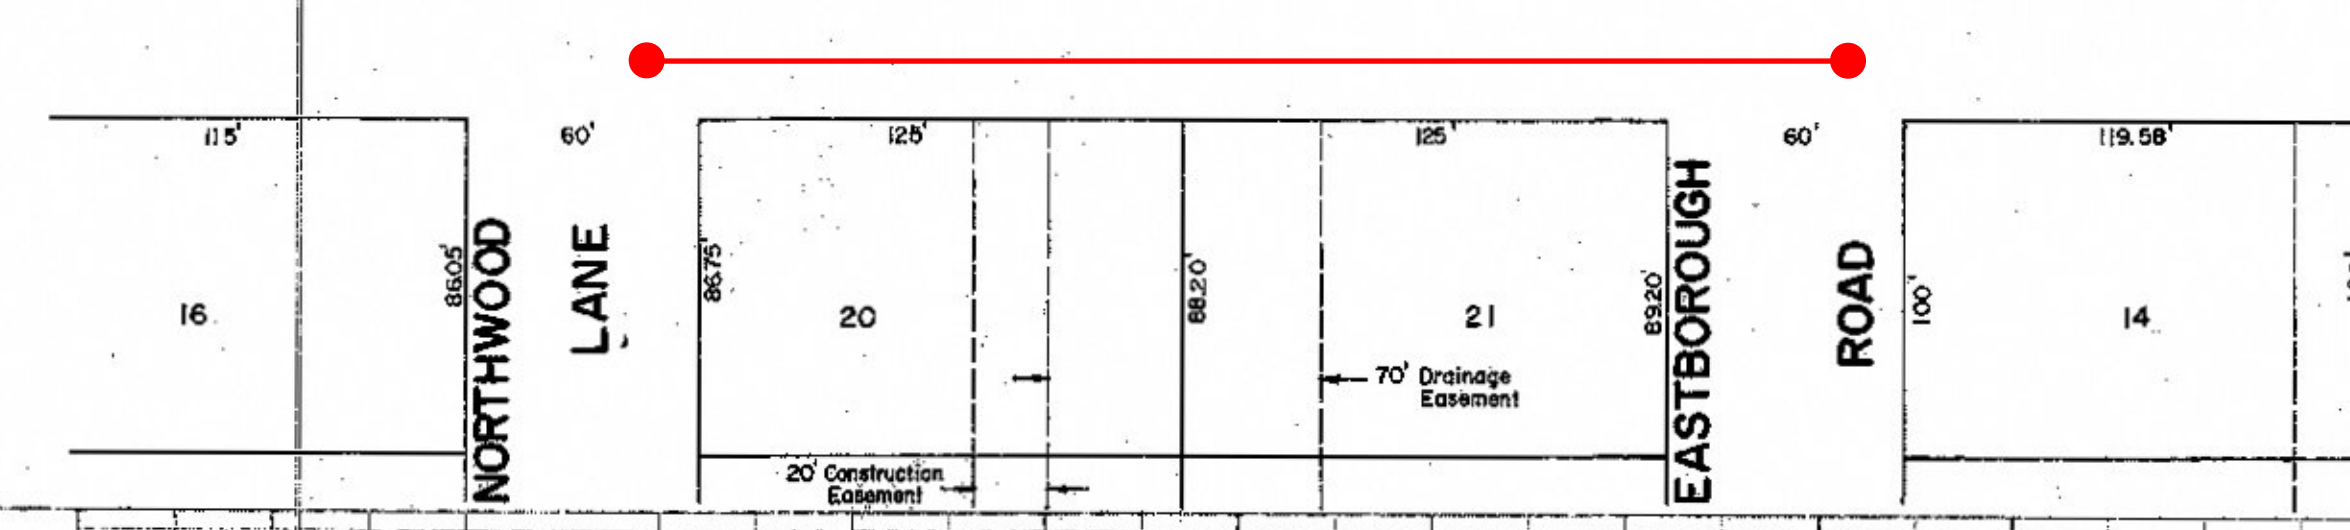


See project #75-590 (Laserfiche page 42)

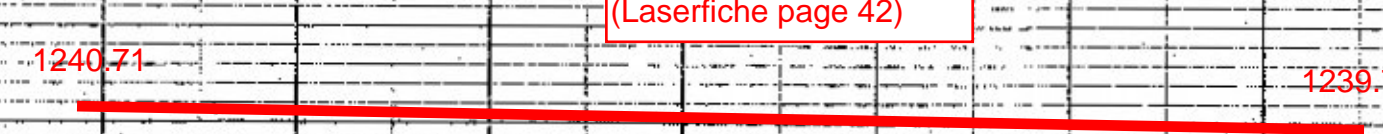



PLAN
 DIVISION
 DATE
 NO.

DATE
 NO.

DATE
 NO.

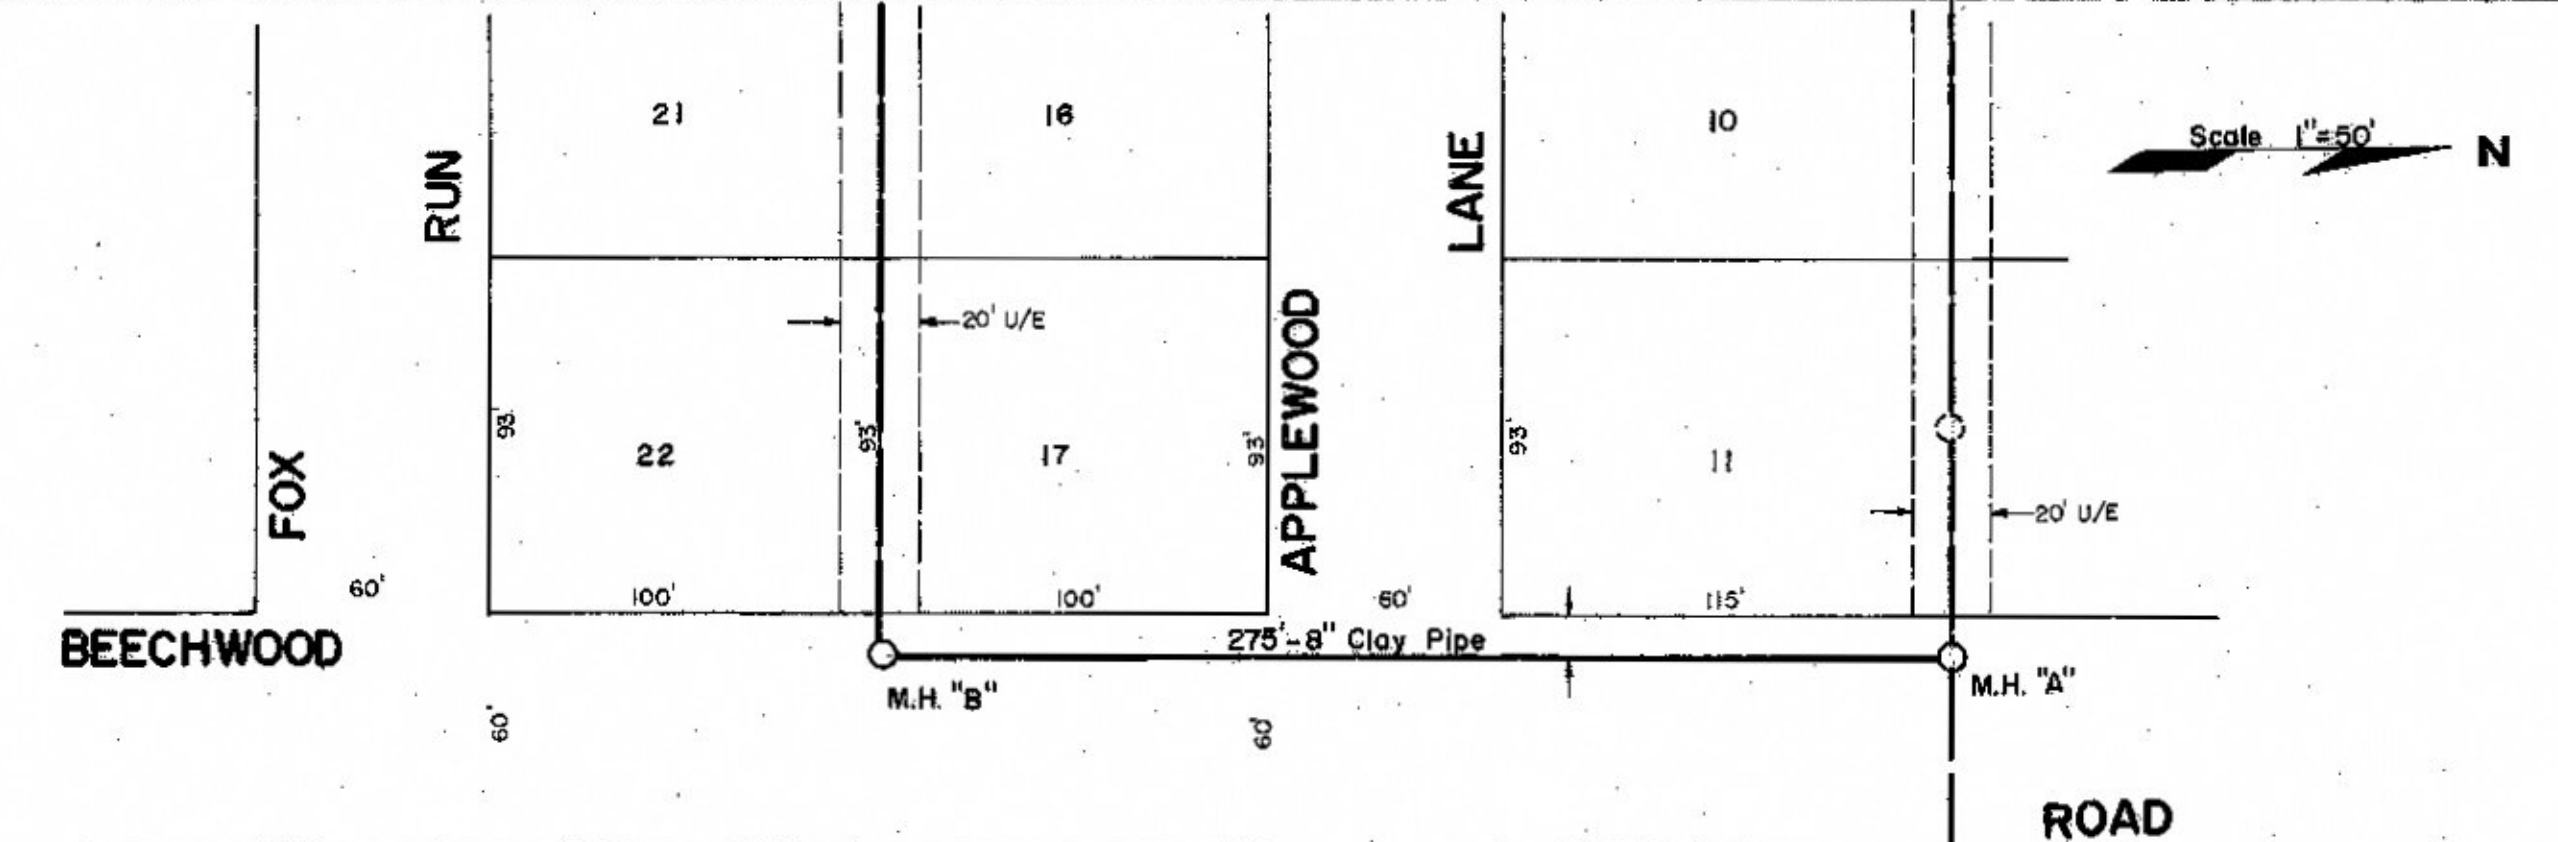

Scale 1"=50' N

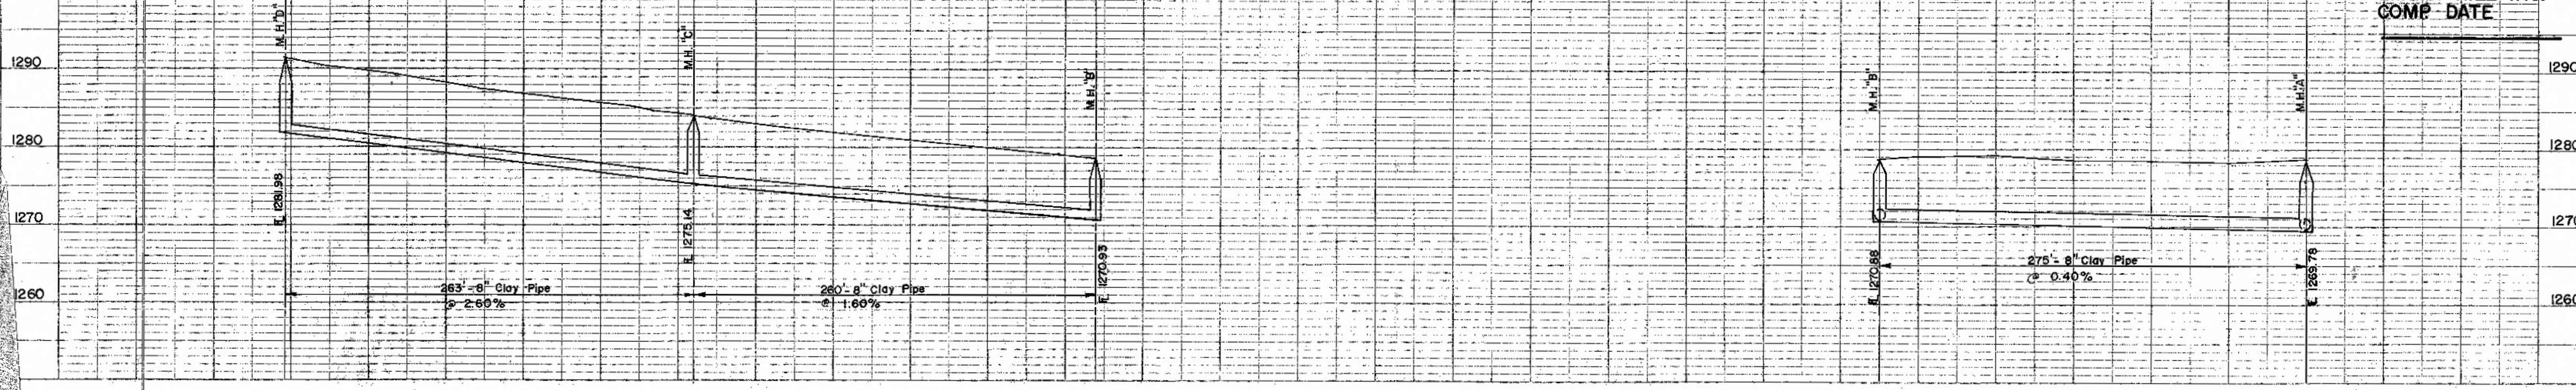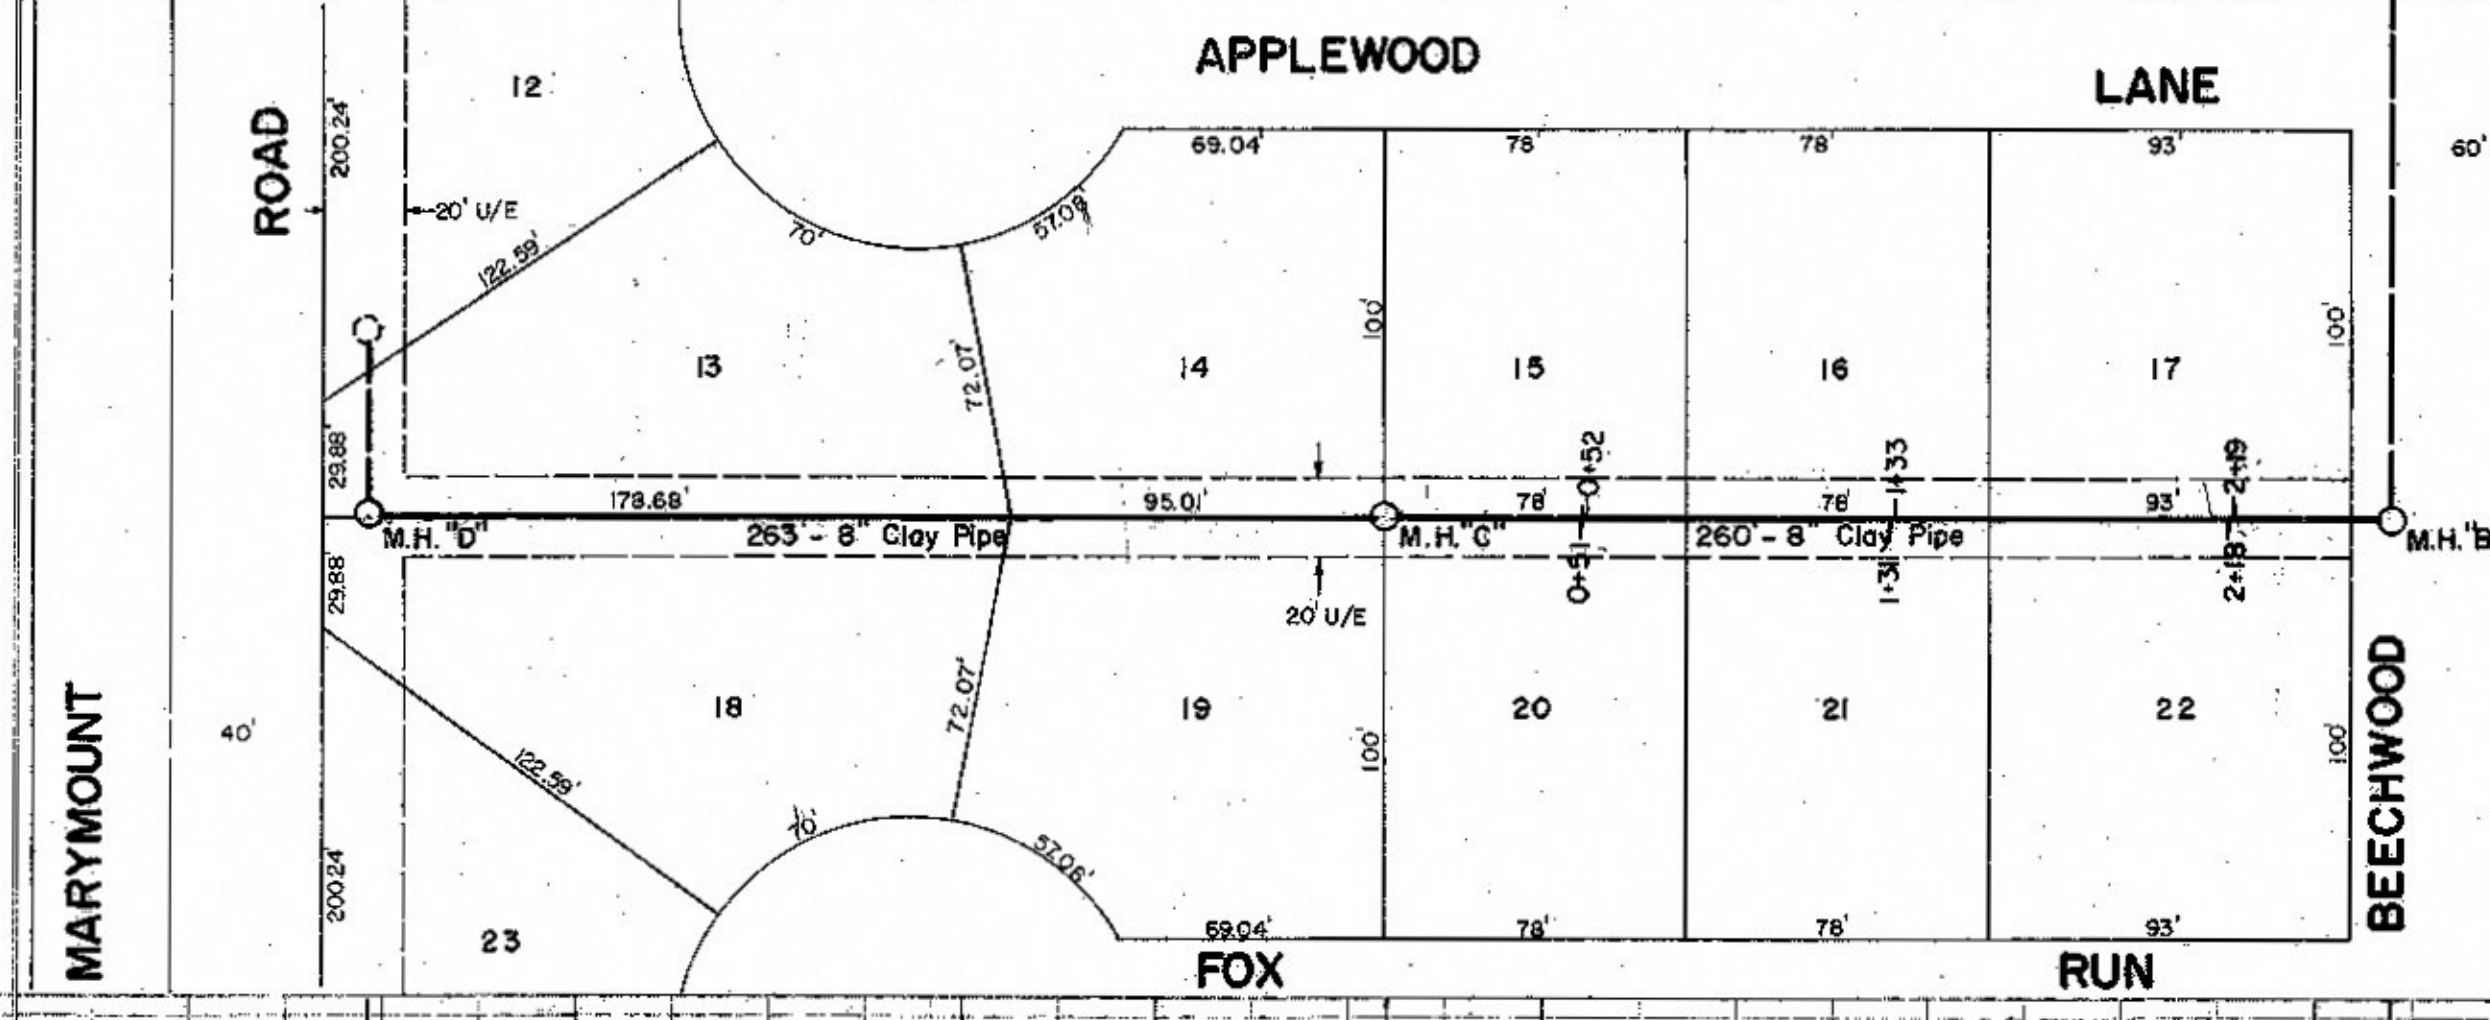

AS-BUILT PLANS
 PROJECT NO. 75-590
 SMOKY HILL, INC.
 COMP. DATE