


Scale 1"=50'

PLAN	REVISION	DATE
NO.	BY	
NOTE BOOK ALIGNMENT CHECKED.		
NO. OF P.W. ORISSED.		

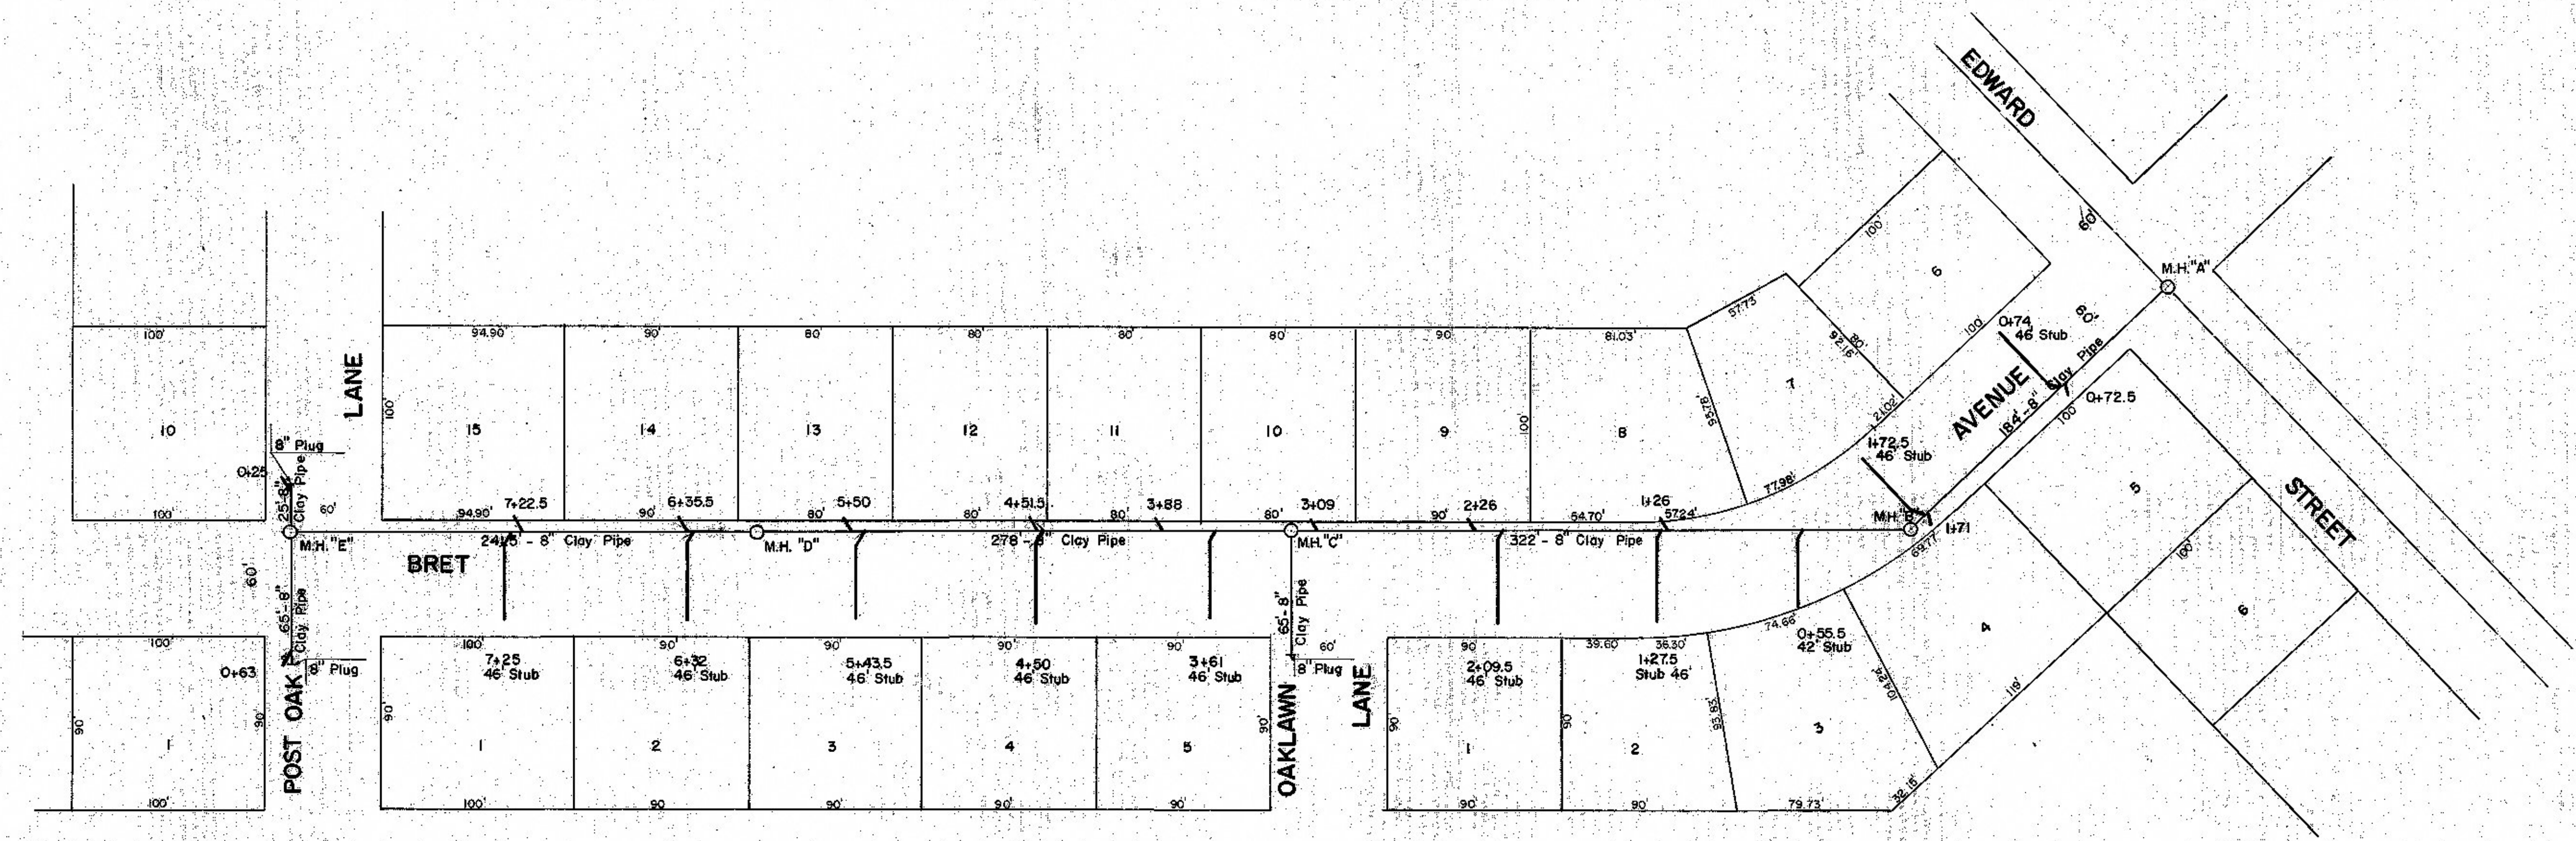

AS-BUILT PLANS
 PROJECT NO. 75-590
 SMOKY HILL CONST. INC.
 COMPLETION DATE:
 SEPT. 1975

PROFILE	REVISION	DATE
NO.	BY	
NOTE BOOK CHECKED.		
STRUCTURE NOTATION CHECKED.		

