


BY DATE
 SURVEYED BY
 CHECKED BY
 DATE
 NO. OF WAY CHECKS

BY DATE
 SURVEYED BY
 CHECKED BY
 DATE
 NO. OF WAY CHECKS



460

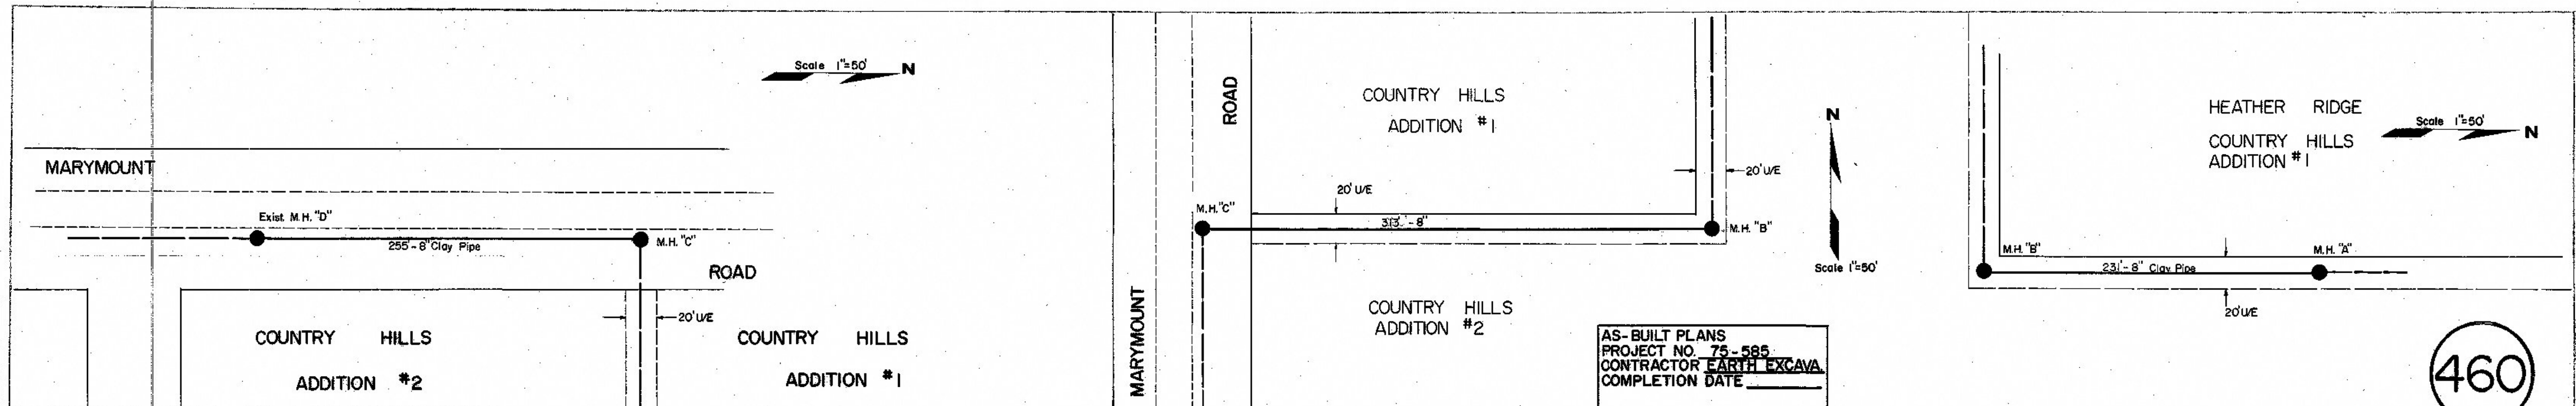