





LAURA

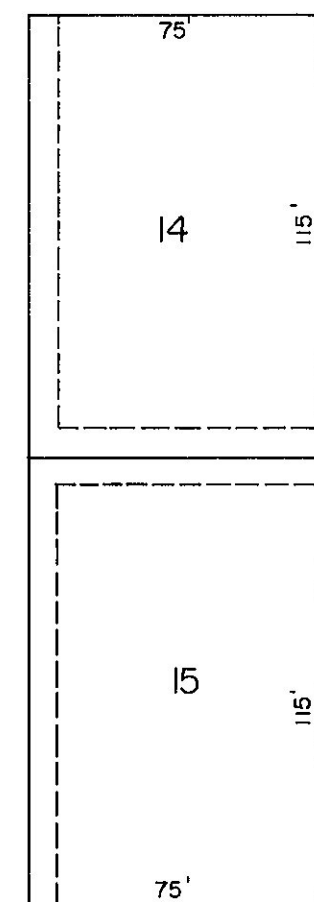



GAIL

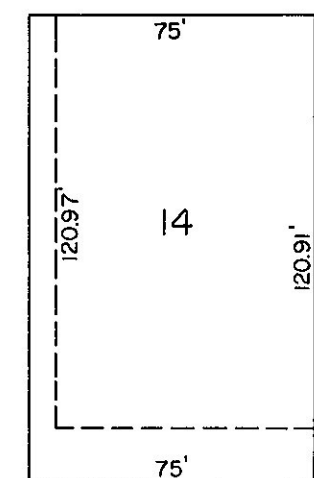

RAY

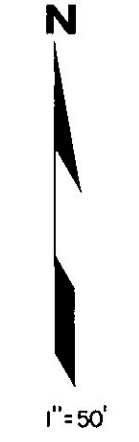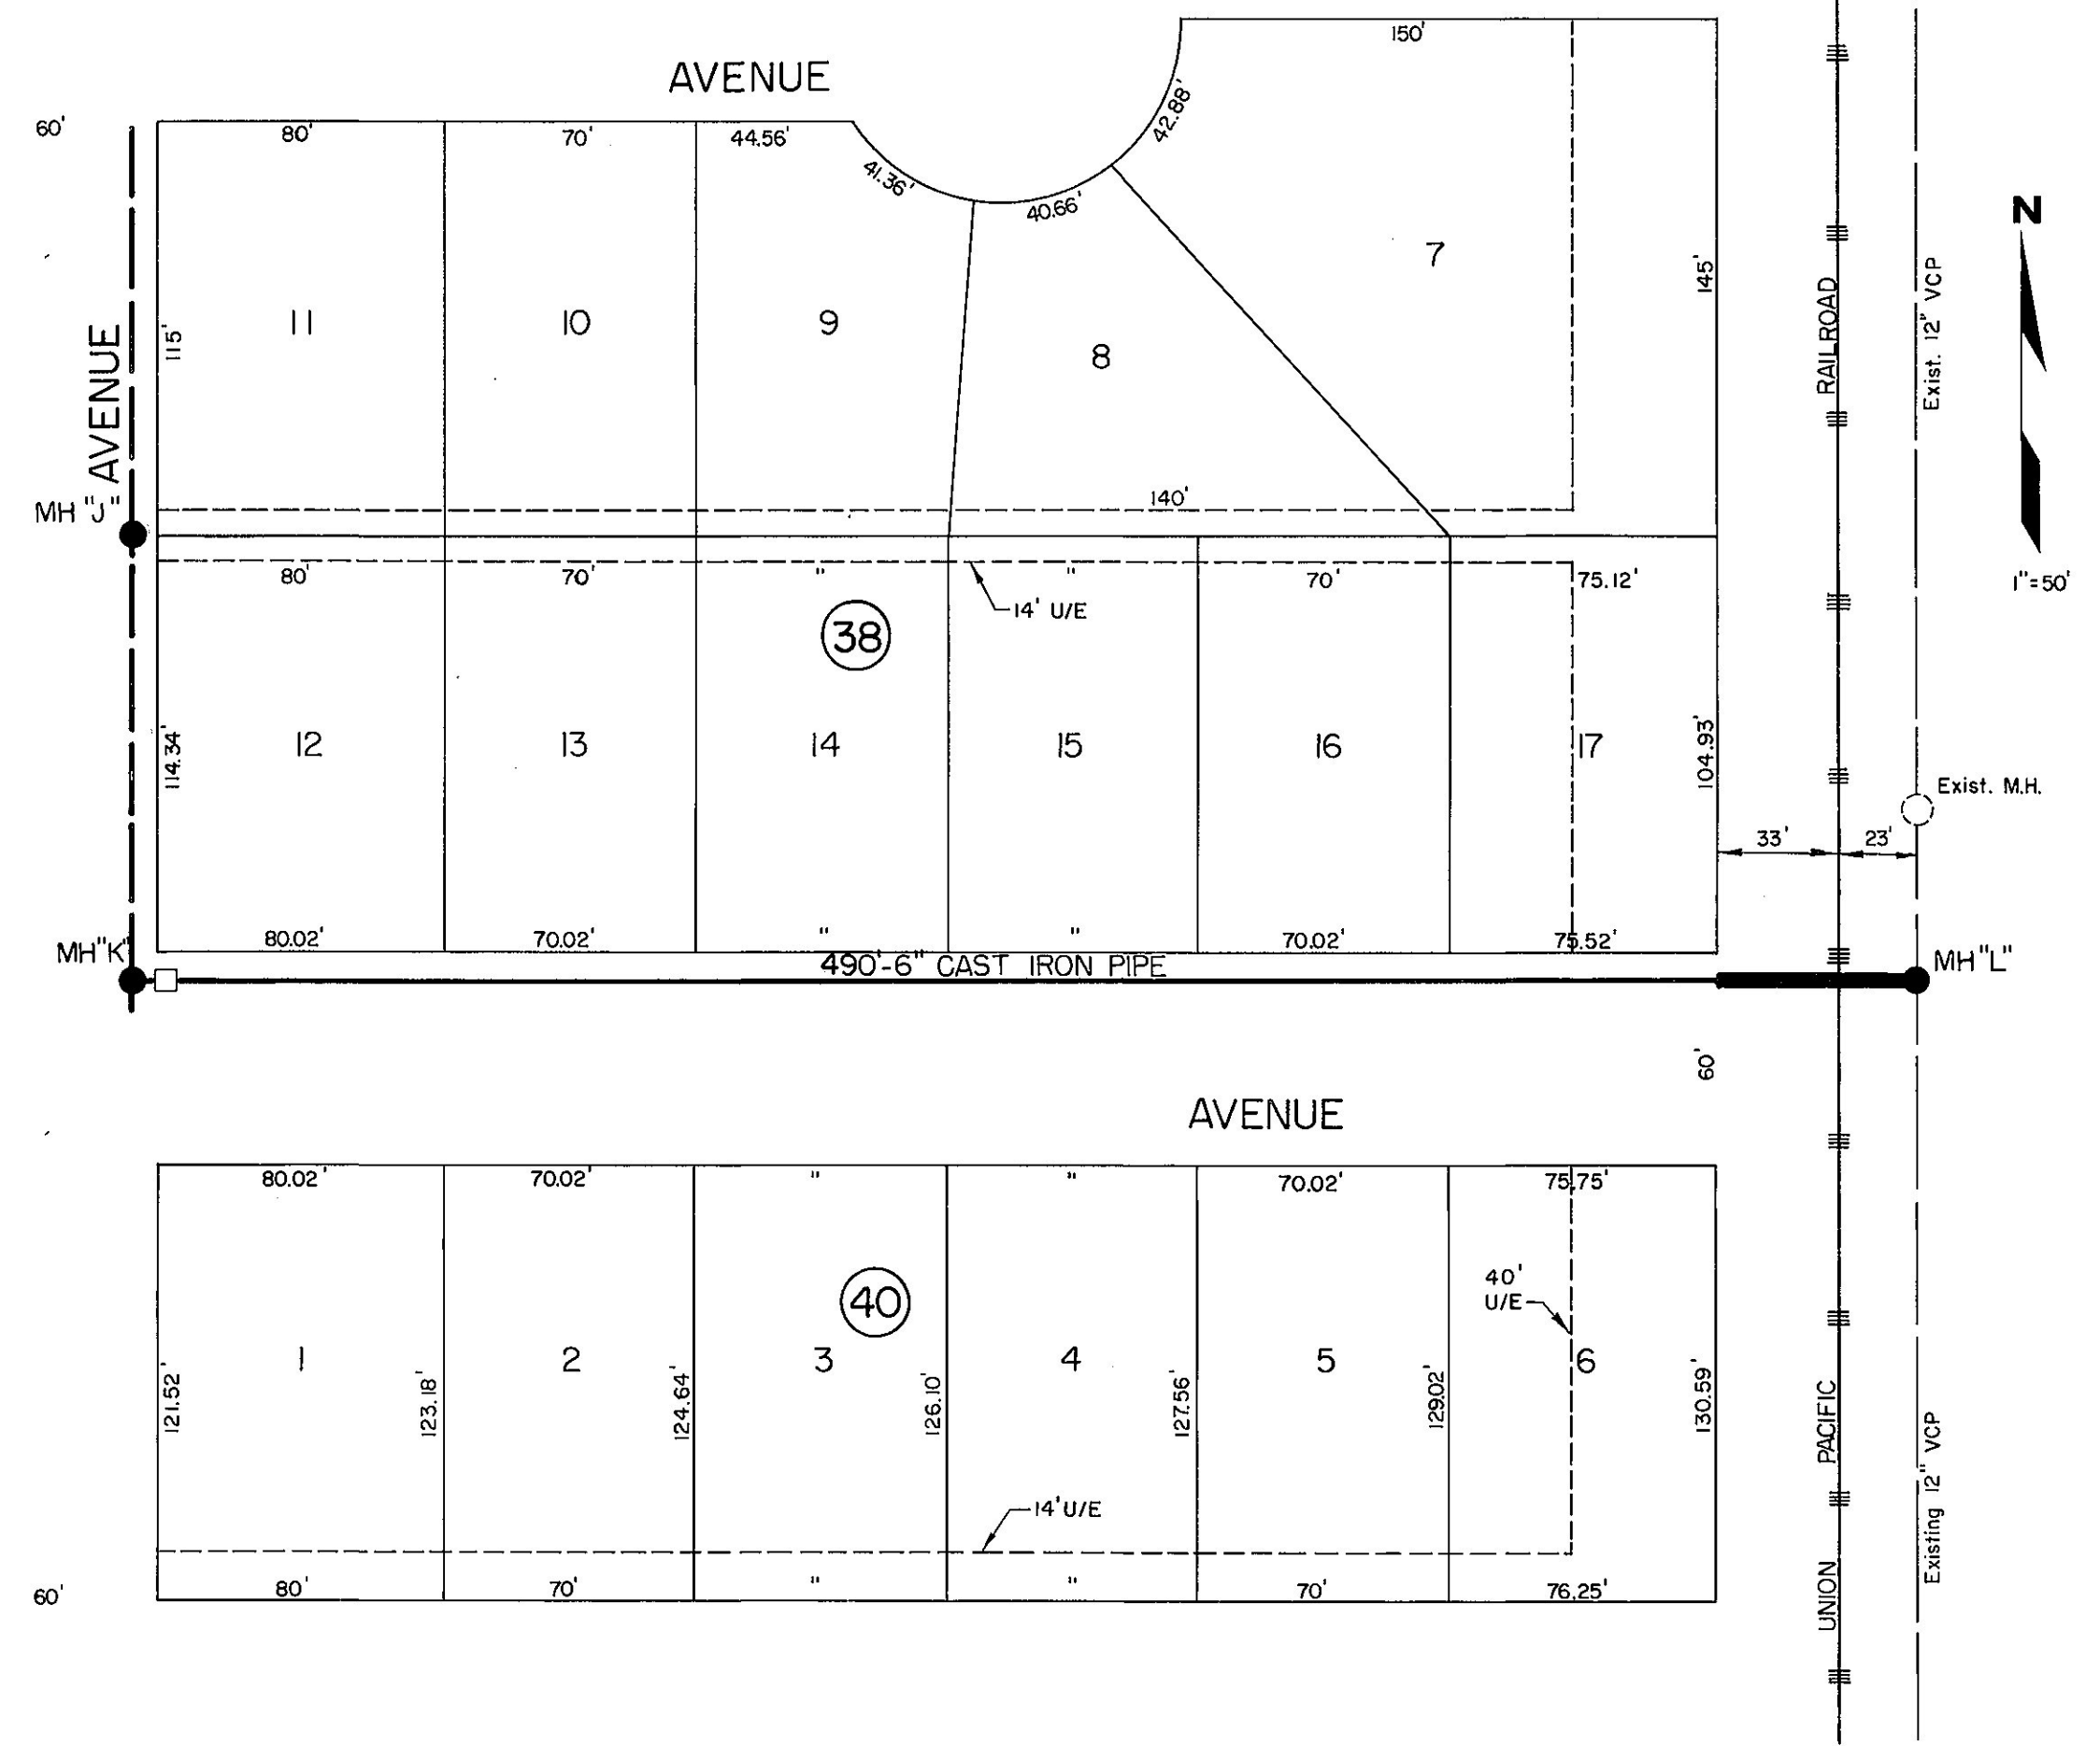

1240'
1235'
1230'
1225'
1220'
1215'
1210'

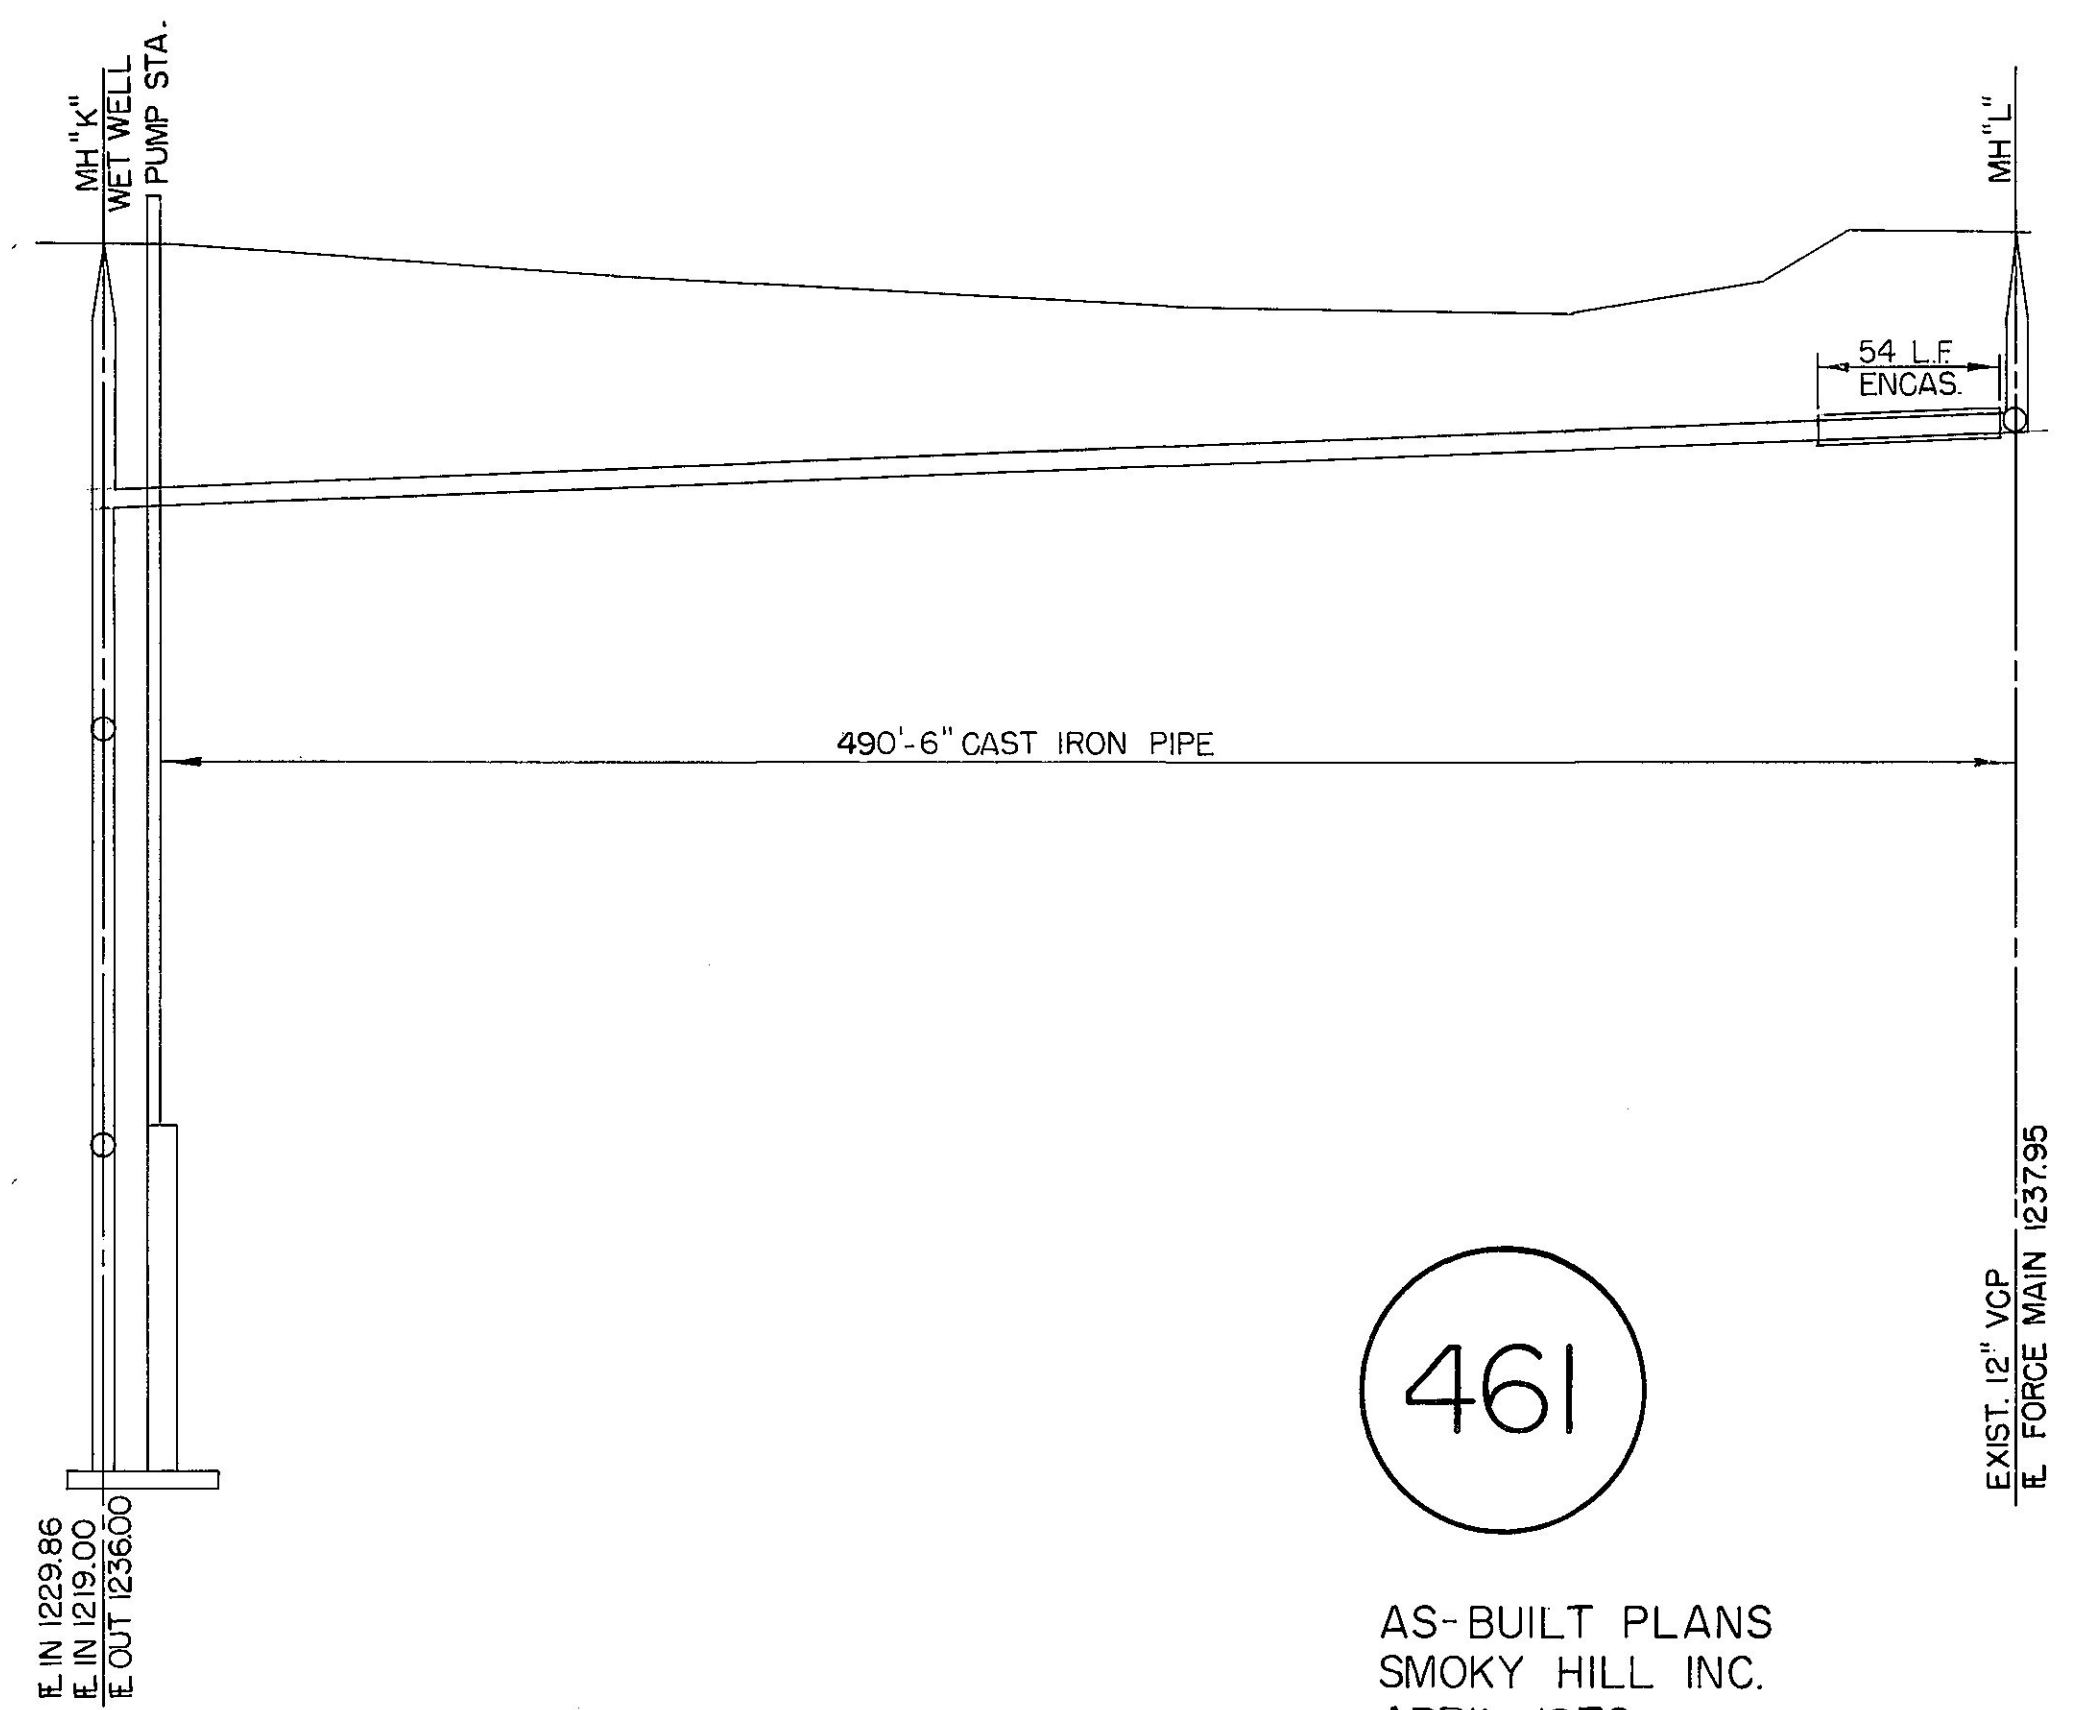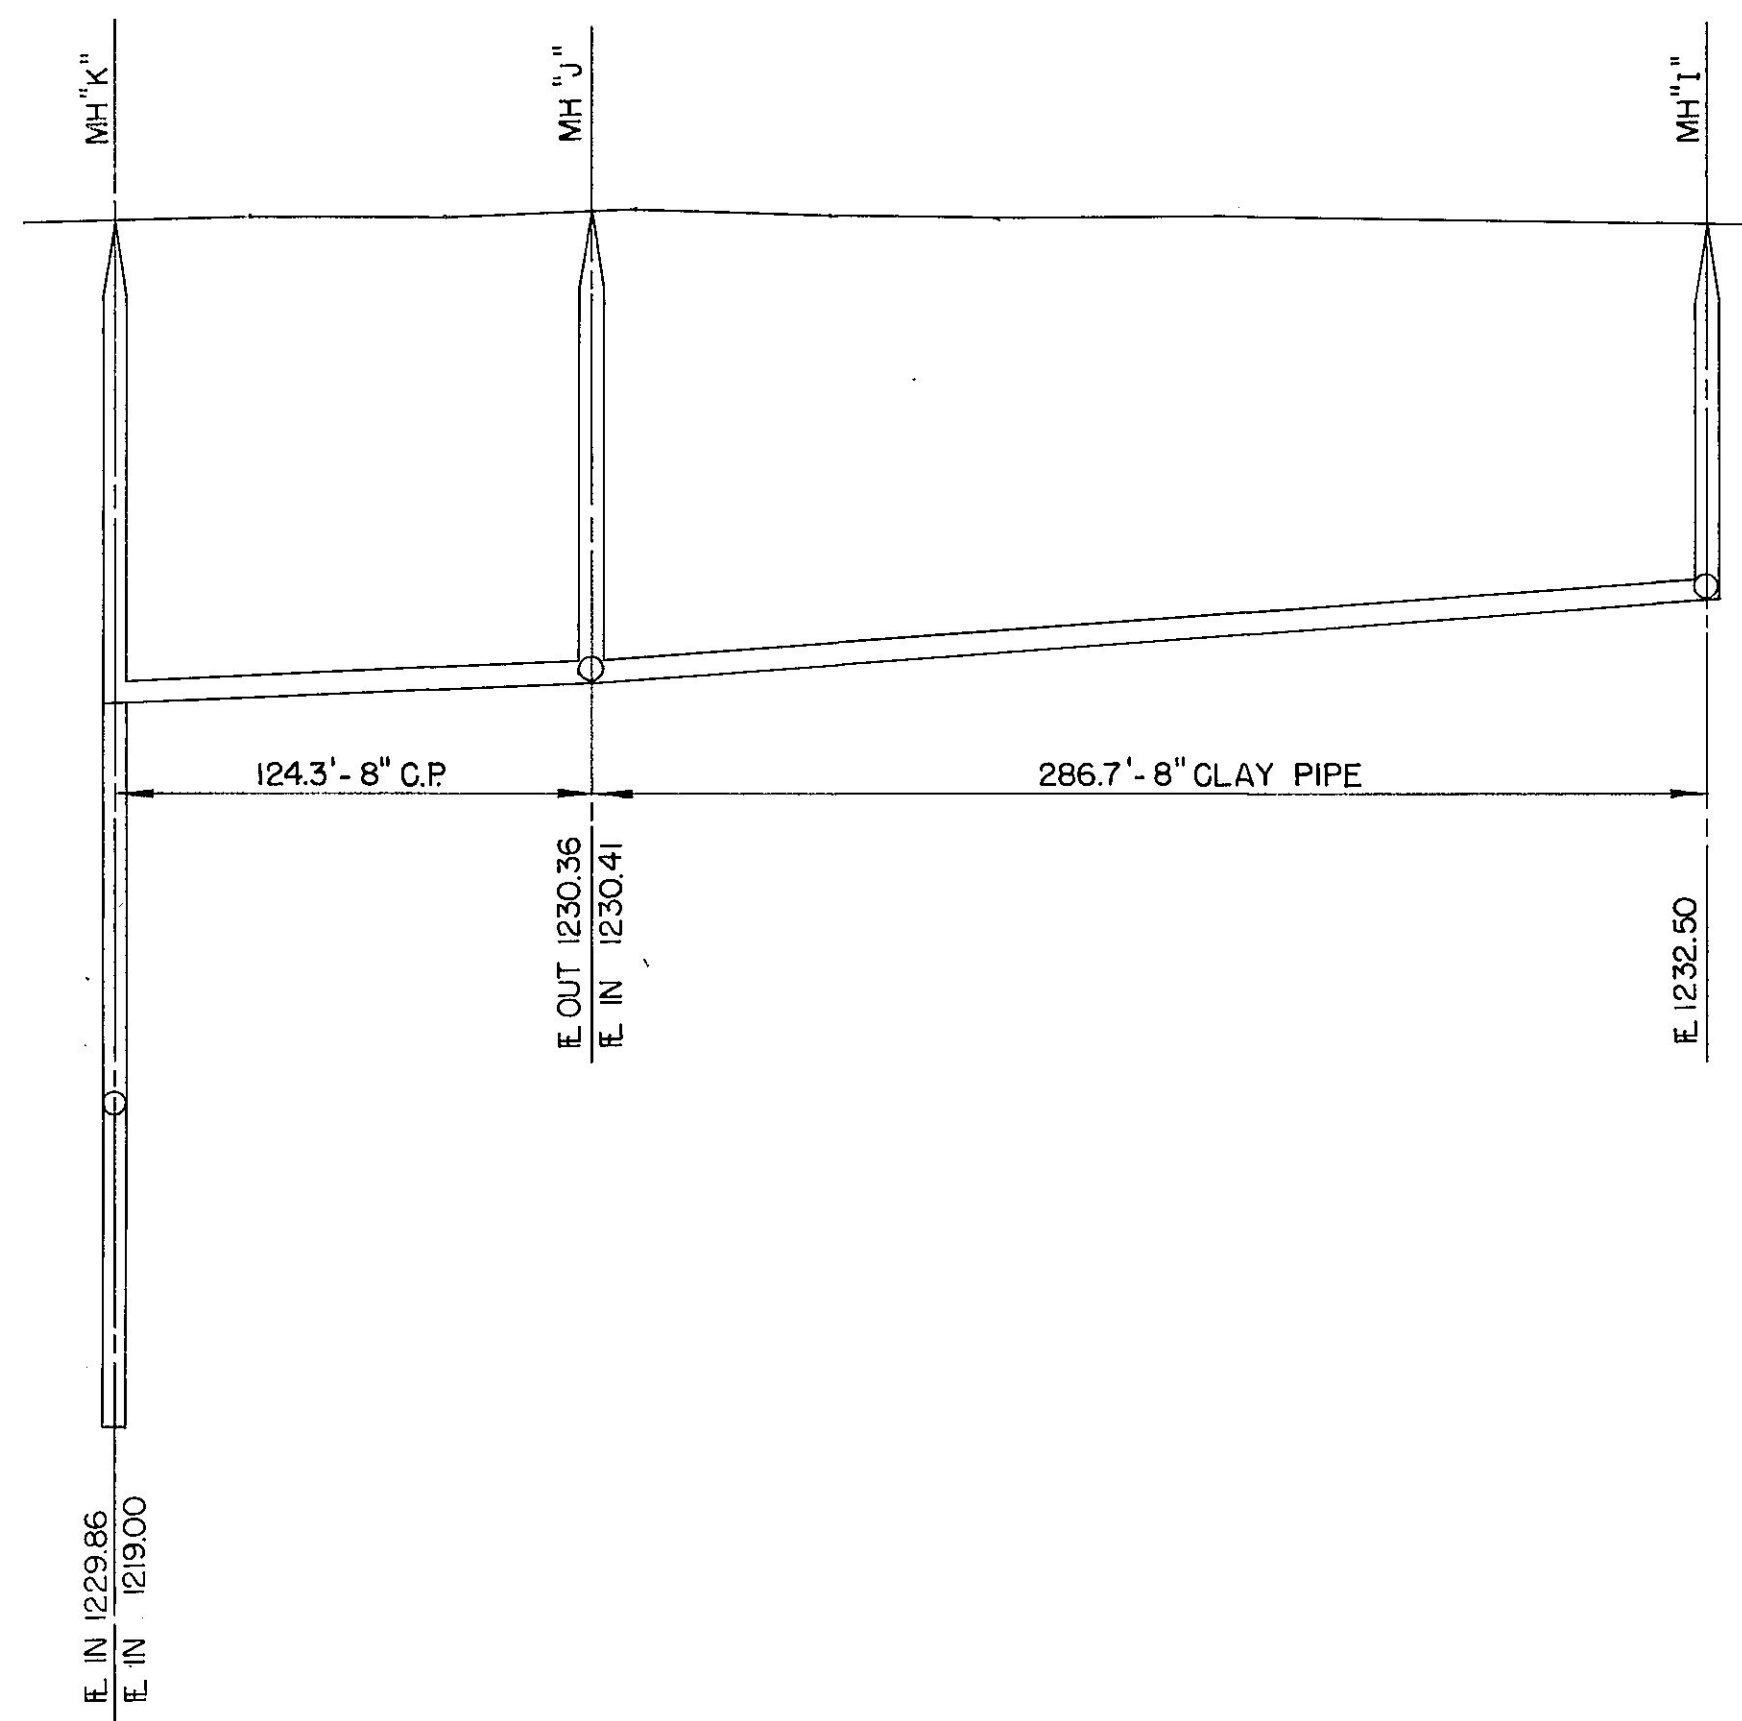

461

AS-BUILT PLANS
SMOKY HILL INC.
APRIL 1976
75-586

EXIST. 12" VCP
E. FORCE MAIN 1237.95