


PLAN
 5/19/76
 NOTE BOOK 75-586
 FLOW V. C. 500

462

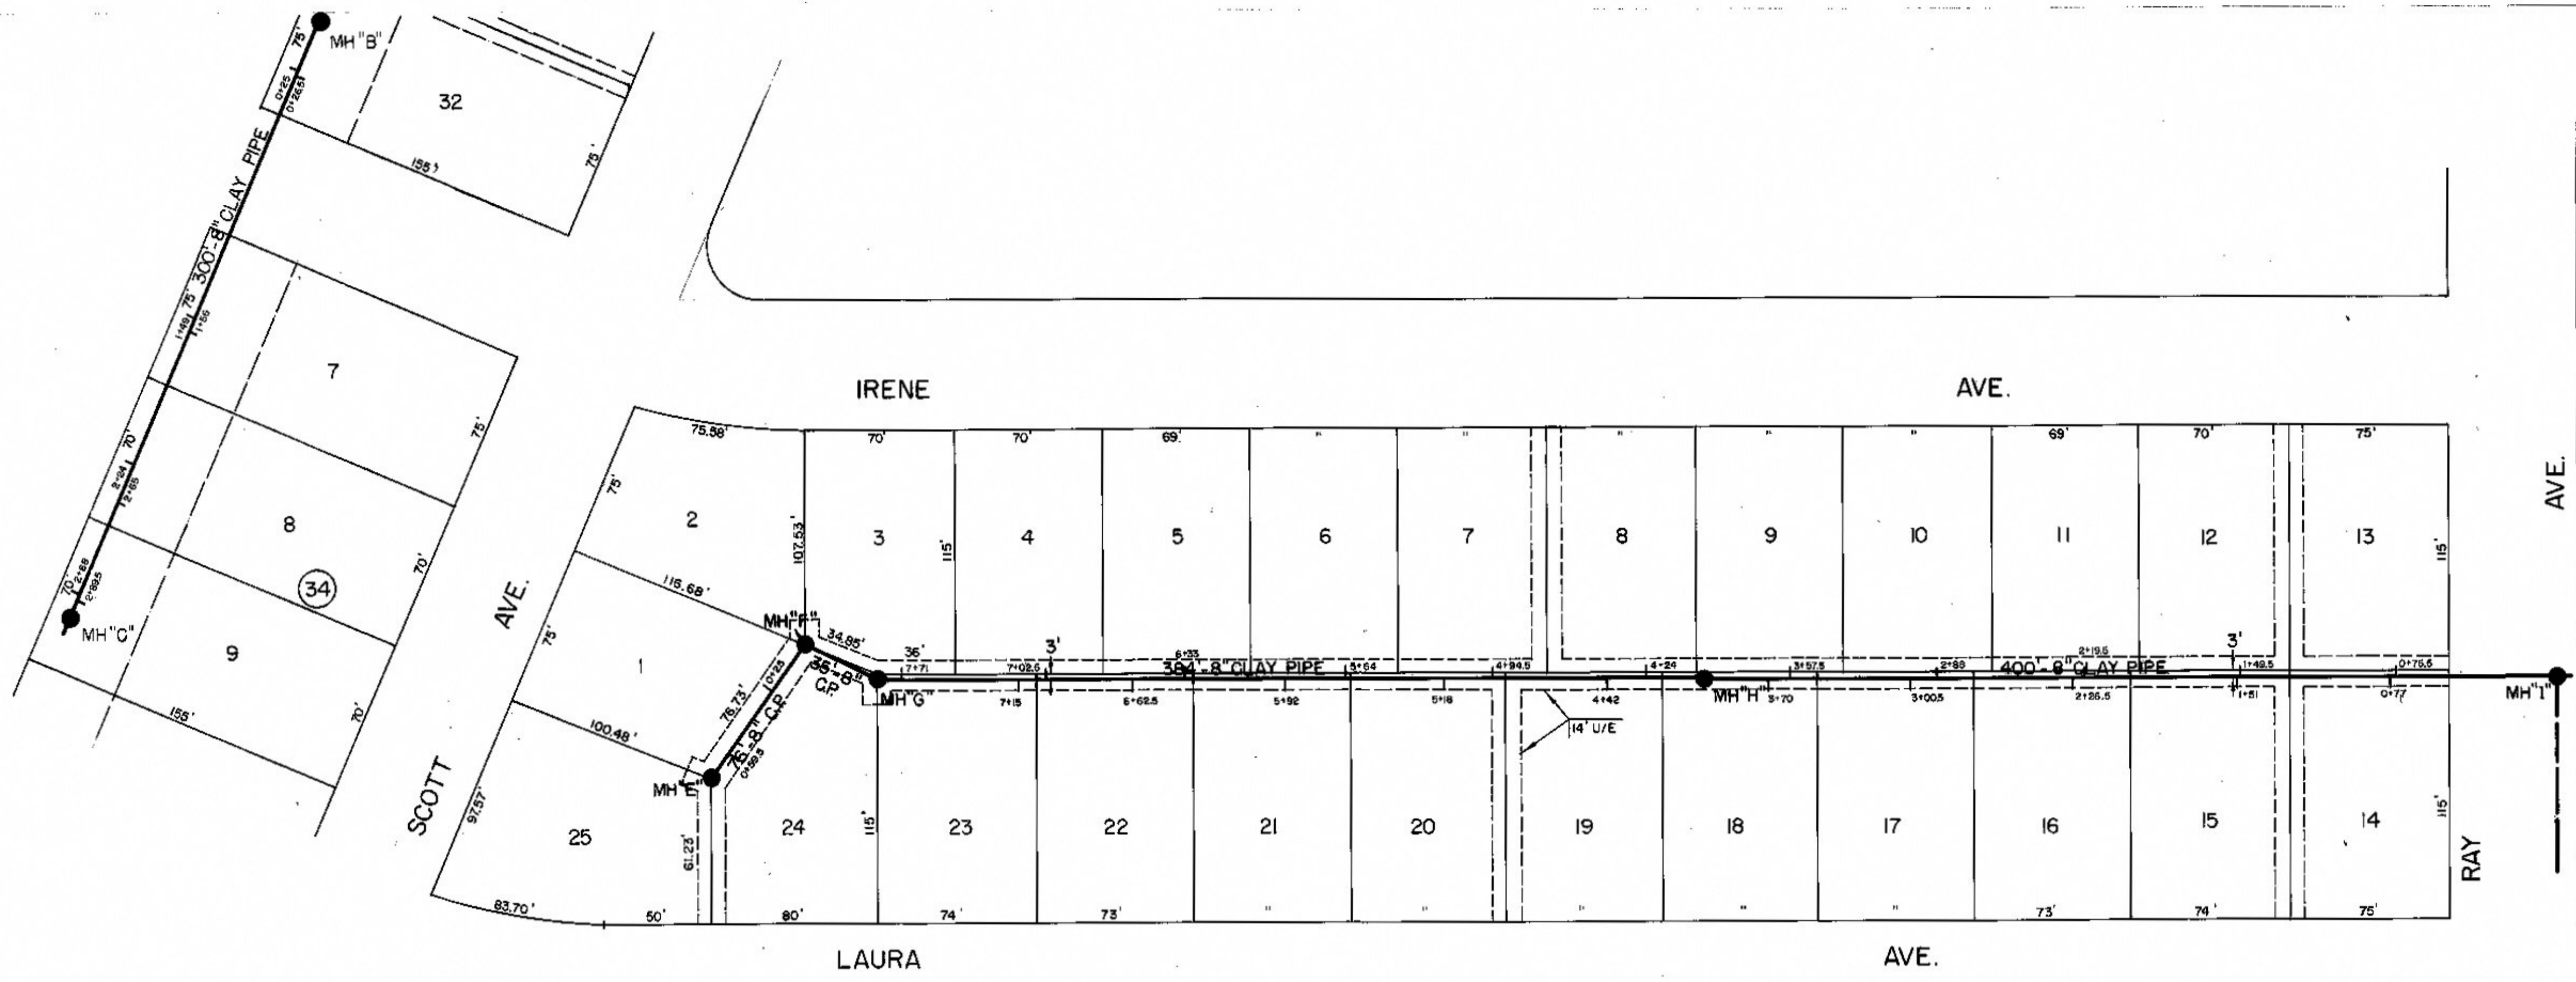

AS-BUILT PLANS
 SMOKY HILL INC.
 APRIL 1976
 75-586

PROFILE
 5/19/76
 NOTE BOOK 75-586
 FLOW V. C. 500

