


PLAN	BY	DATE
DESIGNED		
CHECKED		
APPROVED		
DATE		

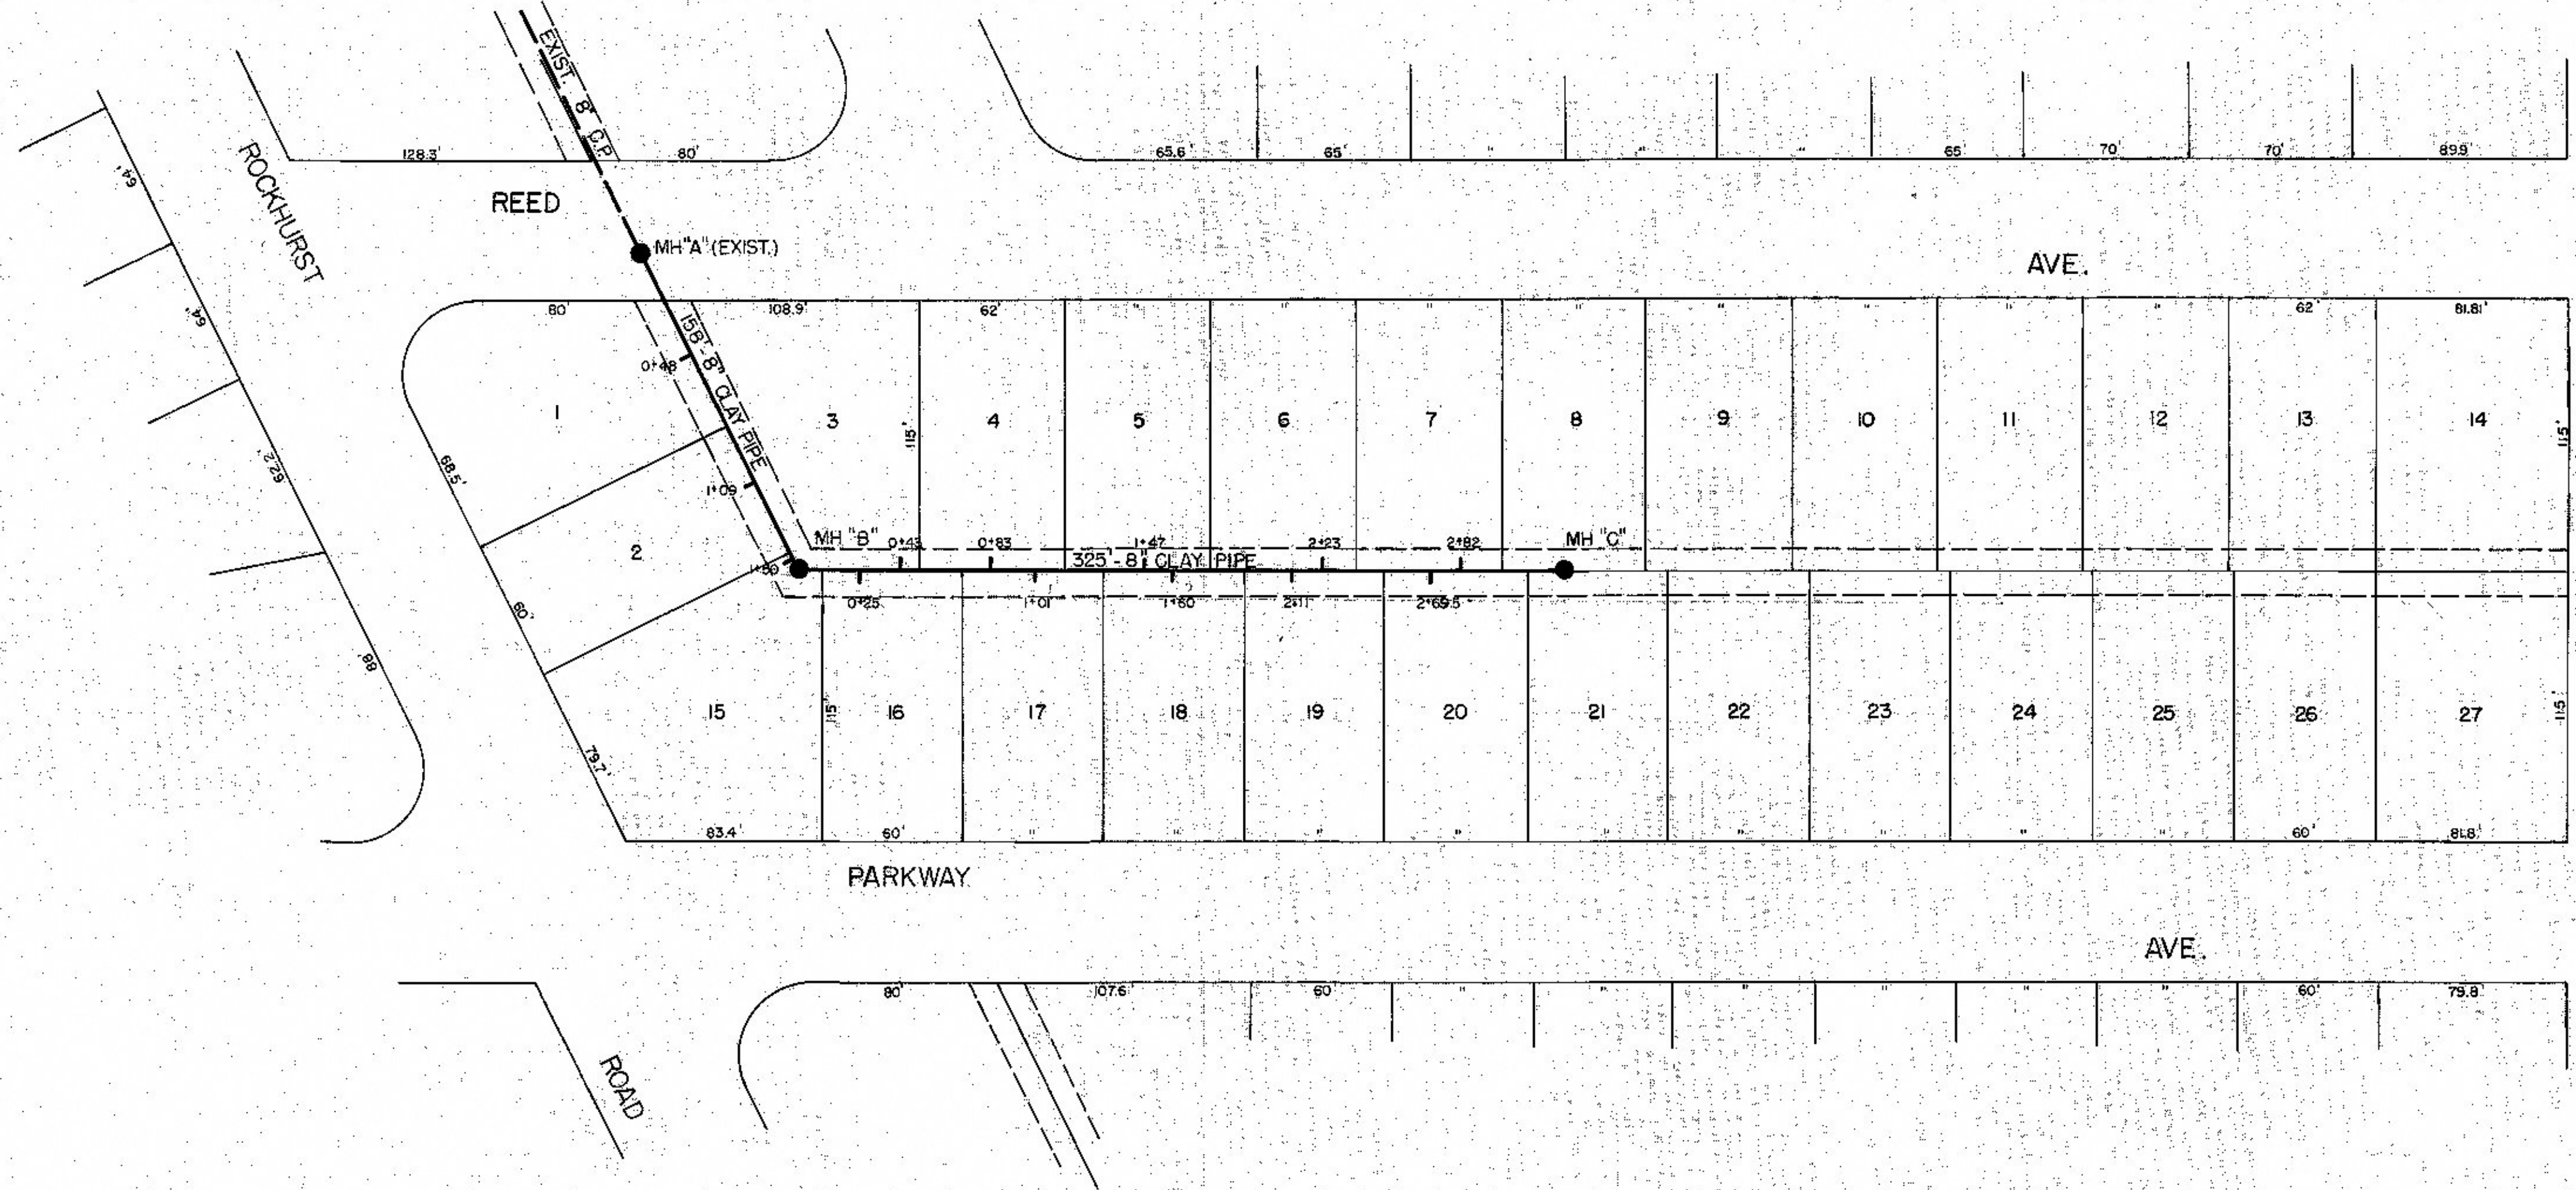

463

AS-BUILT PLANS
SMOKY HILL INC.
APRIL 1976
75-586

PROJECT	BY	DATE
DESIGNED		
CHECKED		
APPROVED		
DATE		

