




PLAN SURVEYED BY DATE
 PLOTTED BY
 NOTE BOOK NO. OF WAY CHECKED
 NO.

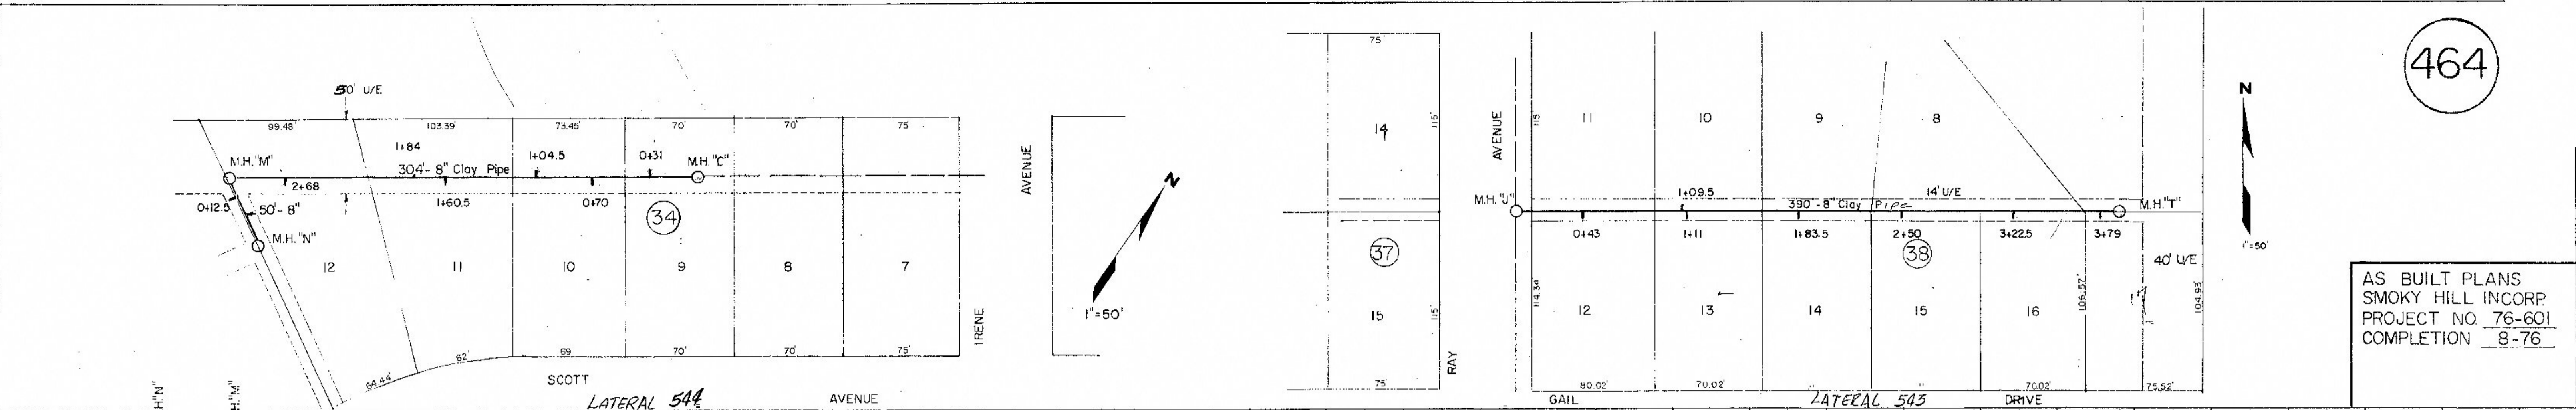

AS BUILT PLANS
 SMOKY HILL INCORP
 PROJECT NO. 76-601
 COMPLETION 8-76

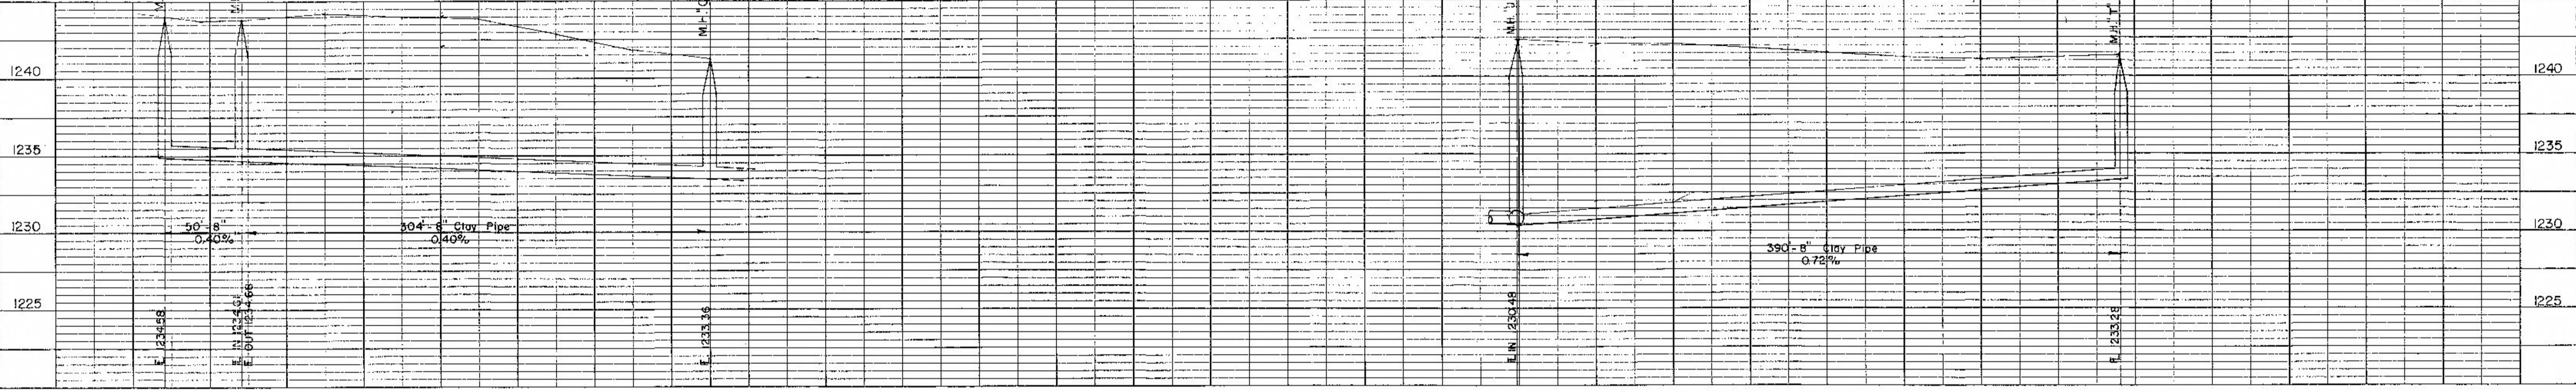

PROFILE SURVEYED BY DATE
 PLOTTED BY
 NOTE BOOK NO. GRADES CHECKED
 NO. STRUCTURE NOTATIONS CRD.

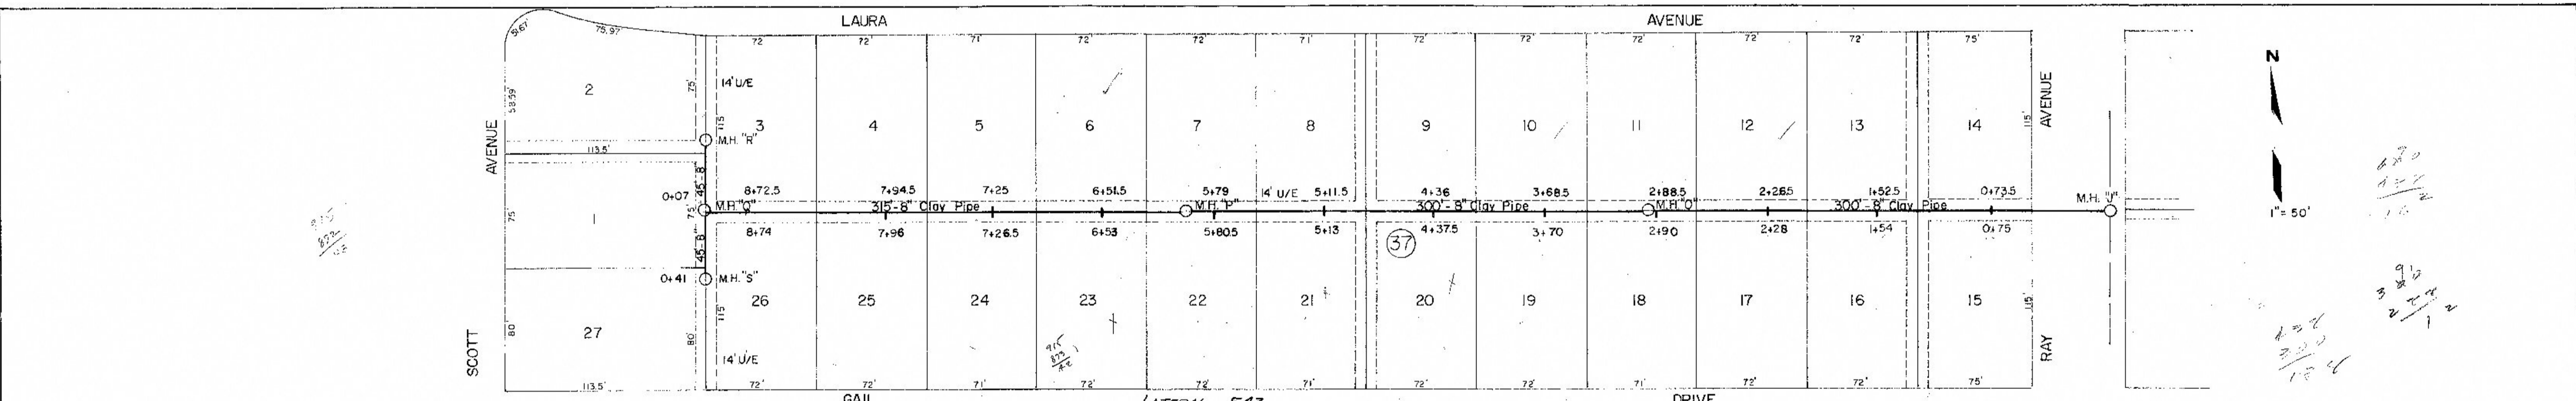

Handwritten notes:
 870
 877
 110
 910
 324
 244
 184

