


NO.	
DATE	
BY	
PROJECT	
DESIGNED	
CHECKED	
DATE	
BY	
PROJECT	
DESIGNED	
CHECKED	
DATE	
BY	

NO.	
DATE	
BY	
PROJECT	
DESIGNED	
CHECKED	
DATE	
BY	
PROJECT	
DESIGNED	
CHECKED	
DATE	
BY	

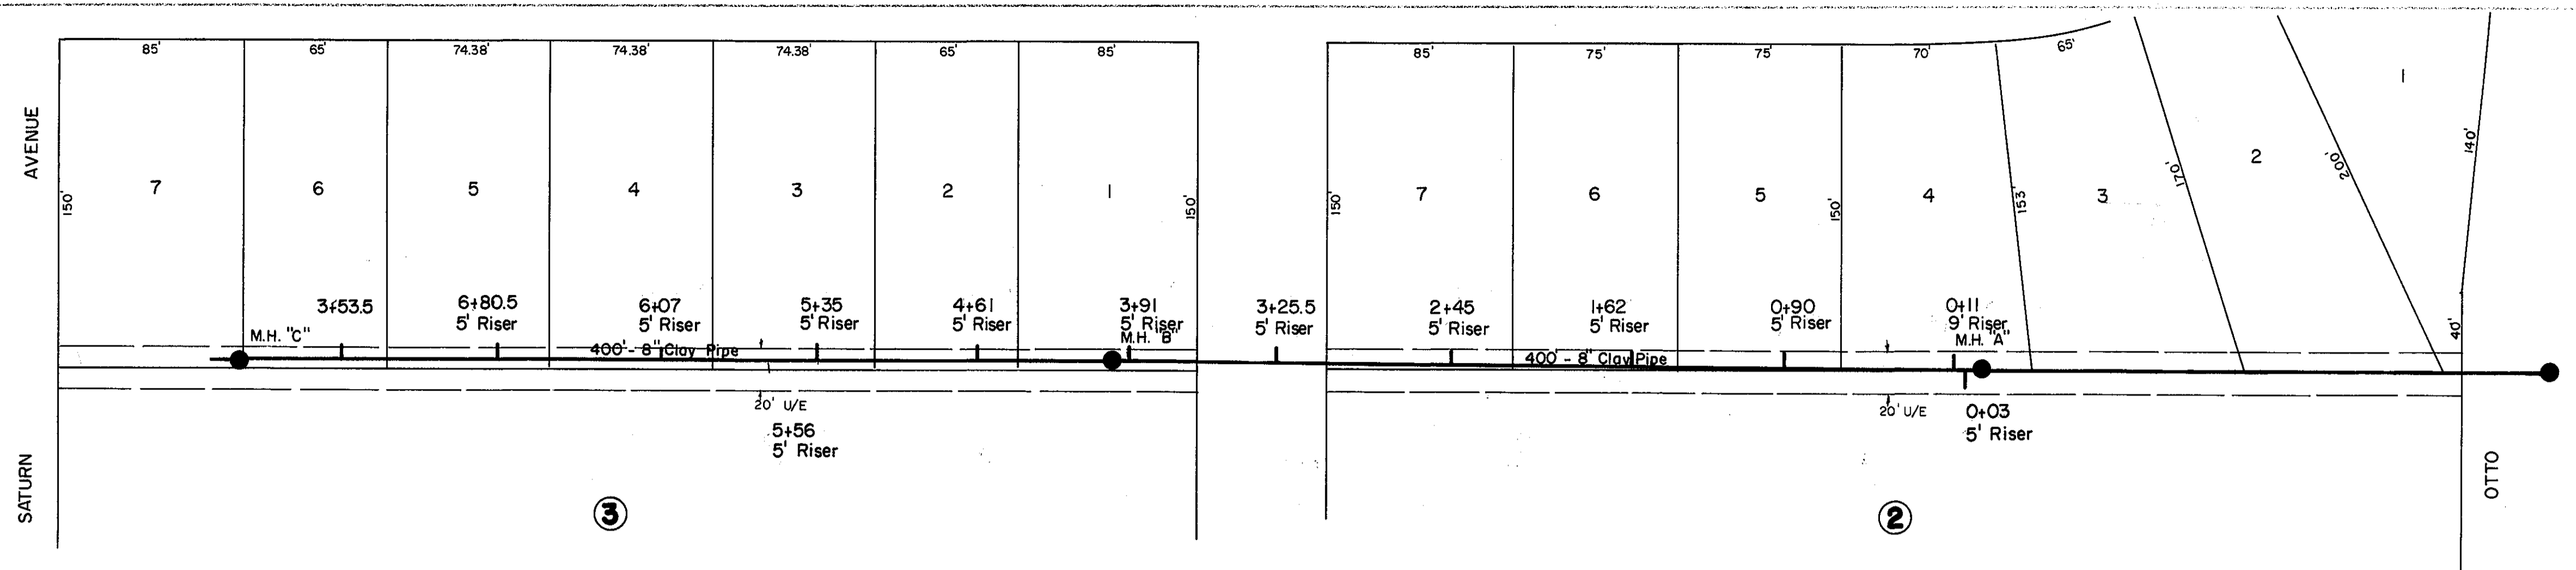

1"=50' N

465

AS BUILT PLANS  
SMOKY HILL INC.  
PROJECT NO. 76-601  
COMPLETION 8-76

