


81 DRIVE IN THEATRE


SULLIVAN

ADDITION

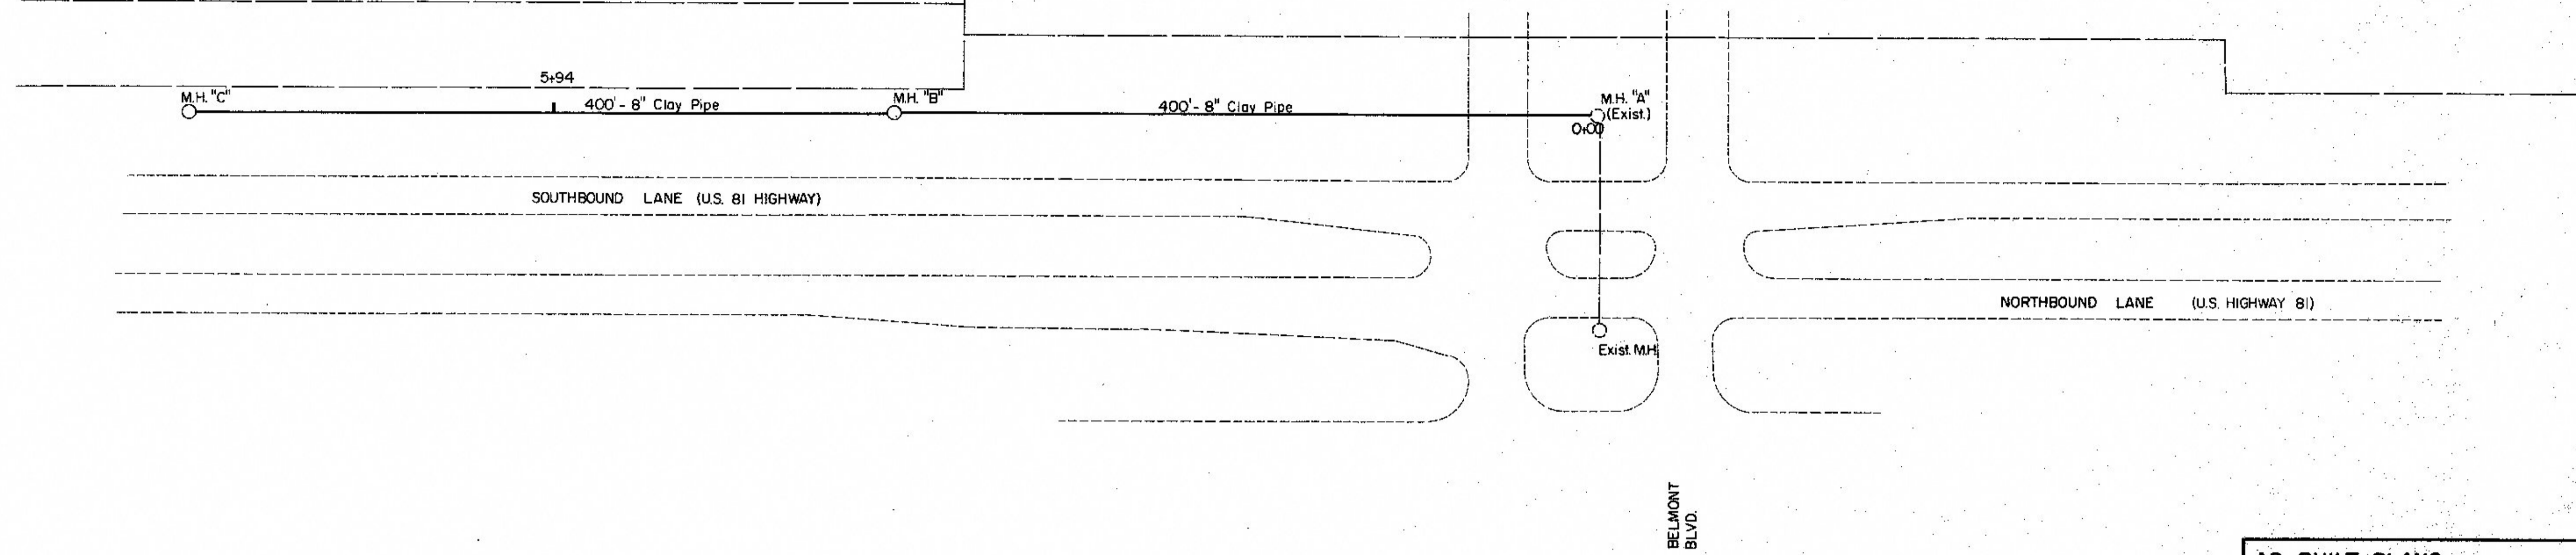

AS BUILT PLANS
 PROJECT NO. 76-601-1
 SMOKY HILL INC.
 SEPTEMBER 1976

Lat. 546

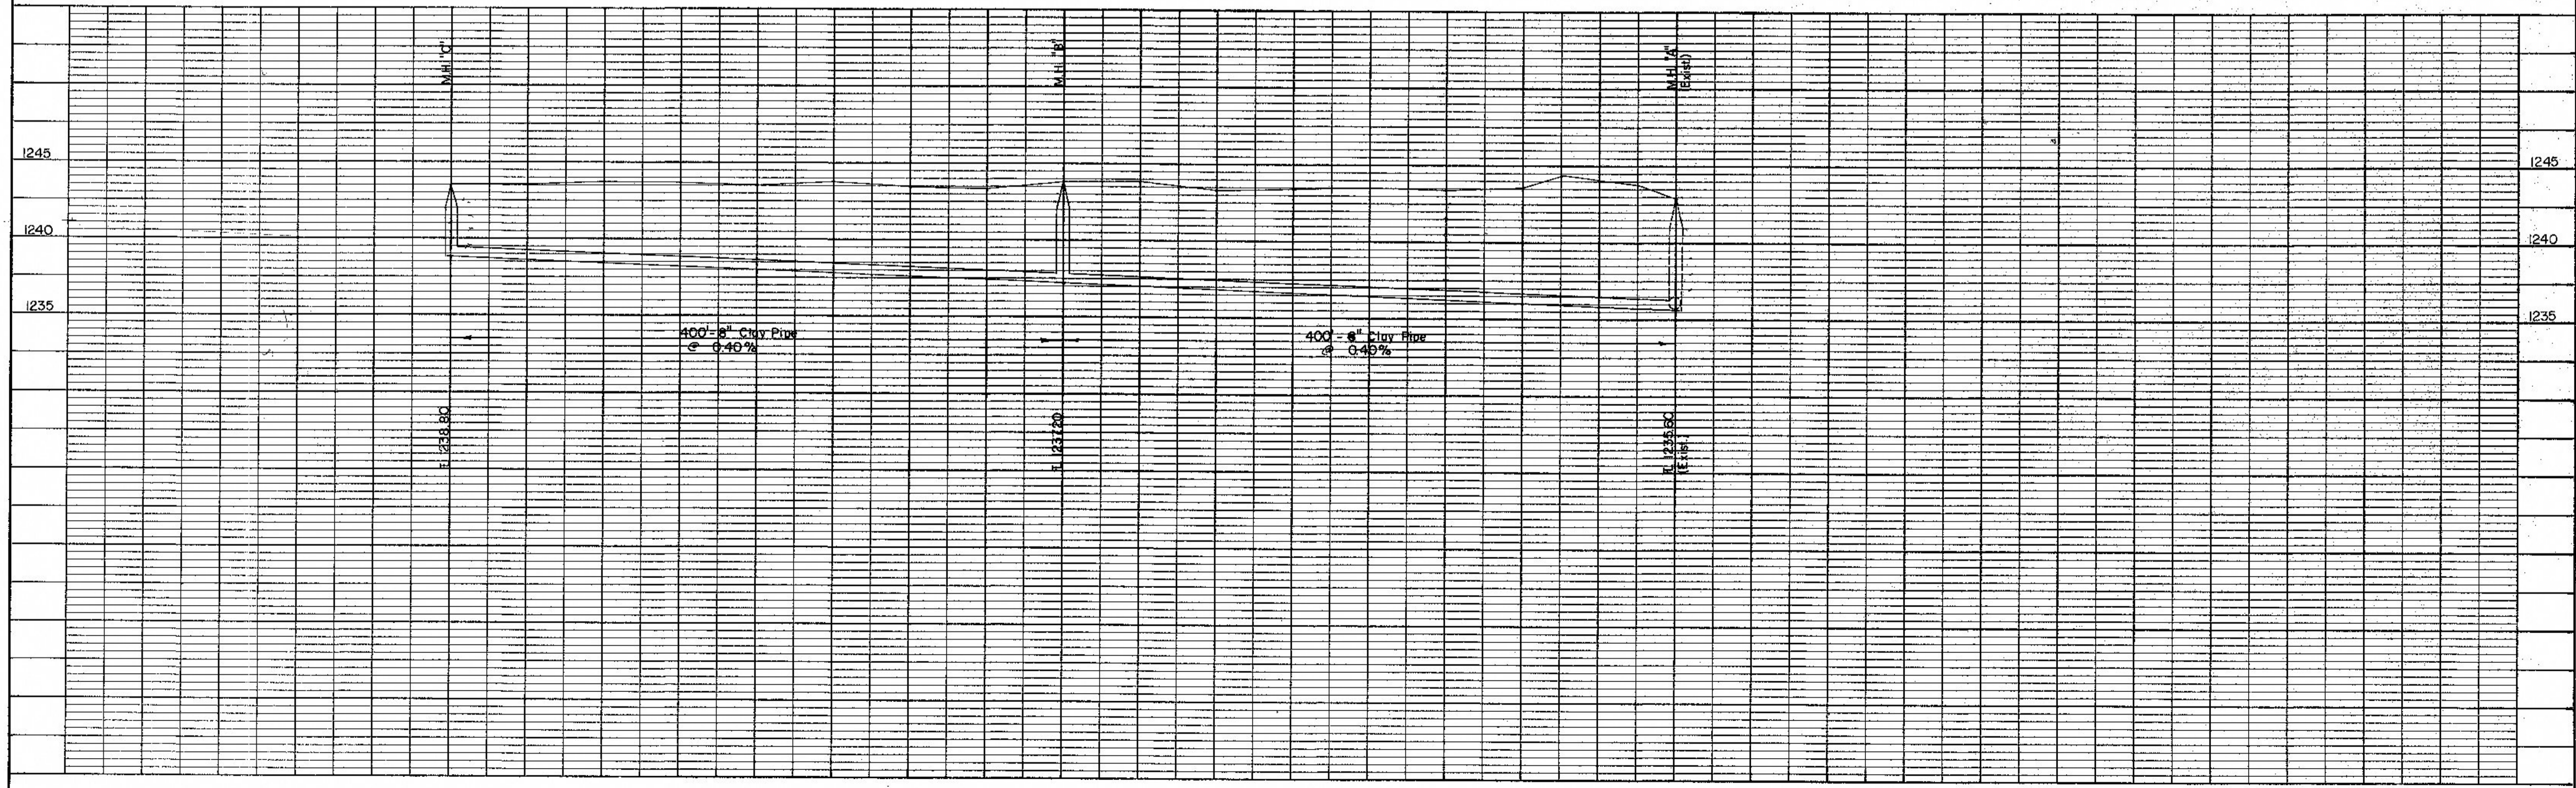

DATE: _____
 BY: _____
 SUPERVISOR: _____
 CHECKED: _____
 ALIGNED: _____
 NOTE BOOK No. _____

DATE: _____
 BY: _____
 SUPERVISOR: _____
 CHECKED: _____
 ALIGNED: _____
 PROFILE No. _____