


**PLAN**  
 CHECKED BY  
 PLOTTED BY  
 NOTE BOOK: ALIGNED CHECKS  
 11/07/76  
 No.

**PROFILE**  
 CHECKED BY  
 PLOTTED BY  
 NOTE BOOK: S.W. NOTES  
 11/07/76  
 1. PENDING DATE/LOCATION/SCALE



AS BUILT PLANS  
 PROJECT NO. 76-600  
 J.S. FRANK CONST.  
 COMPLETION DATE 6-'76

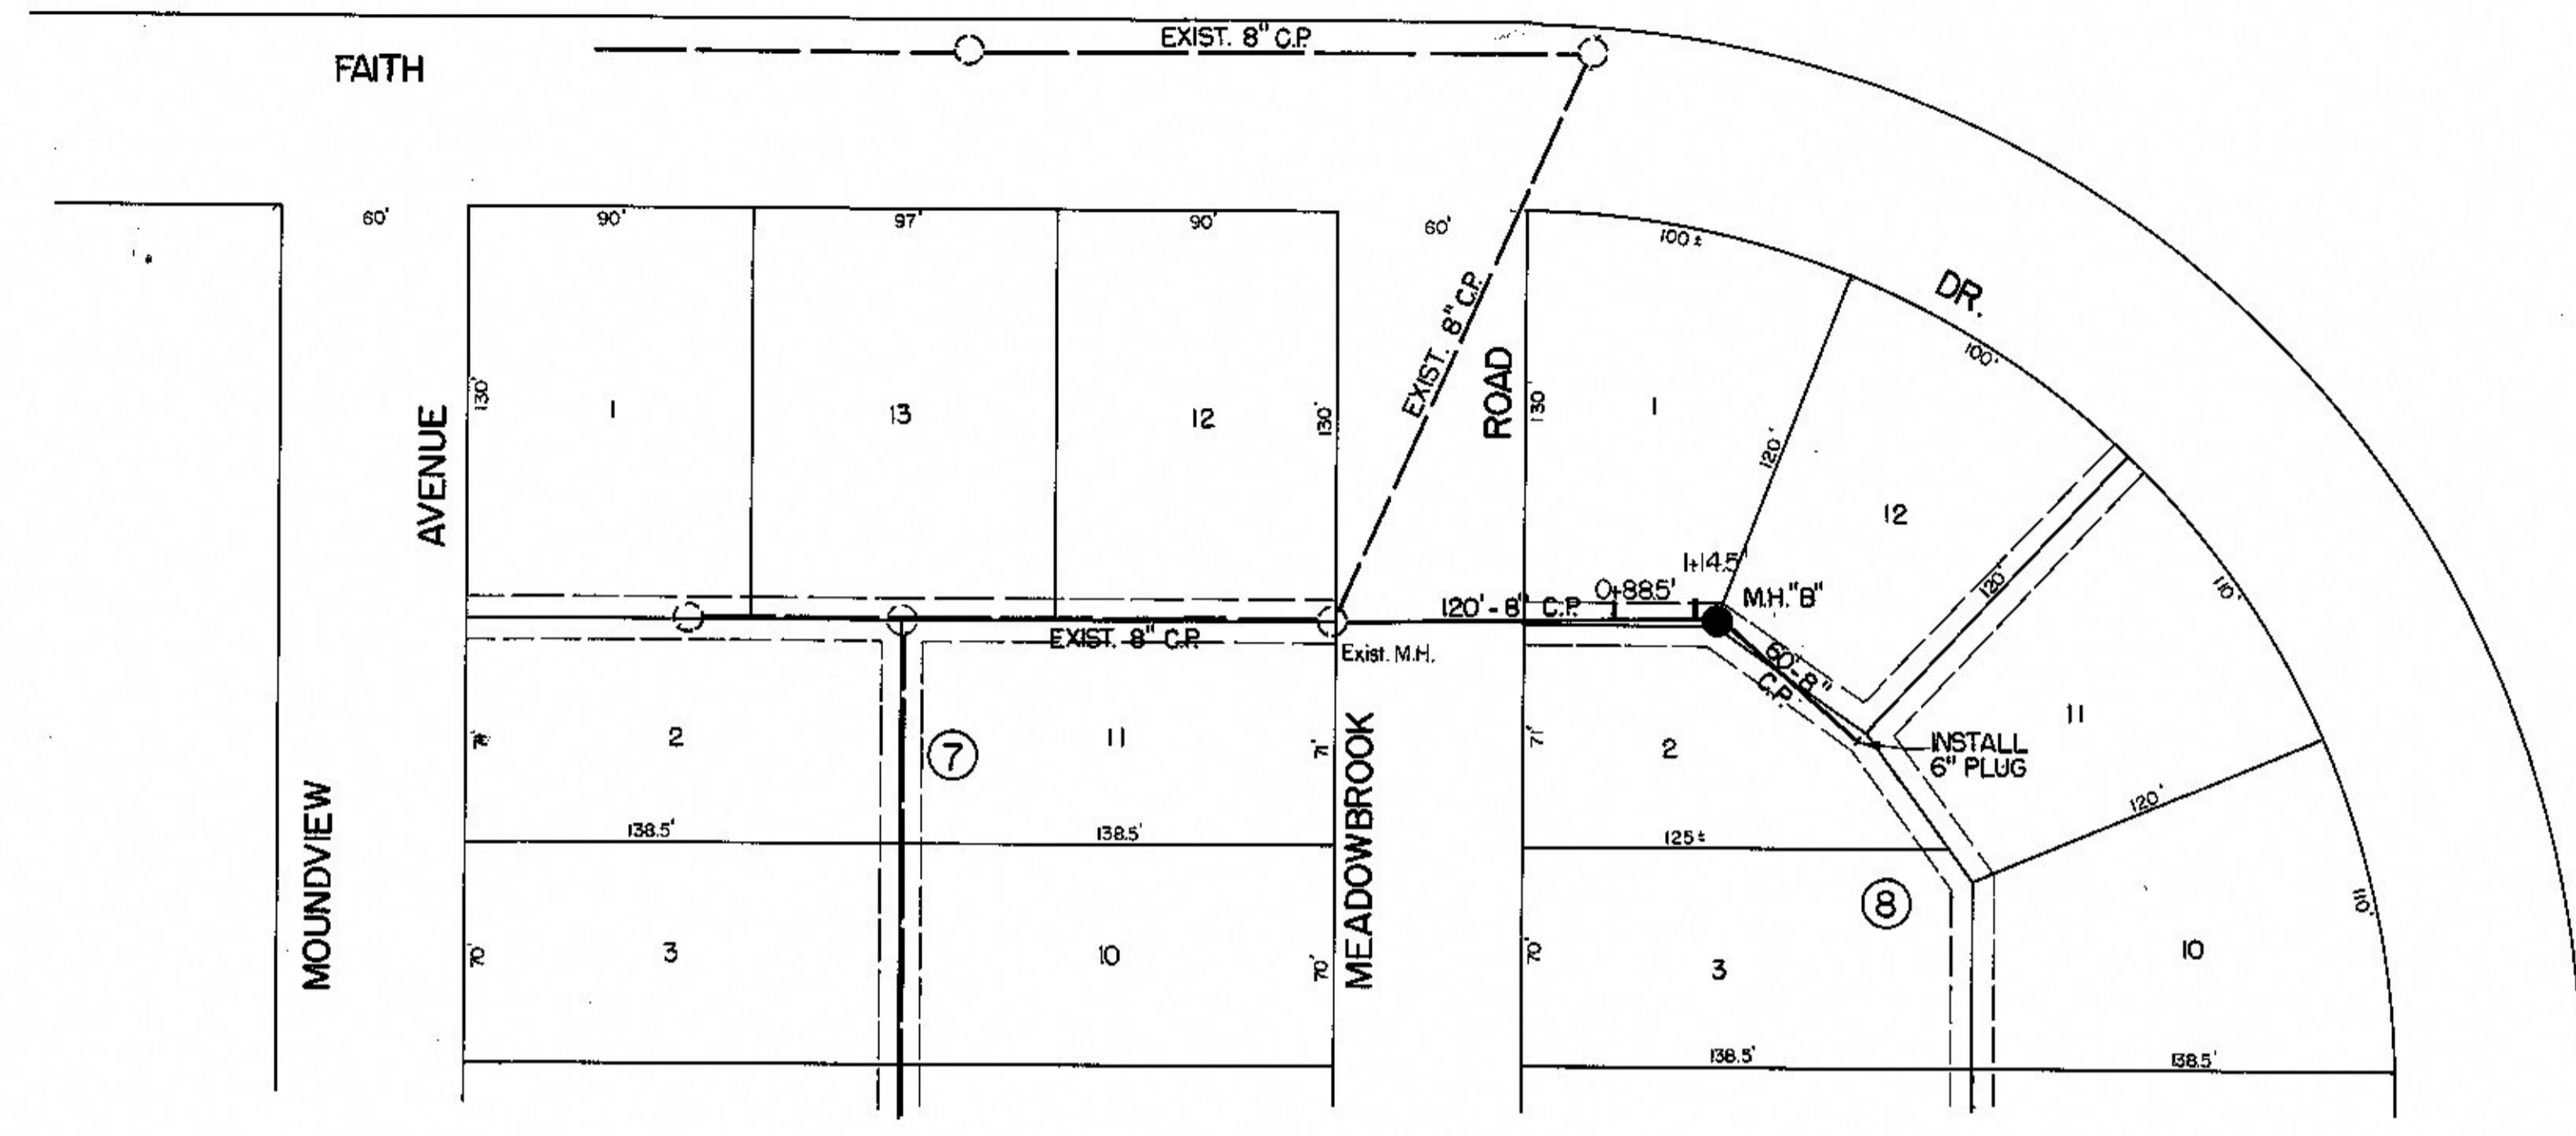