




DATE	BY
PLAN	BY
NOTE BOOK	ALPAMARK GREENS
No.	E. OF WAY ERECT

DATE	BY
PROFILE	BY
NOTE BOOK	ALPAMARK GREENS
No.	E. OF WAY ERECT

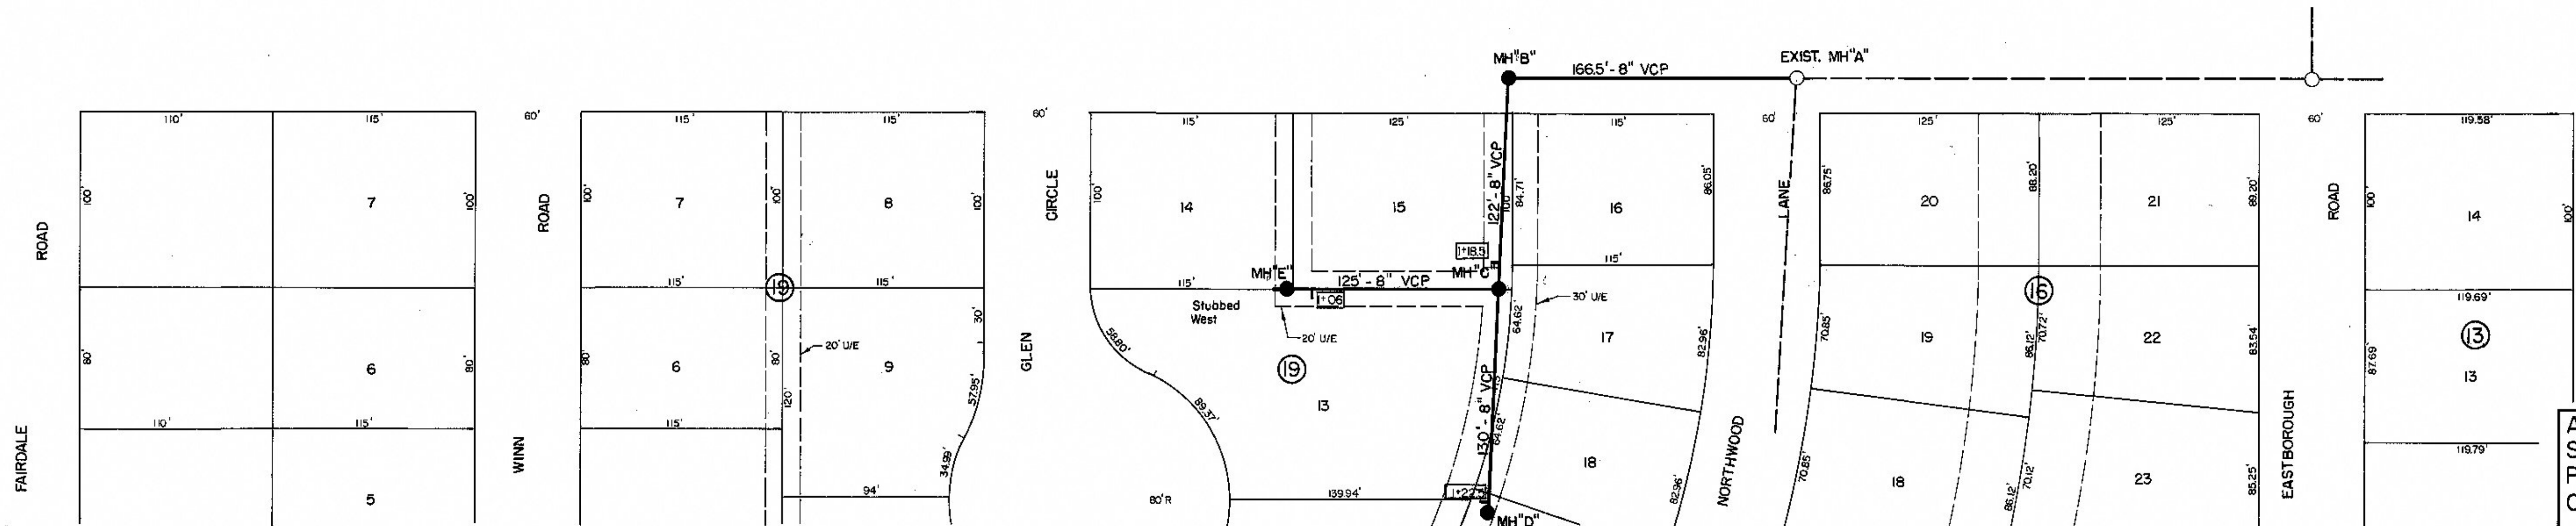

AS-BUILT PLANS  
SMOKY HILL INC.  
PROJECT NO. 76-609  
COMP DATE DEC. '76

