


PLAN
 DATE: 12/1/76
 DRAWN BY: J. W. GARDNER
 CHECKED BY: J. W. GARDNER
 PROJECT NO. 76-609
 SHEET NO. 475

PROFILE
 DATE: 12/1/76
 DRAWN BY: J. W. GARDNER
 CHECKED BY: J. W. GARDNER
 PROJECT NO. 76-609
 SHEET NO. 475

NOTE: All Tees Have 1' Riser Bends

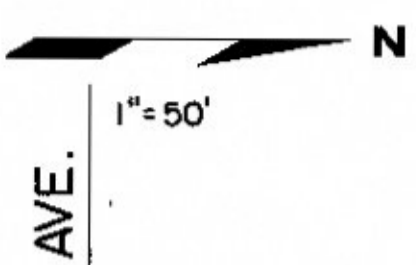

475

AS-BUILT PLANS
 SMOKY HILL INC.
 PROJECT NO. 76-609
 COMP. DATE DEC. '76

