
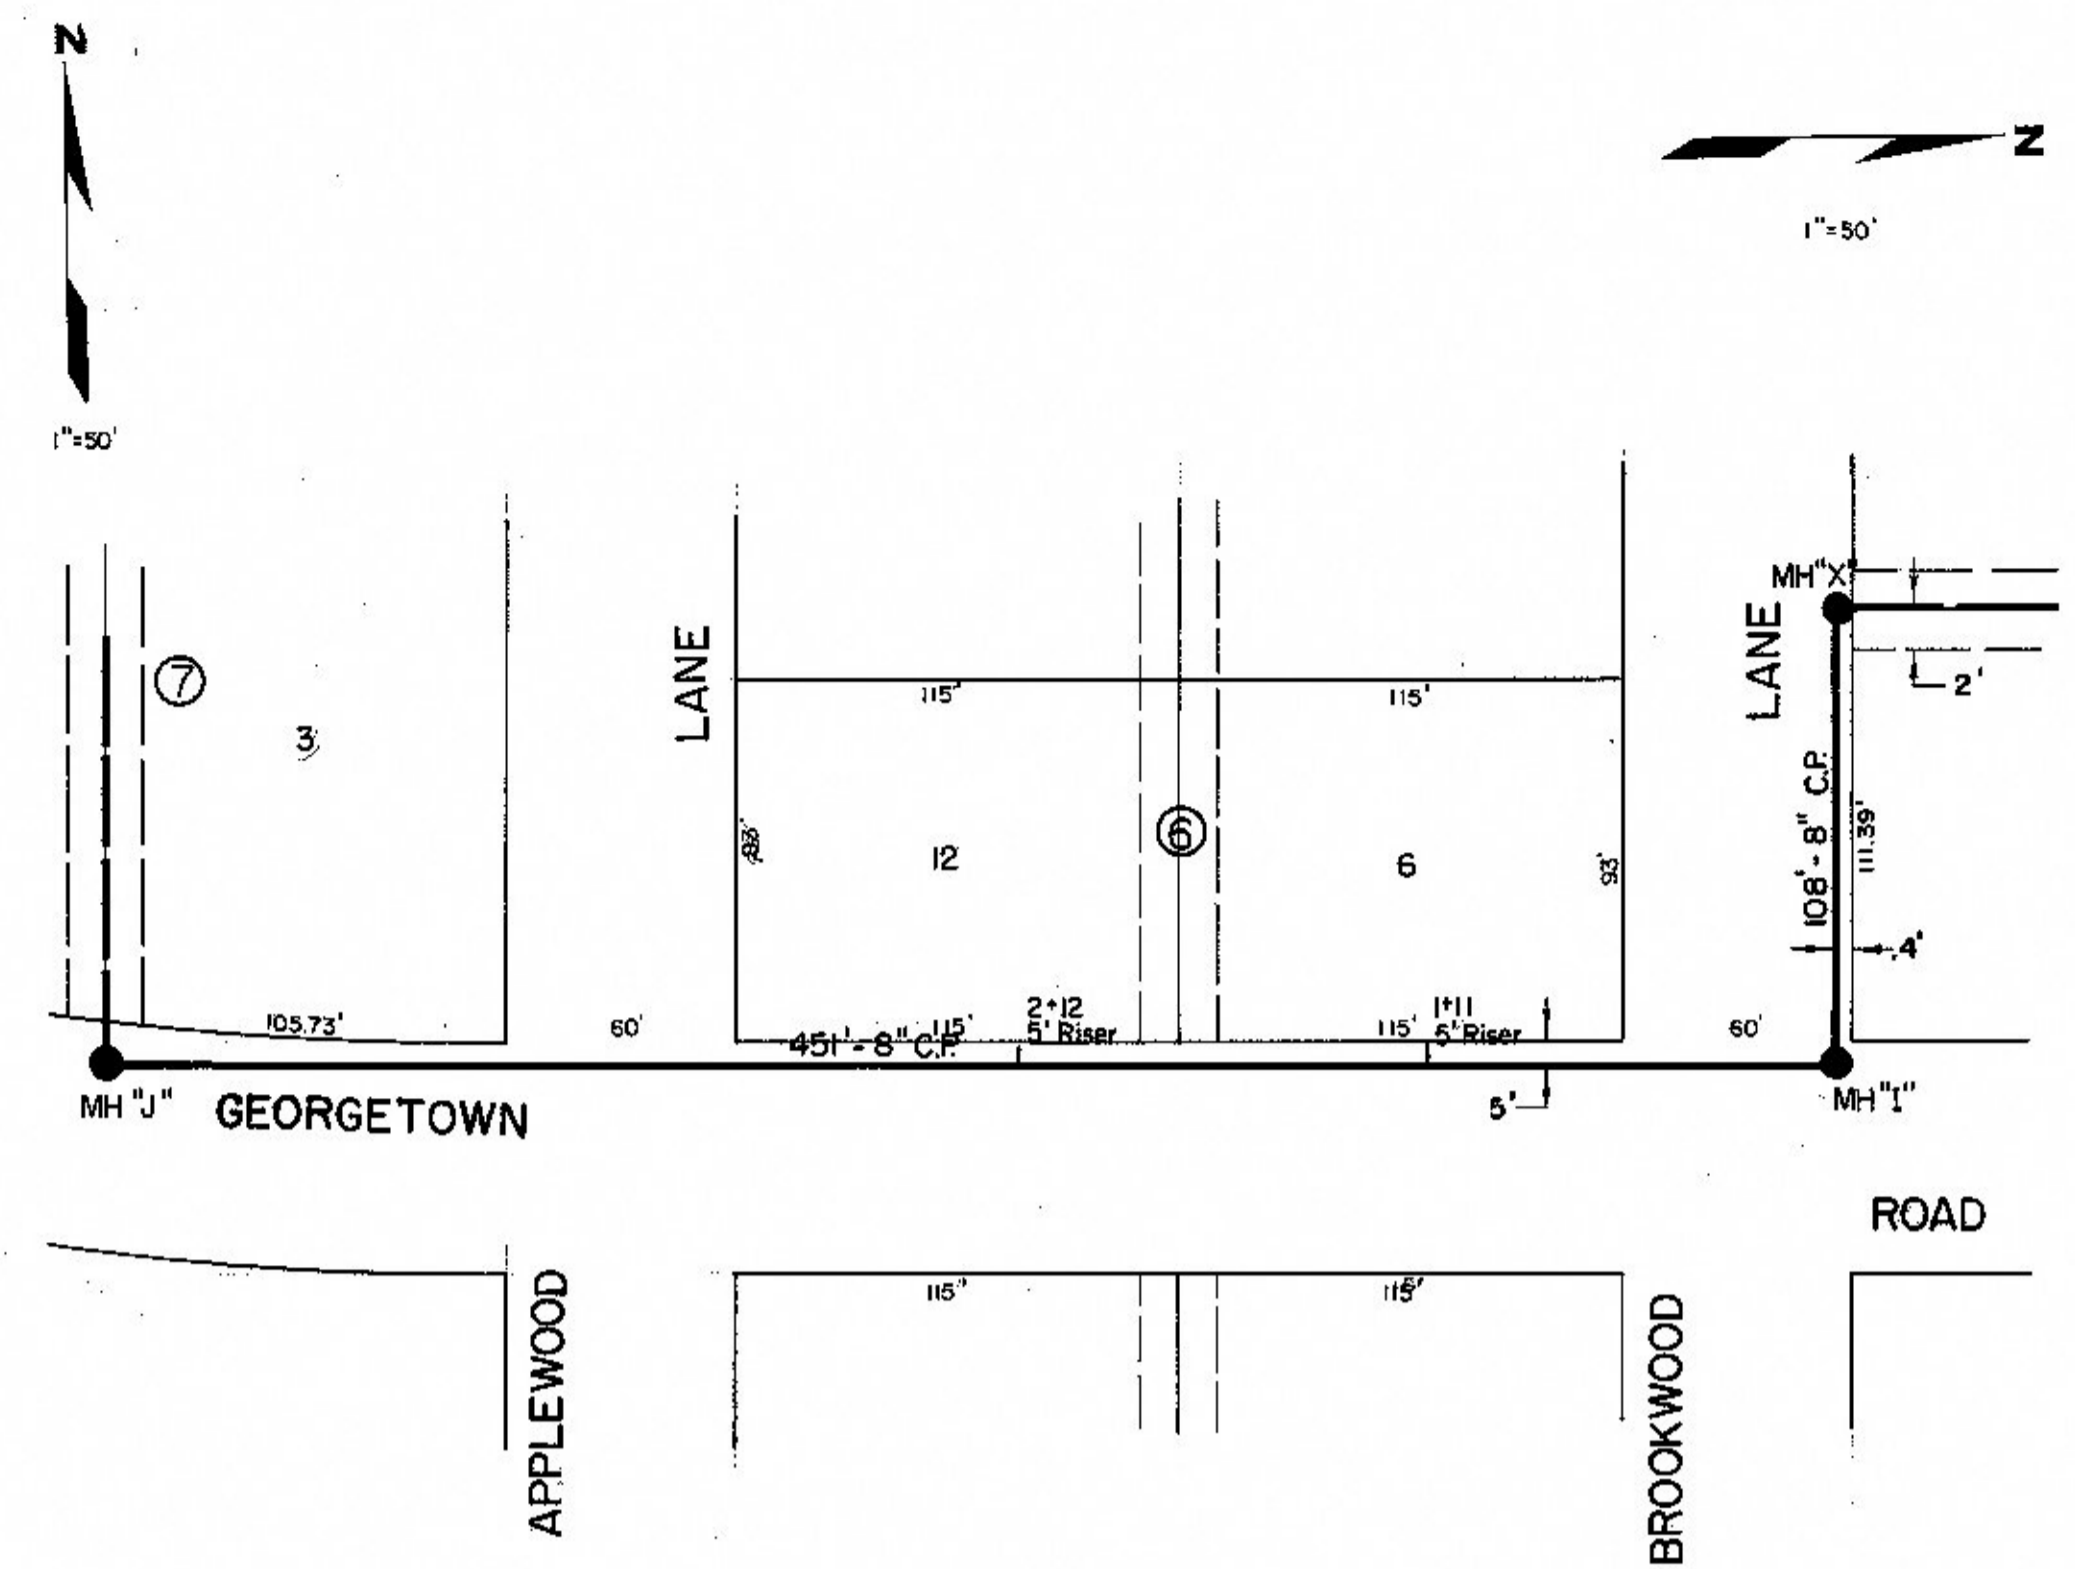


DATE: _____ BY: _____
 DRAWN BY: _____
 CHECKED BY: _____
 APPROVED BY: _____
 PROJECT NO. 76-609
 SHEET NO. 476

DATE: _____ BY: _____
 DRAWN BY: _____
 CHECKED BY: _____
 APPROVED BY: _____
 PROJECT NO. 76-609
 SHEET NO. 476

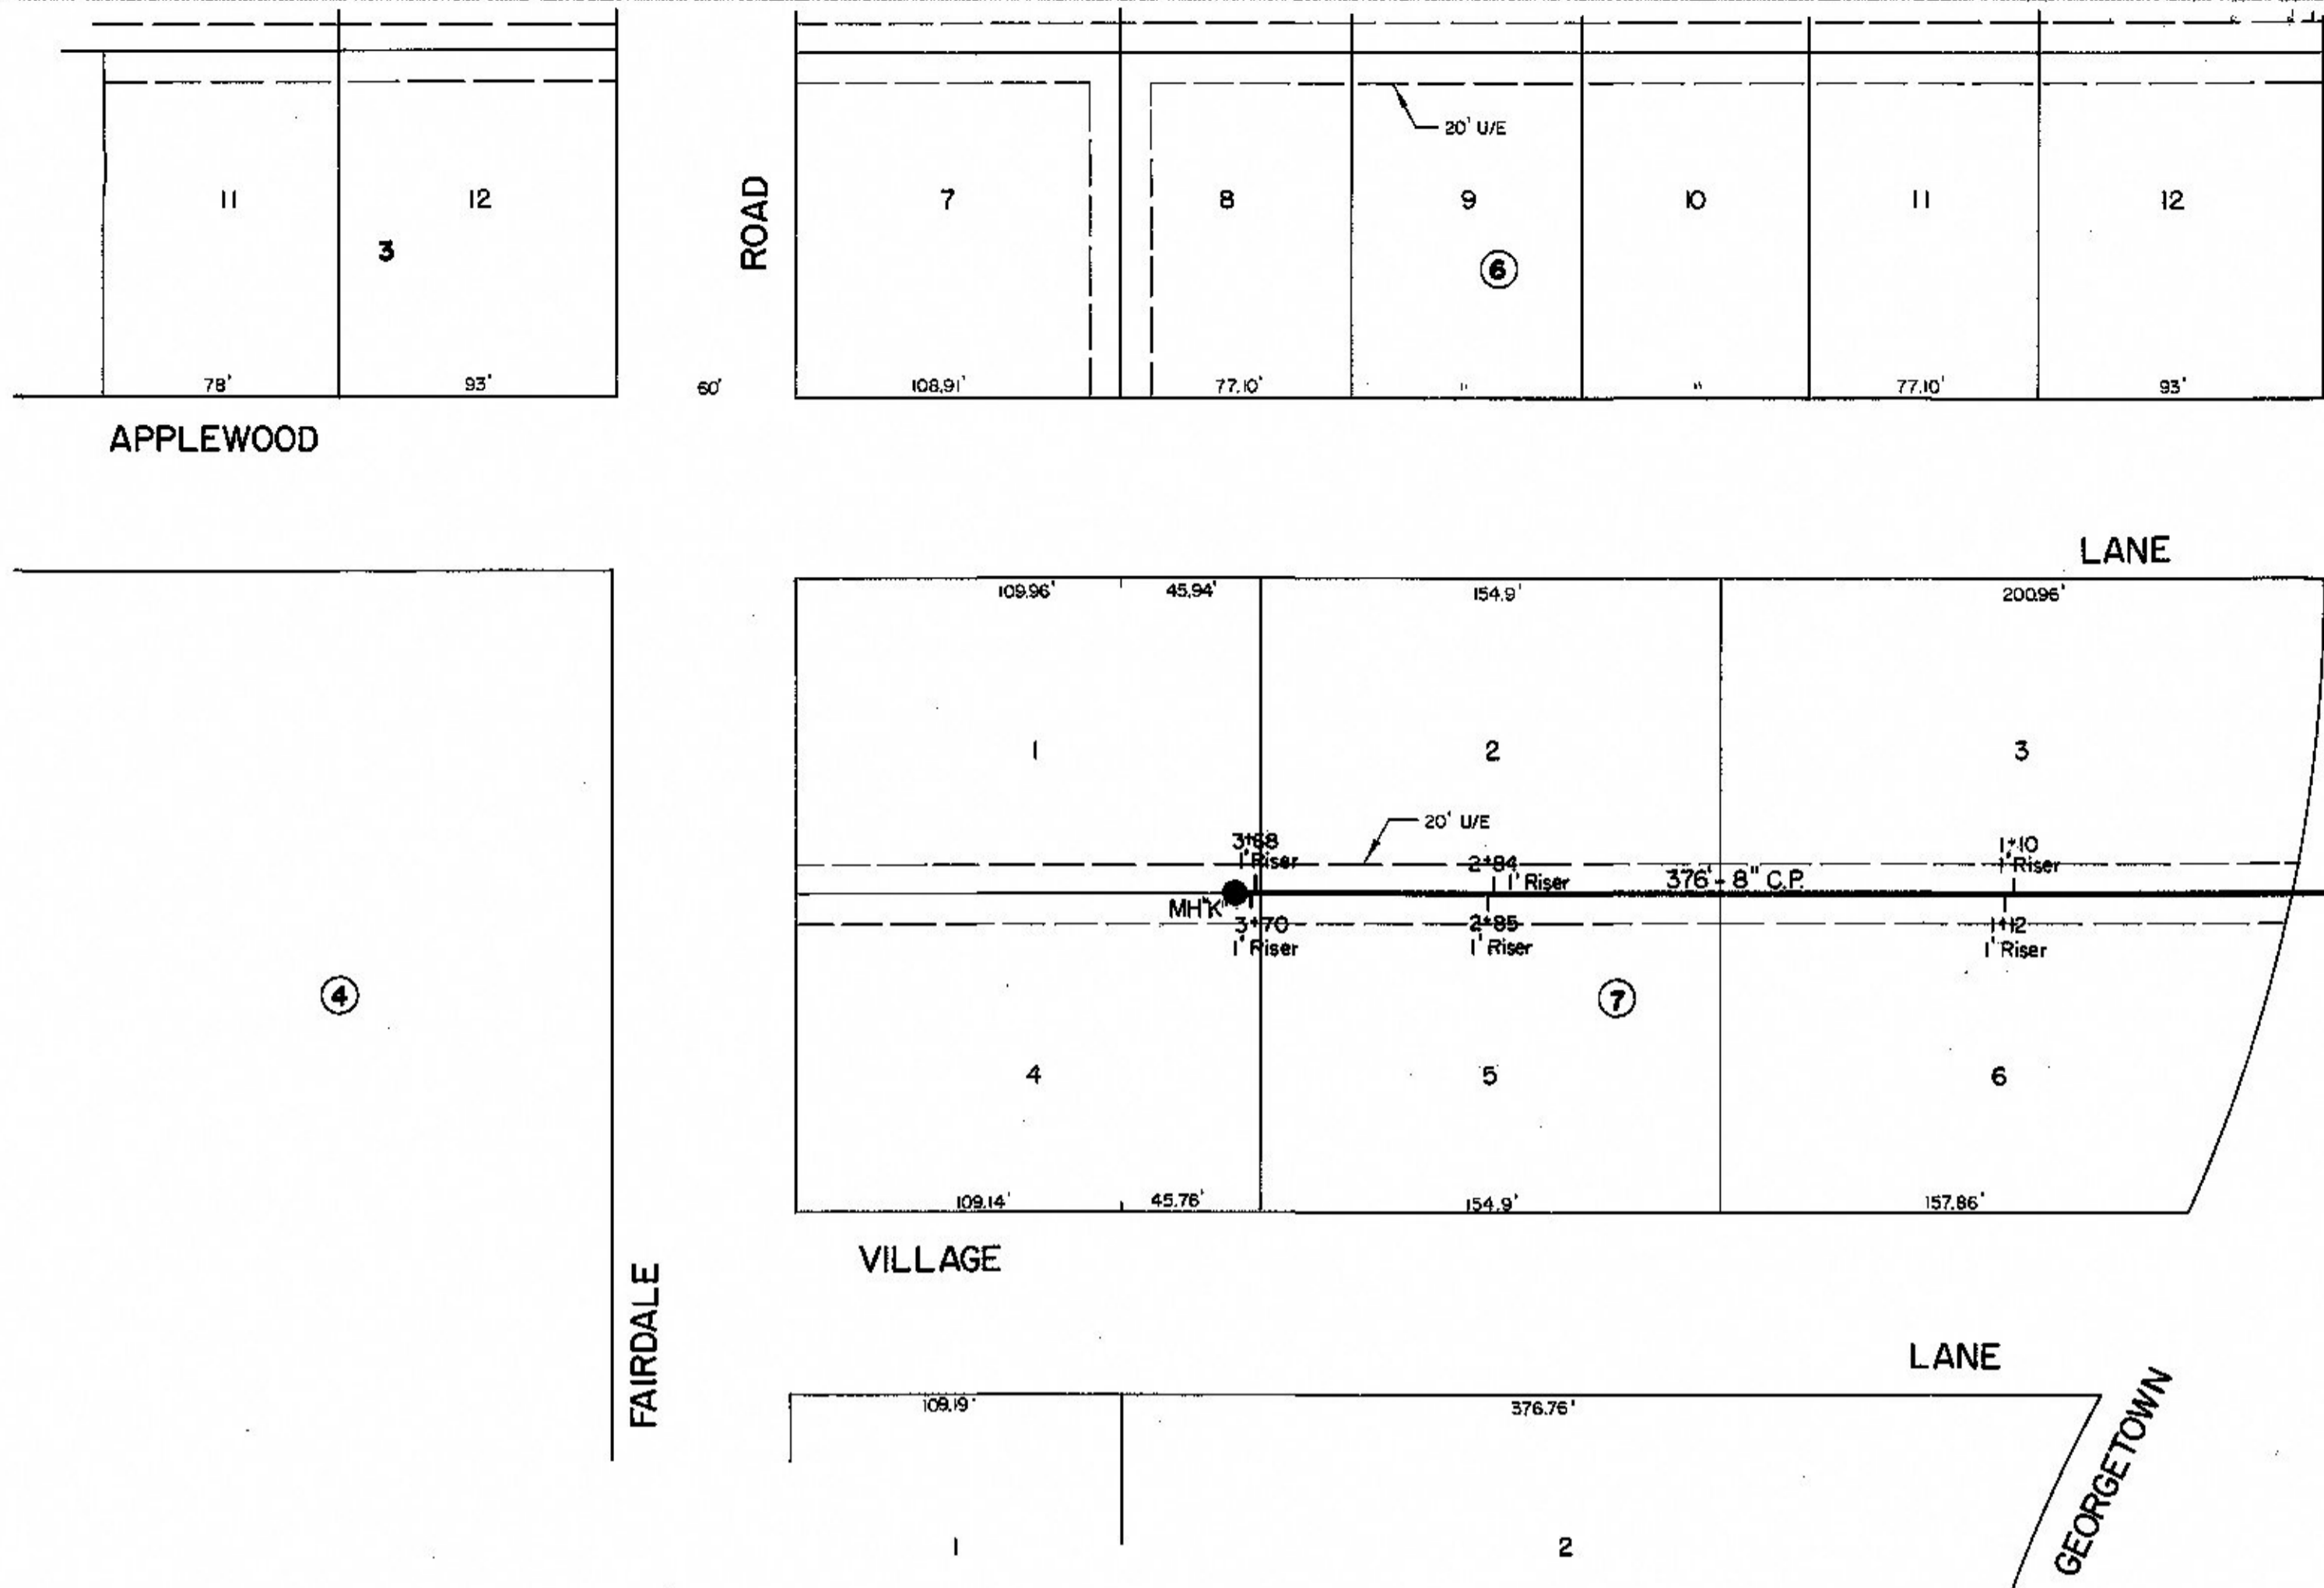

AS-BUILT PLAN
 SMOKY HILL INC.
 PROJECT NO.
 76-609
 COMP. DATE 1-77

476

