

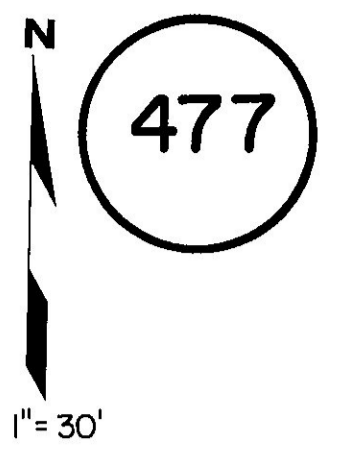
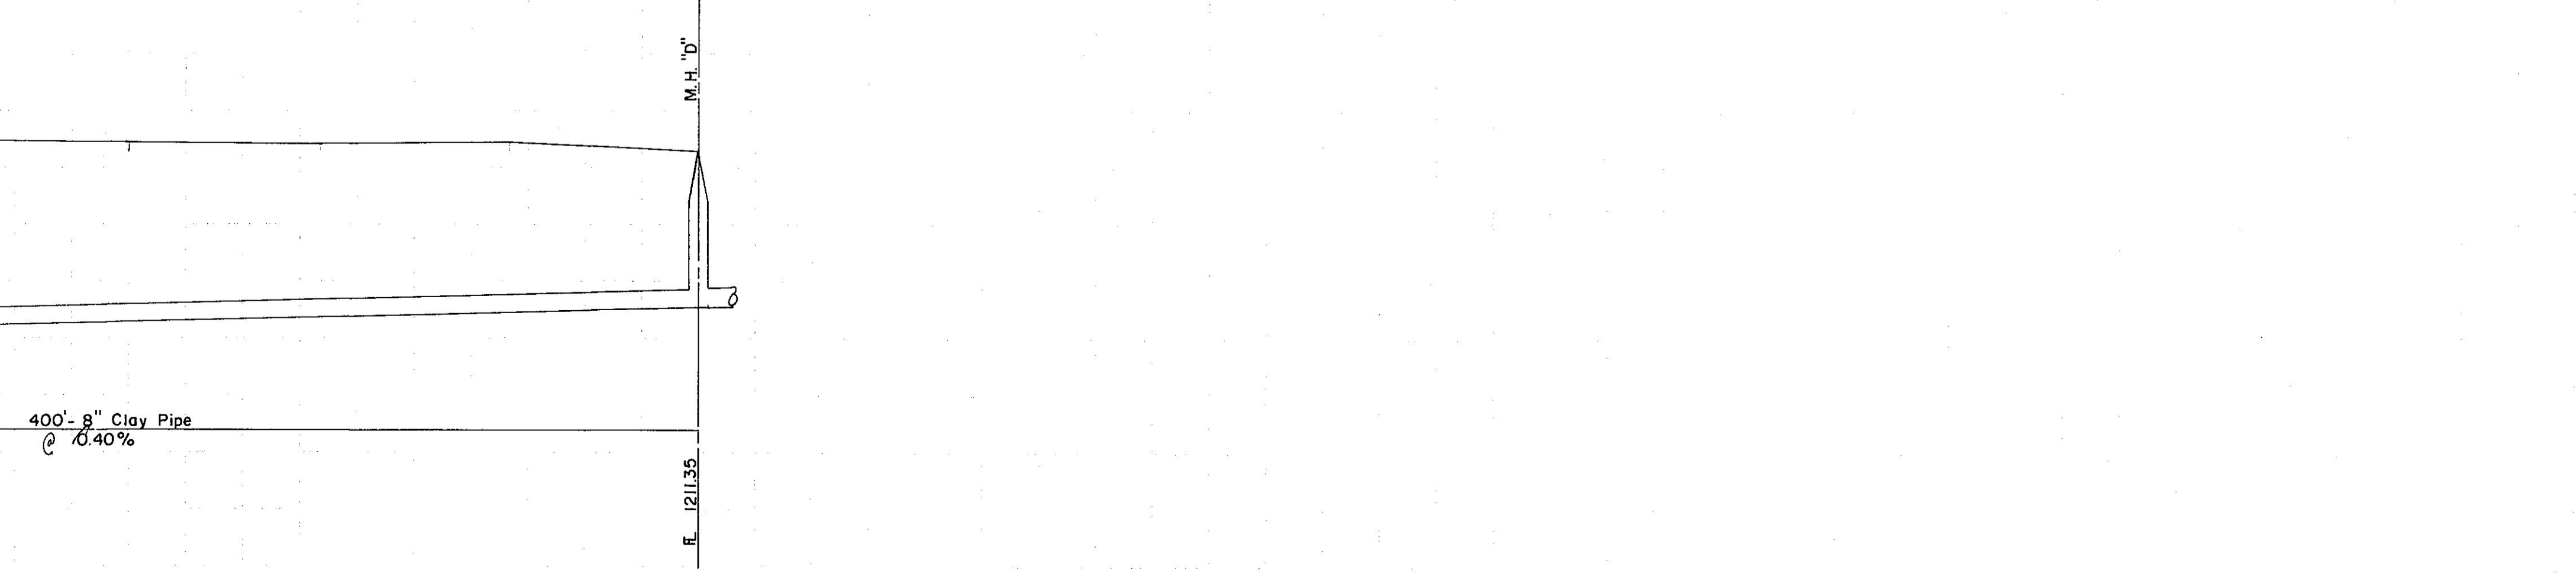
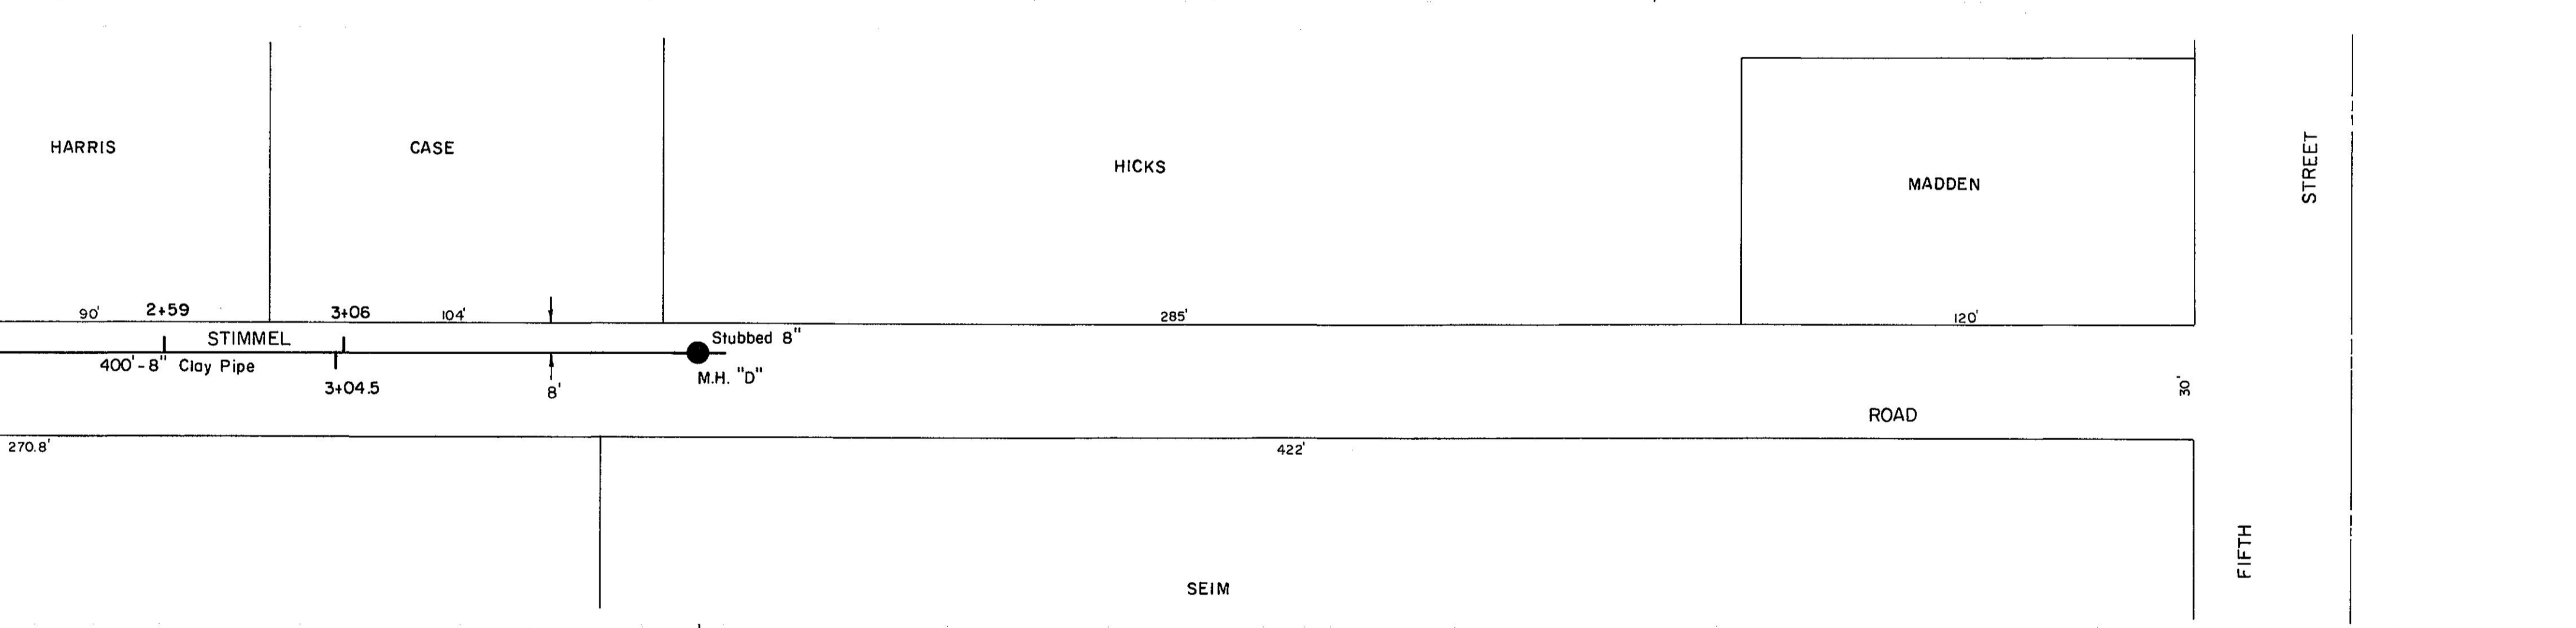
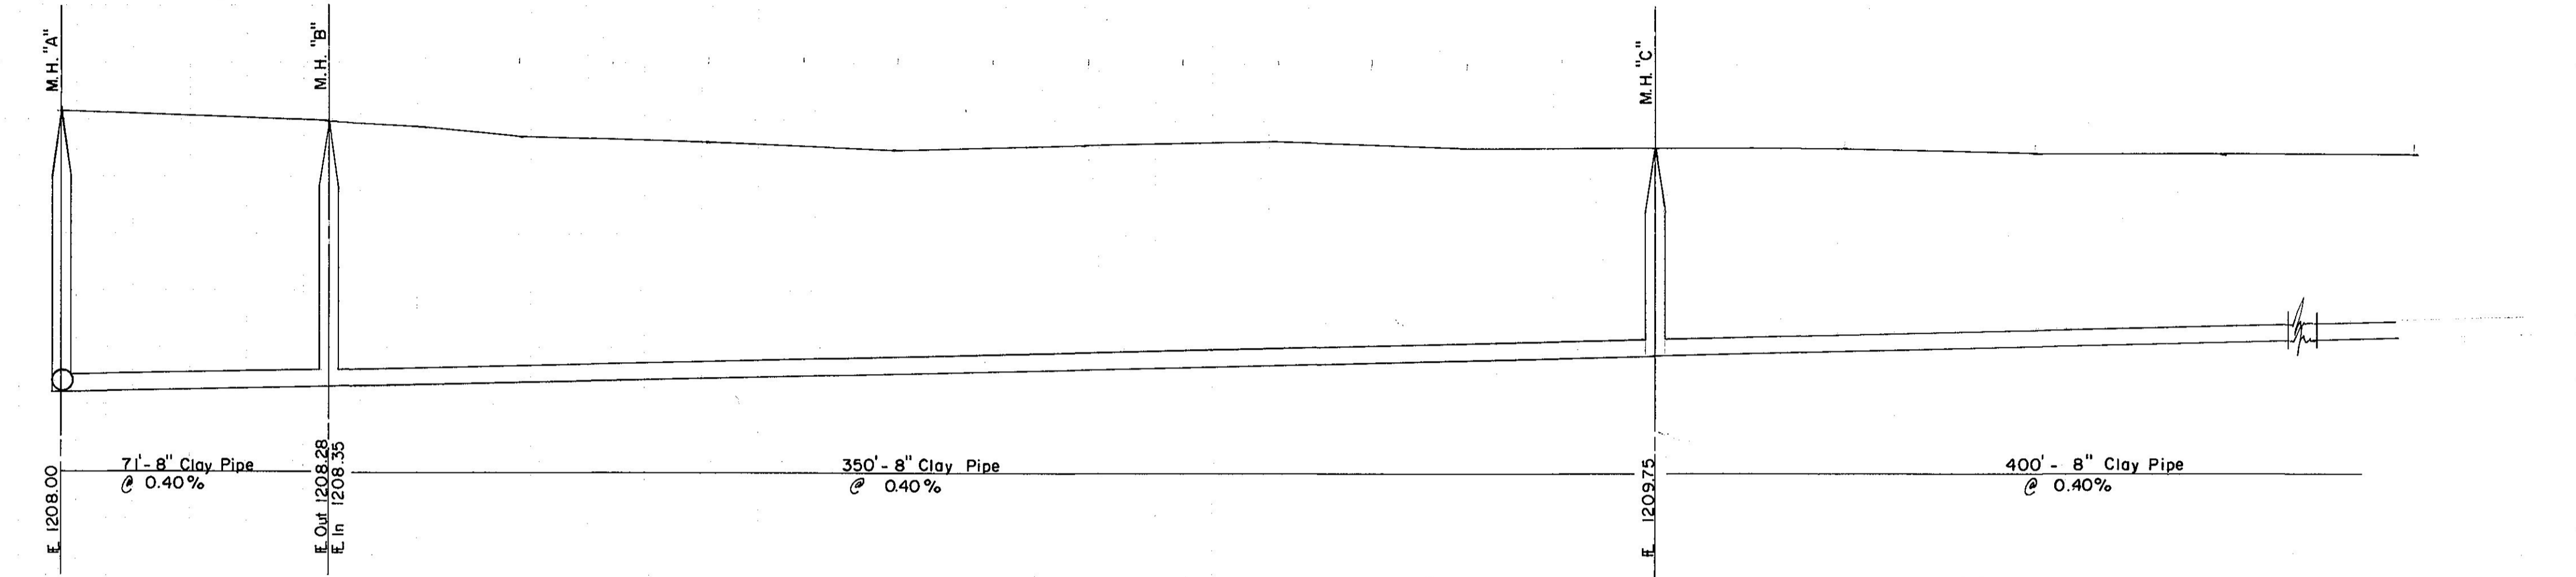


U.S. HIGHWAY 81

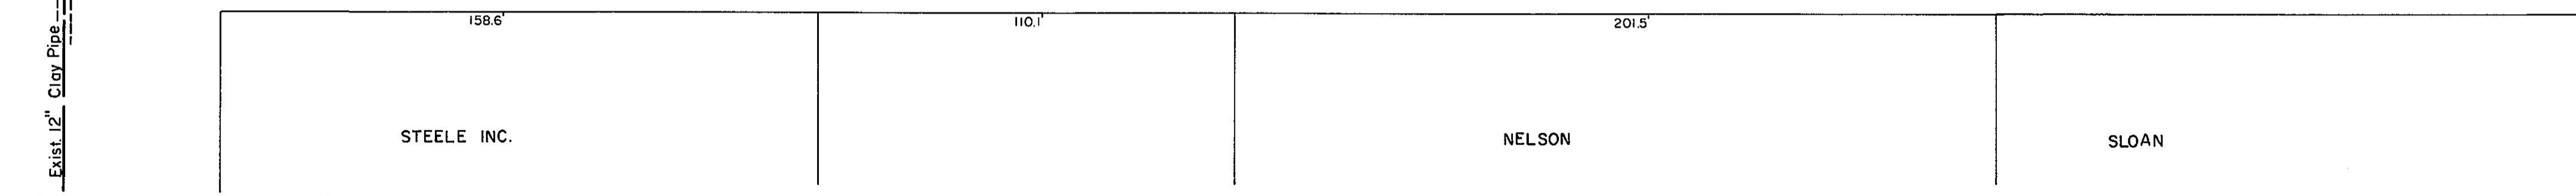

AS BUILT PLANS
SMOKY HILL INC.
FEBRUARY 1977
PROJECT NO. 76-612

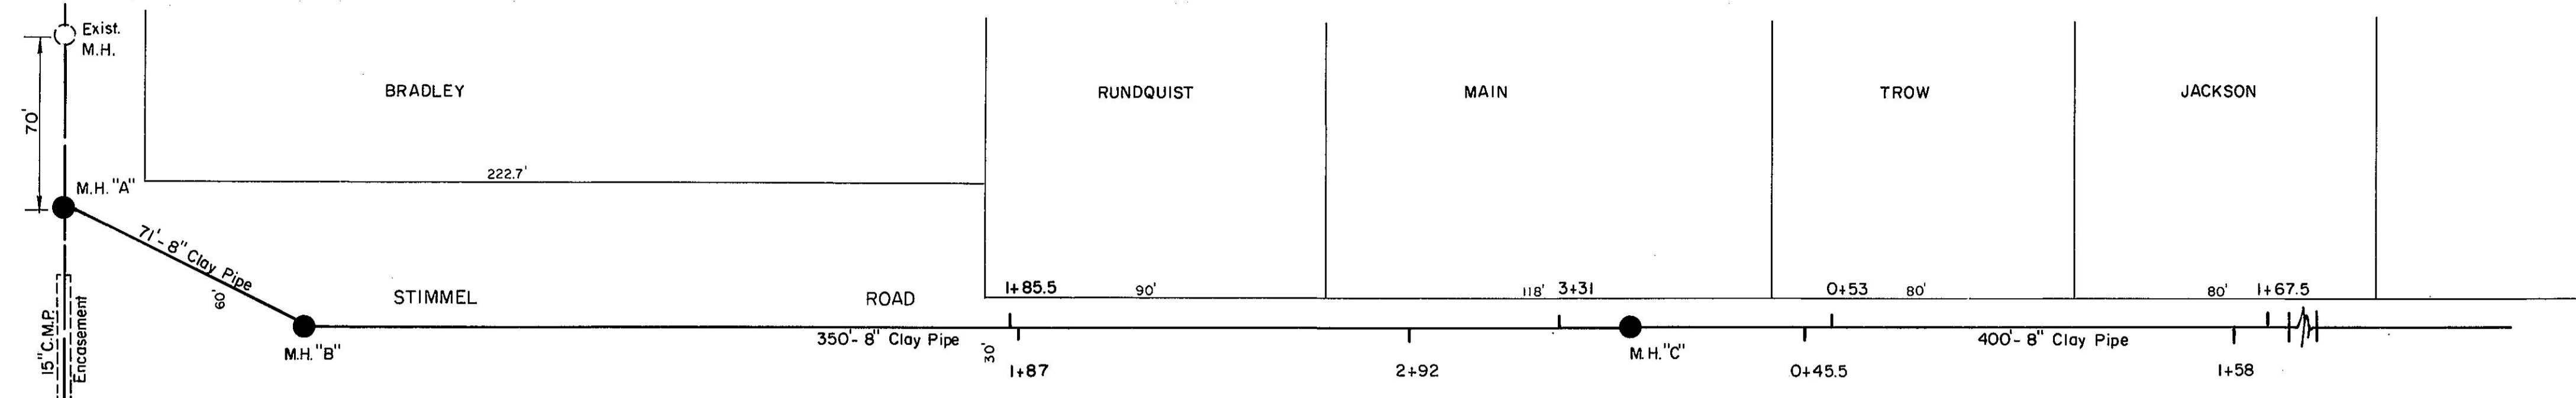

1220
1215
1210
1205

1220
1215
1210
1205