


PLAN
 DATE: _____ BY: _____
 DRAWN BY: _____
 CHECKED BY: _____
 PROJECT NO.: _____
 SHEET NO.: _____

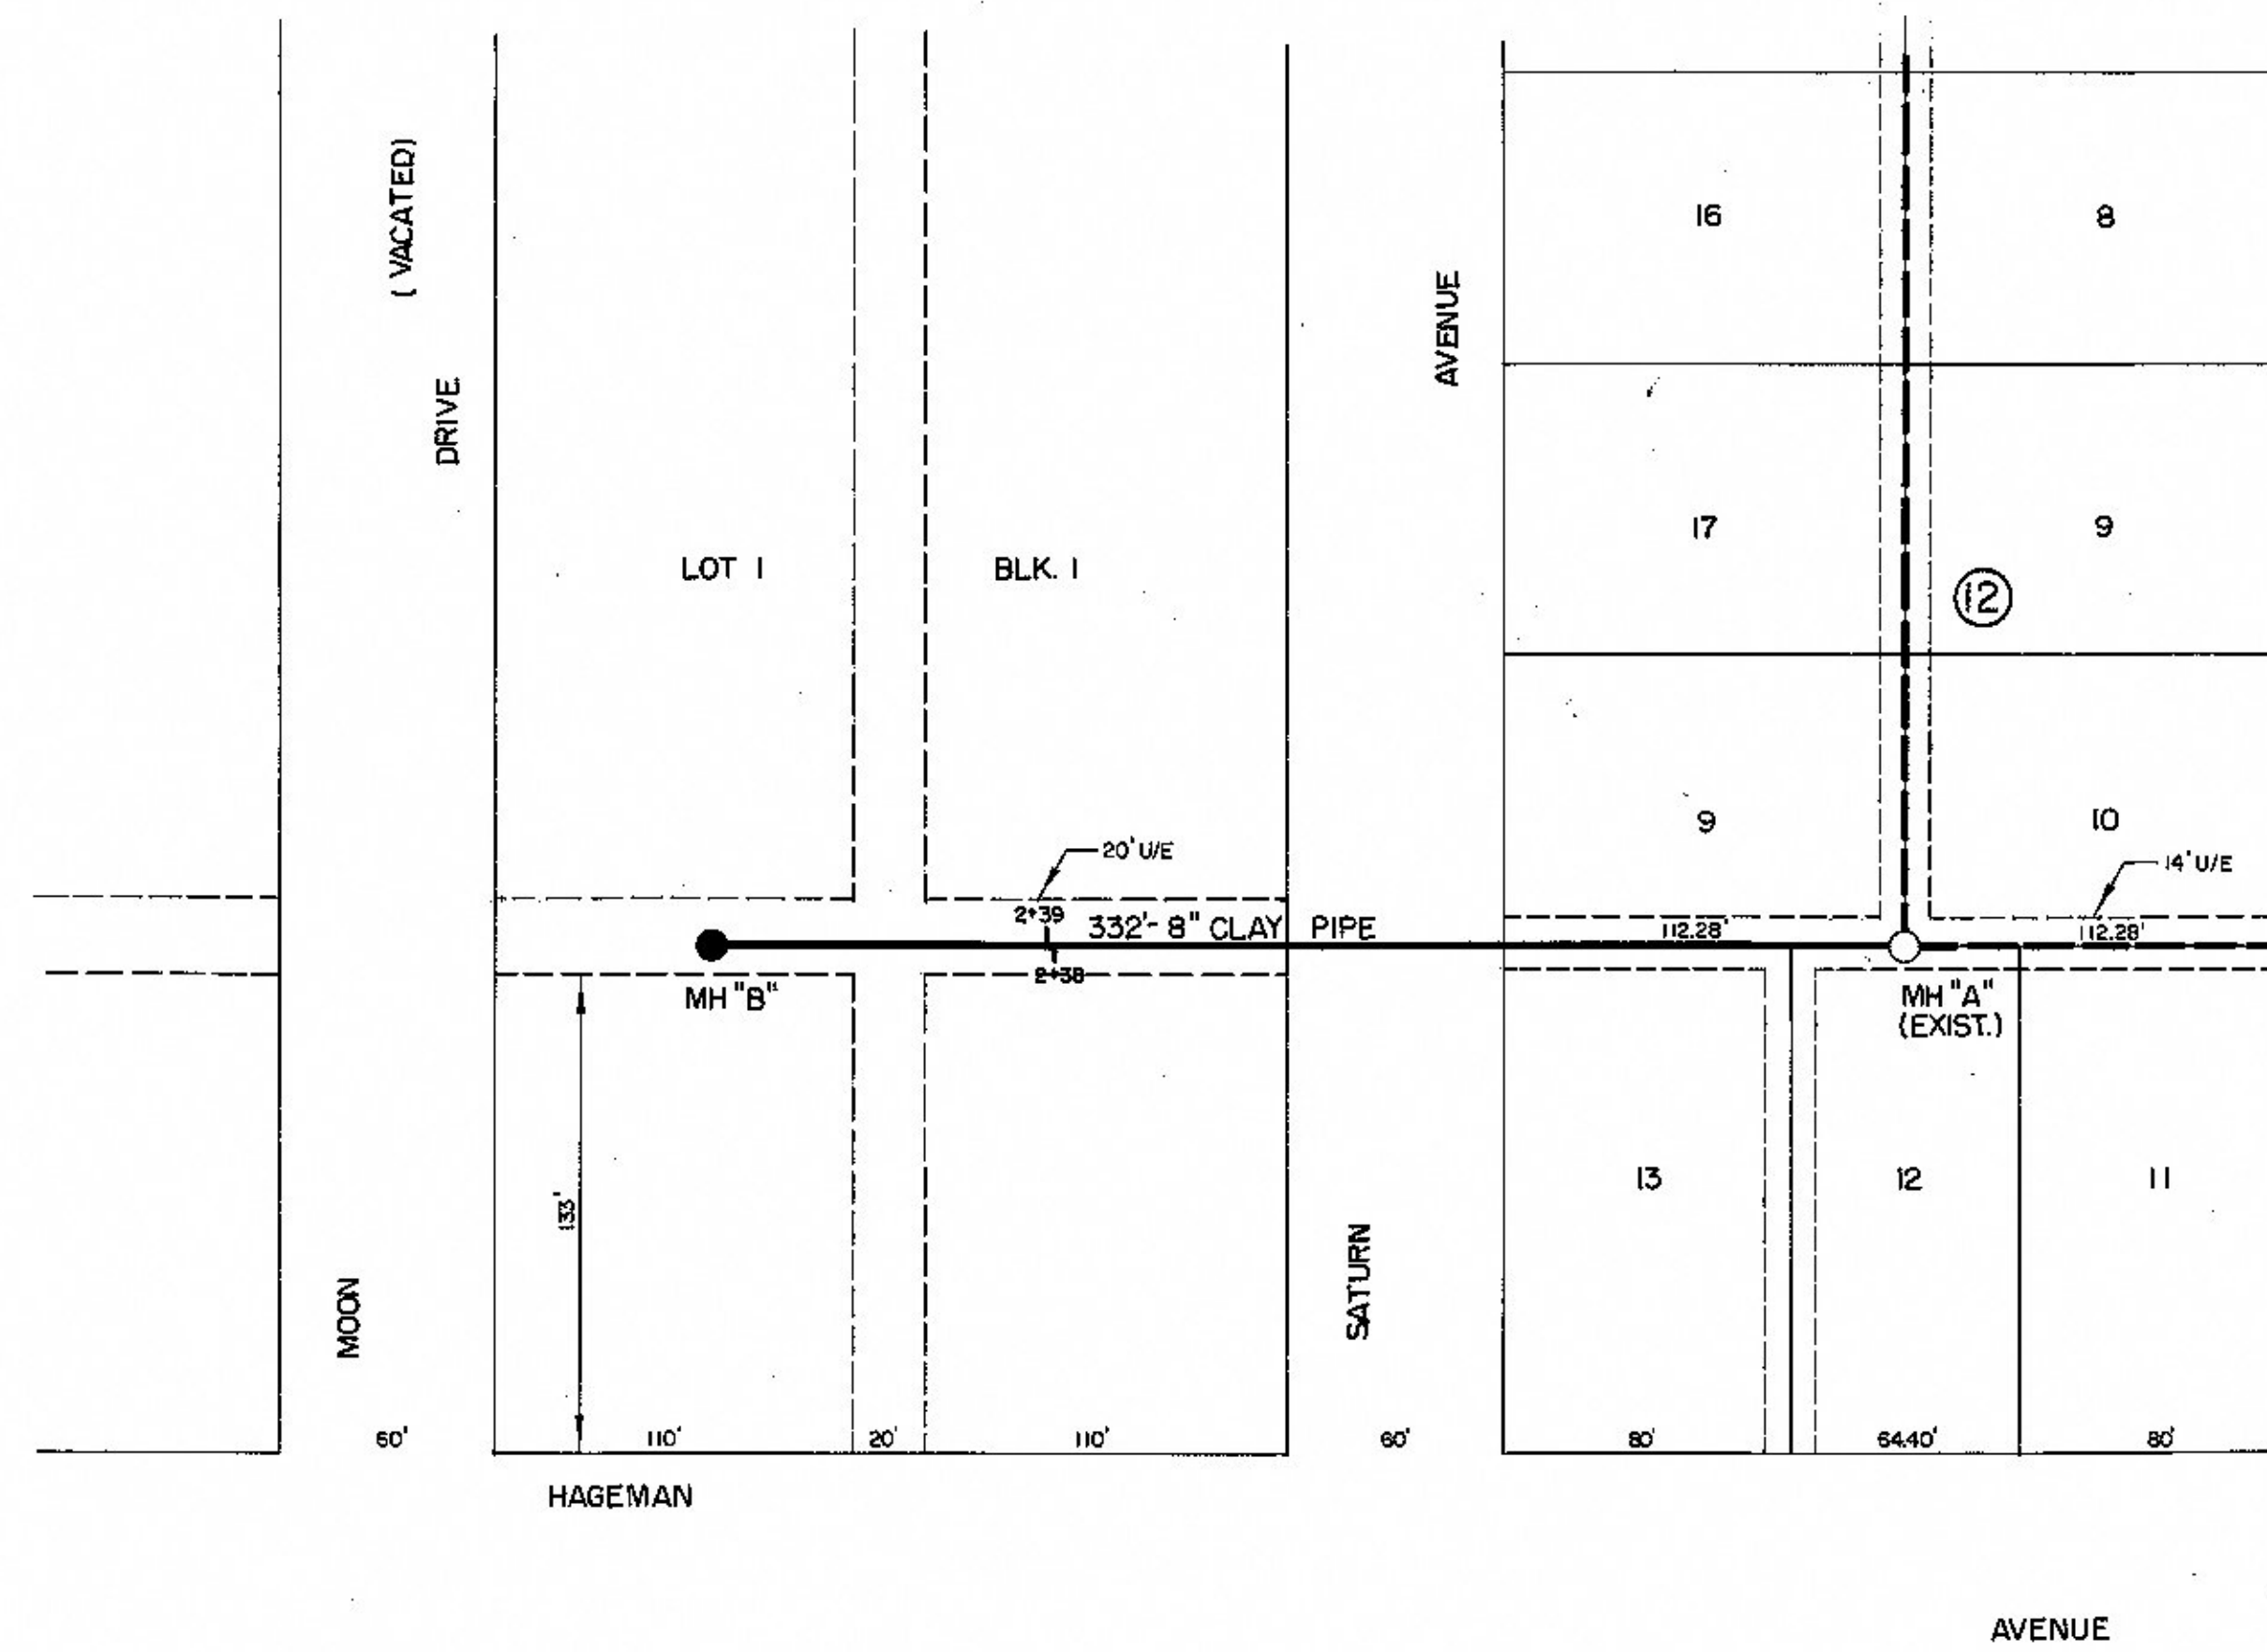

478

AS-BUILT PLANS
 SMOKY HILL, INC.
 COMP. DATE: MAY '77
 PROJ. NO. 77-617

PROFILE
 DATE: _____ BY: _____
 DRAWN BY: _____
 CHECKED BY: _____
 PROJECT NO.: _____
 SHEET NO.: _____

