

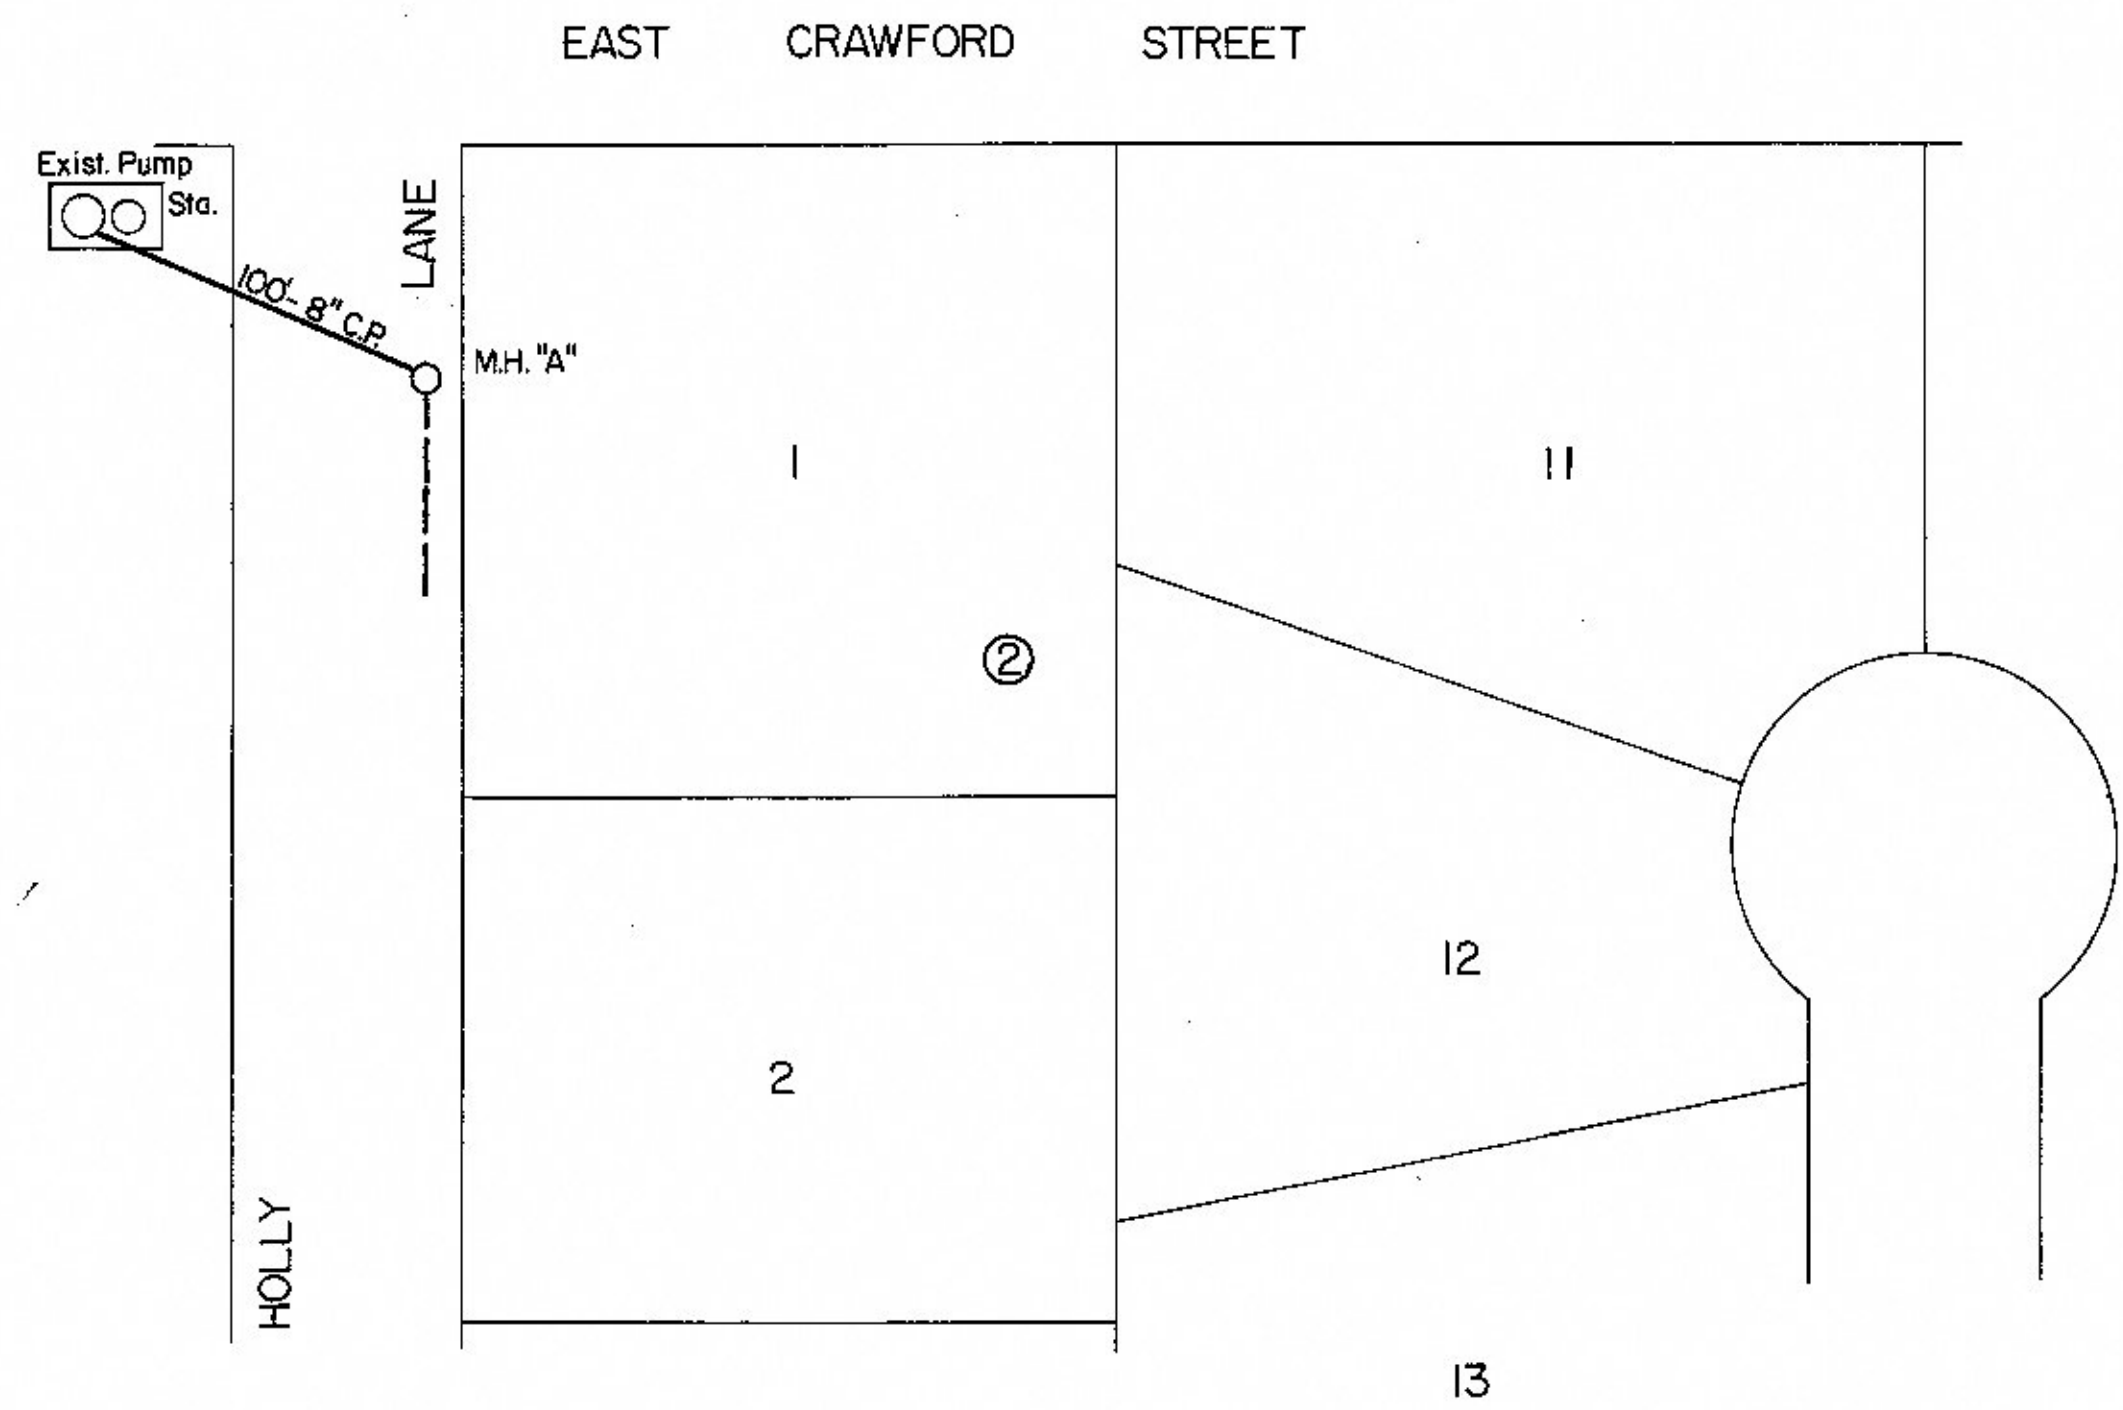


PLAN	DESIGN	DATE
NOTE BOOK	NO. OF SHEETS	DATE

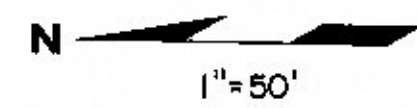

AS BUILT PLANS  
 PROJECT NO. 77-613  
 SMOKY HILL INC.  
 COMP. DATE: June 1977

PROFILE	DATE
NOTE BOOK	DATE

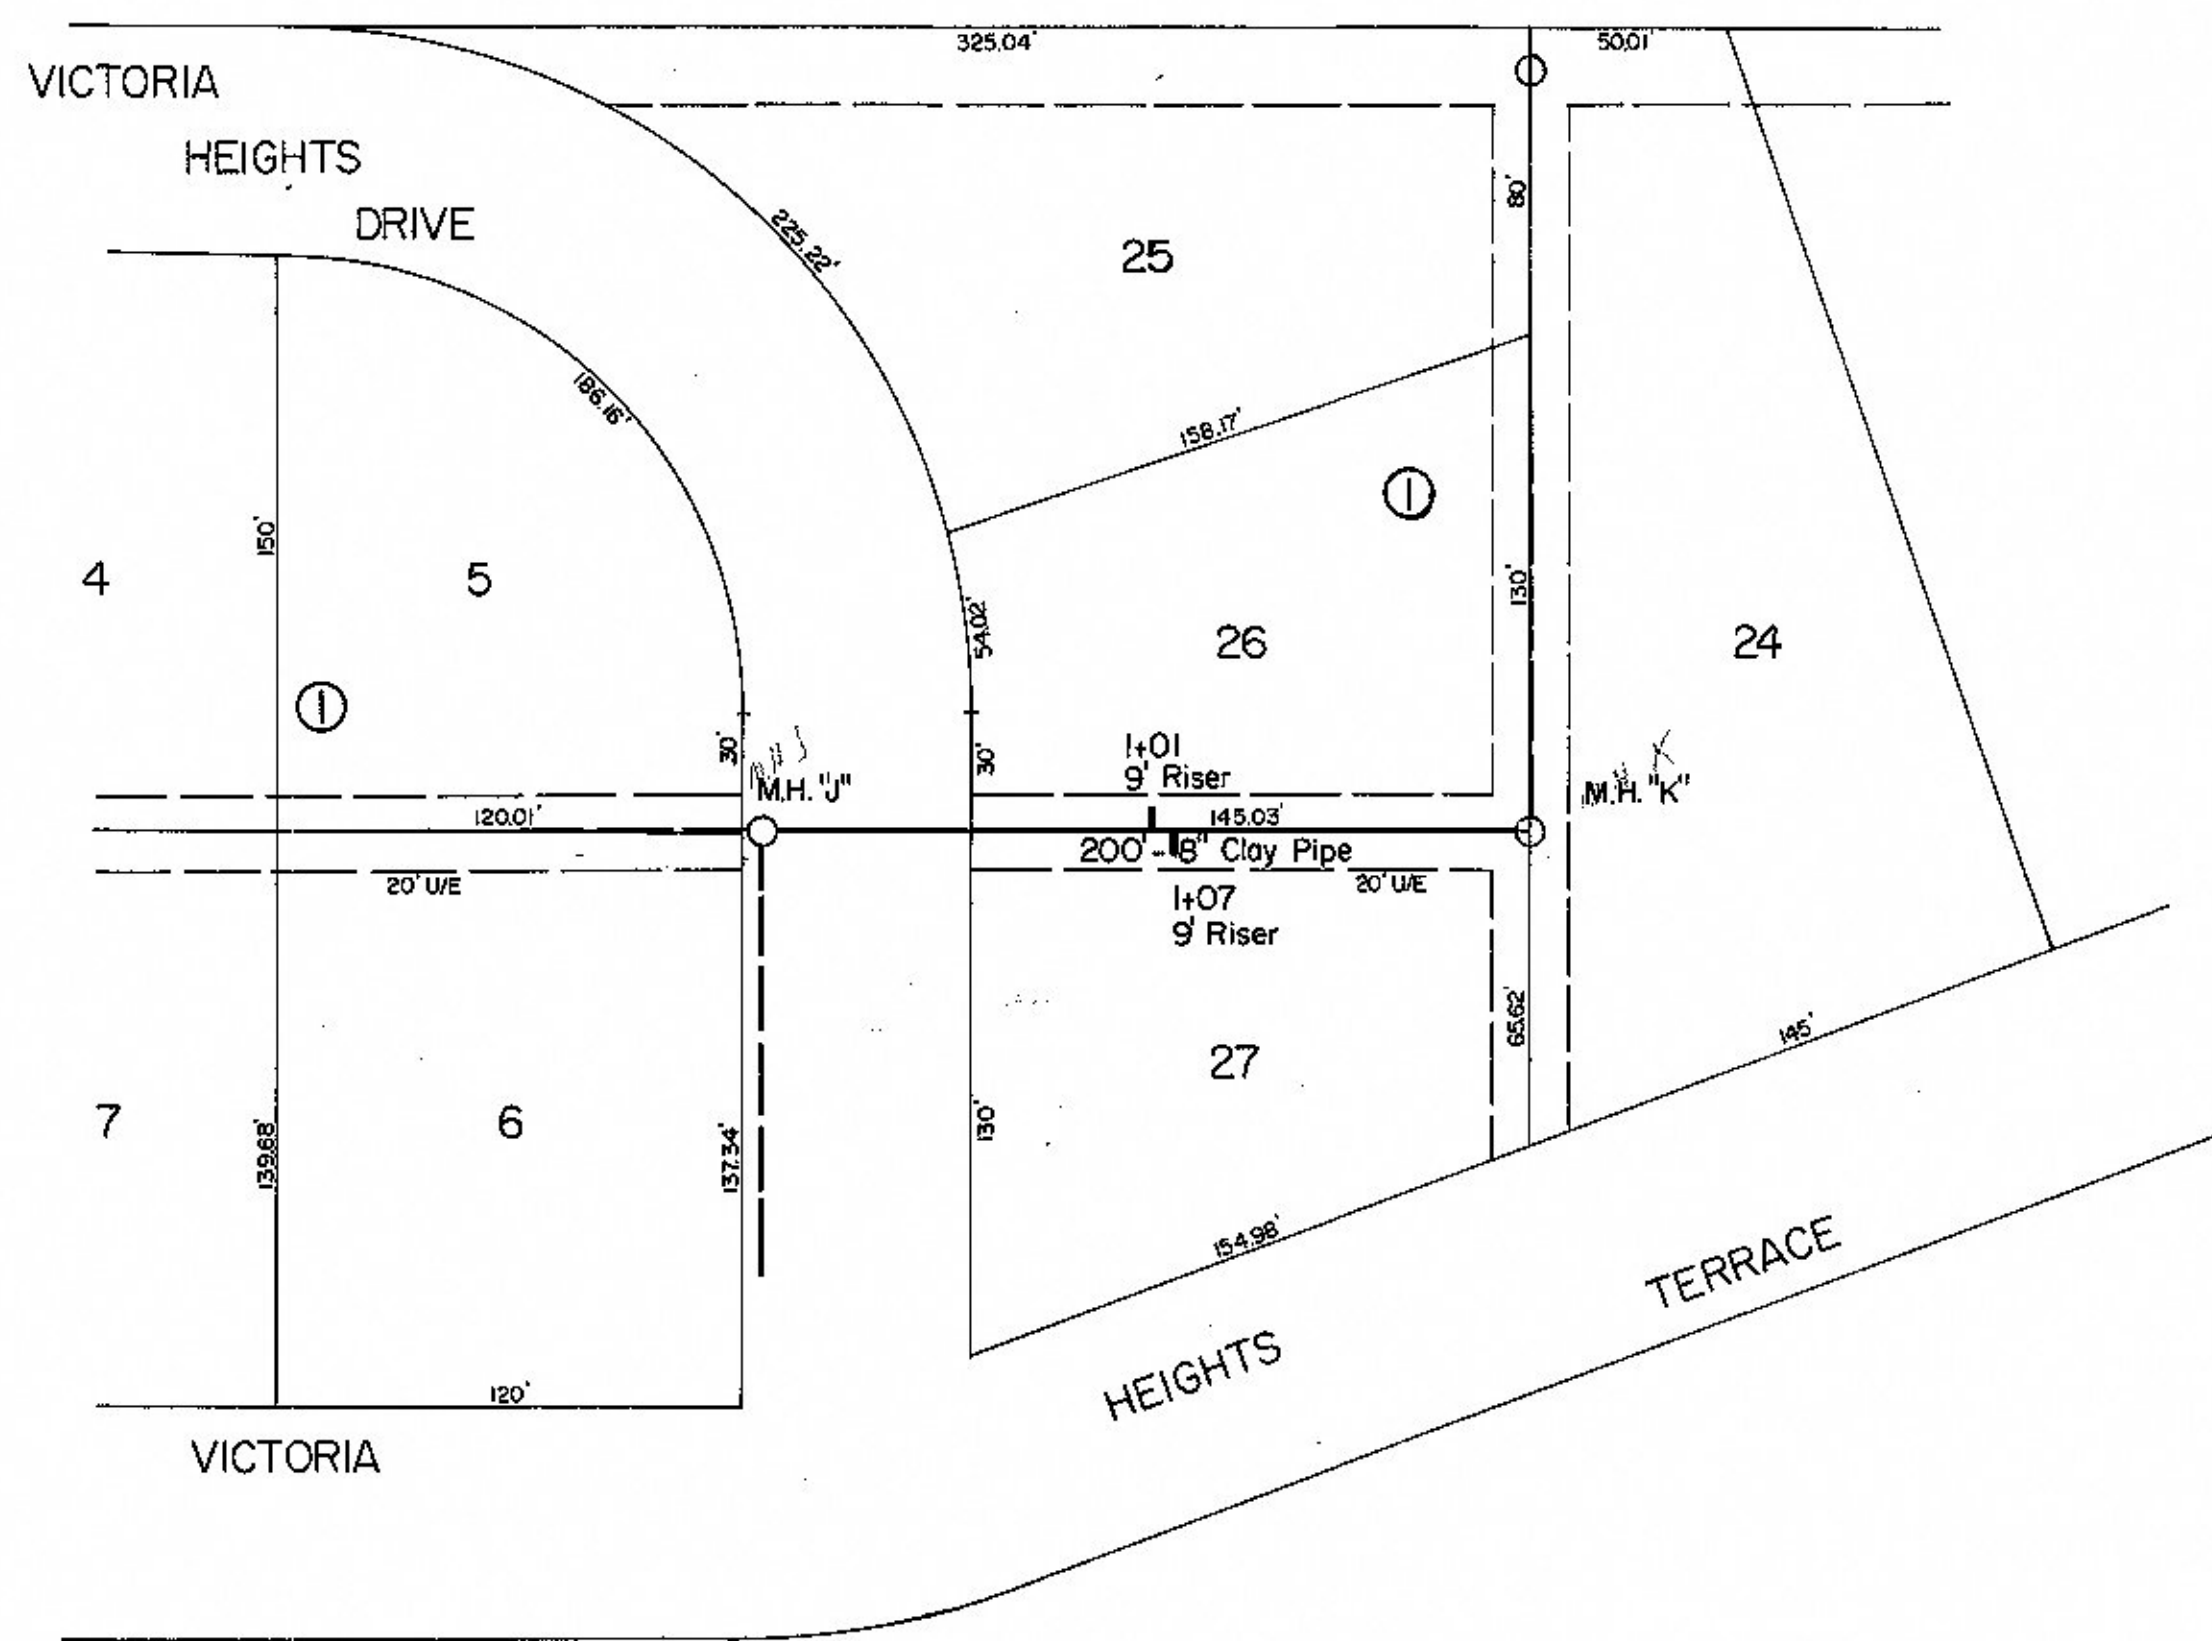