
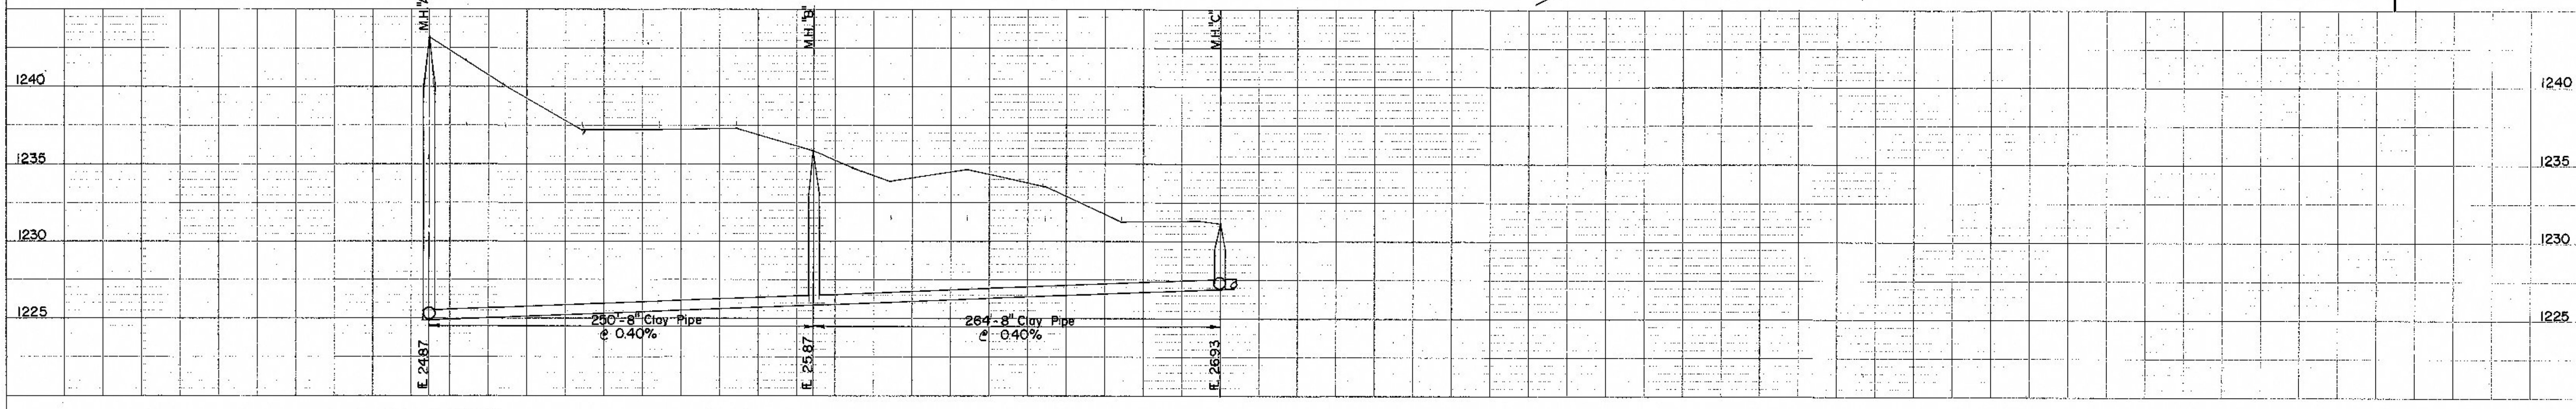
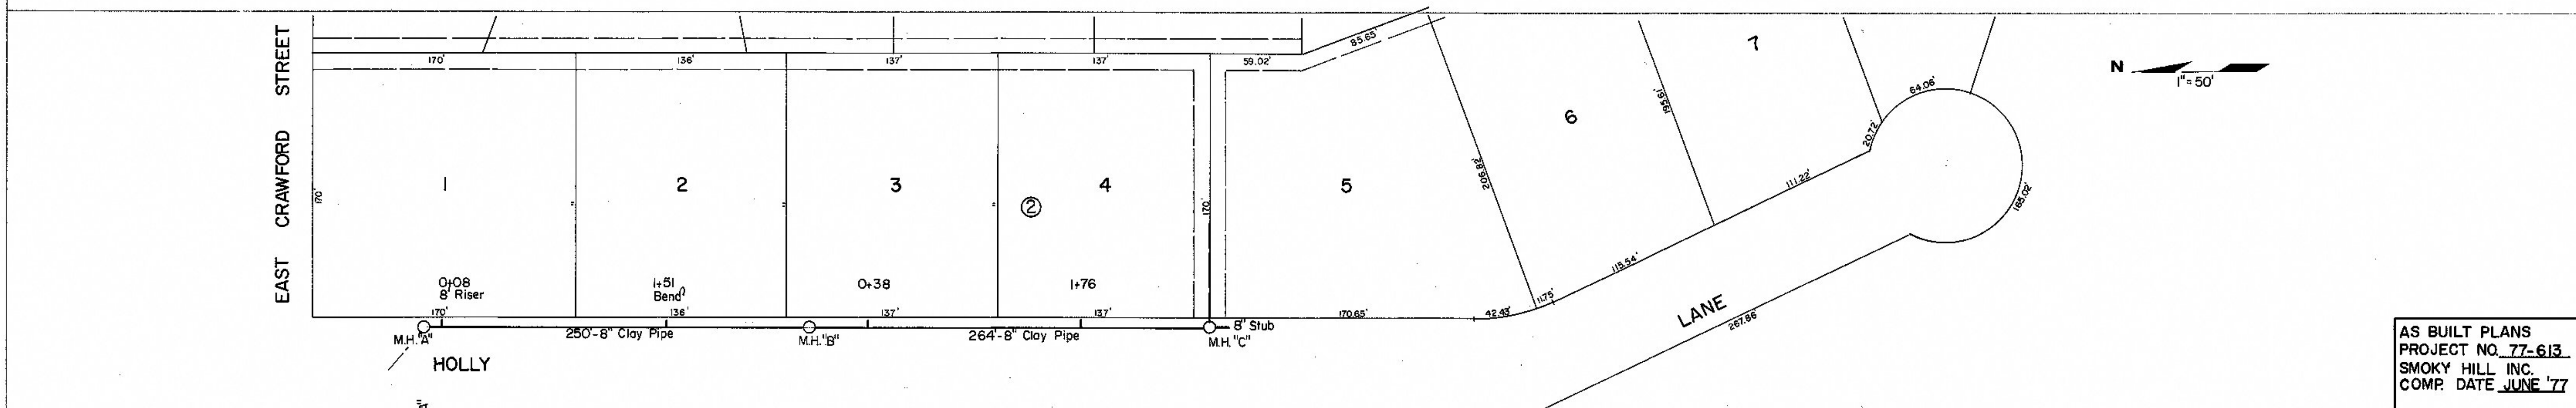
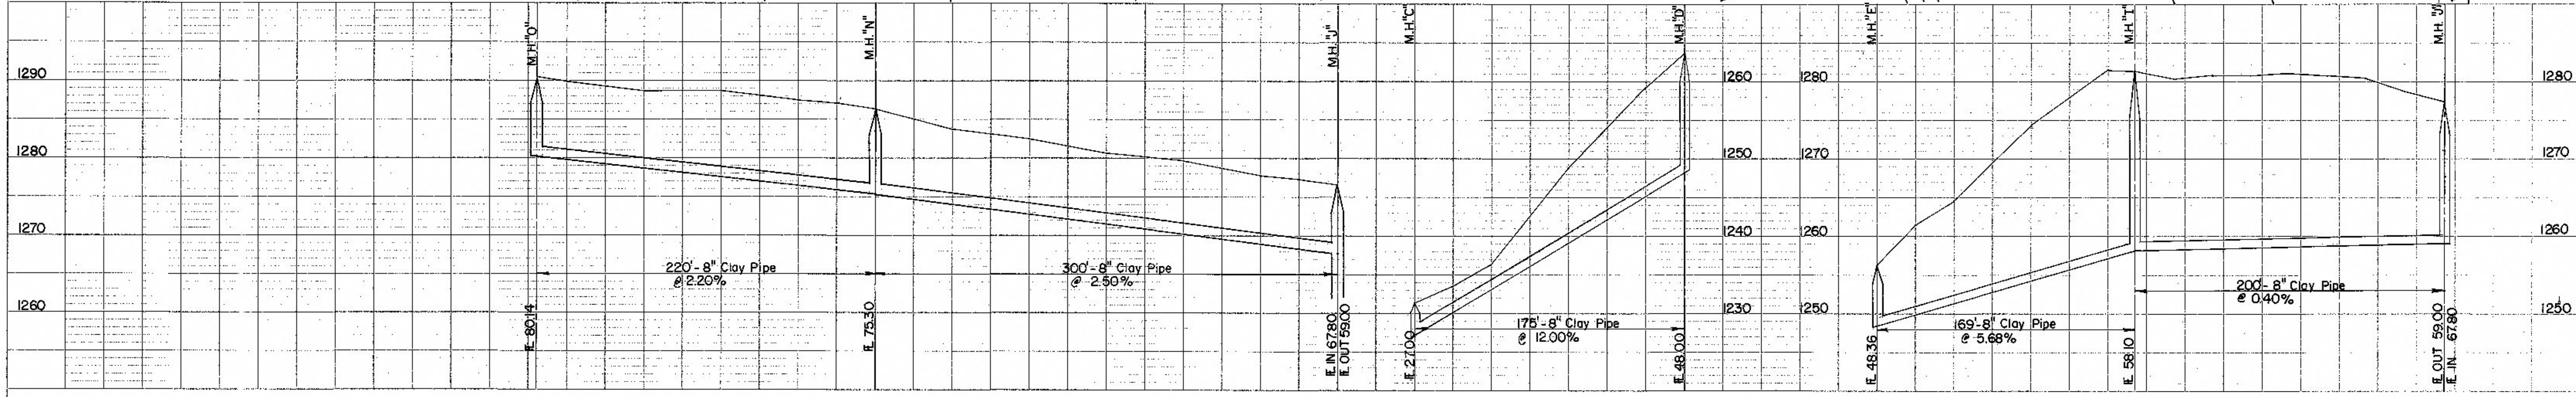


PLAN  
 SURVEYED BY  
 DRAWN BY  
 CHECKED BY  
 DATE

PROFILE  
 SURVEYED BY  
 DRAWN BY  
 CHECKED BY  
 DATE

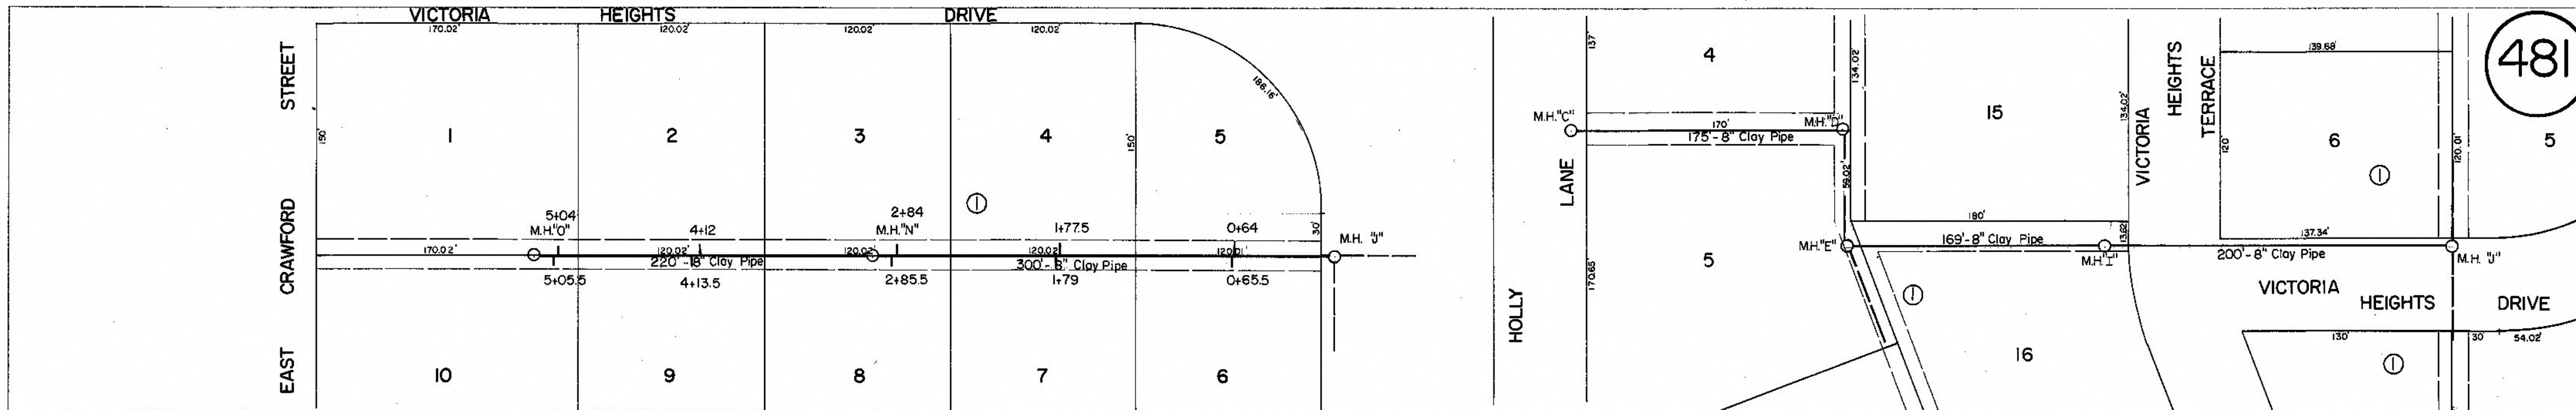

AS BUILT PLANS  
 PROJECT NO. 77-613  
 SMOKY HILL INC.  
 COMP. DATE JUNE '77