
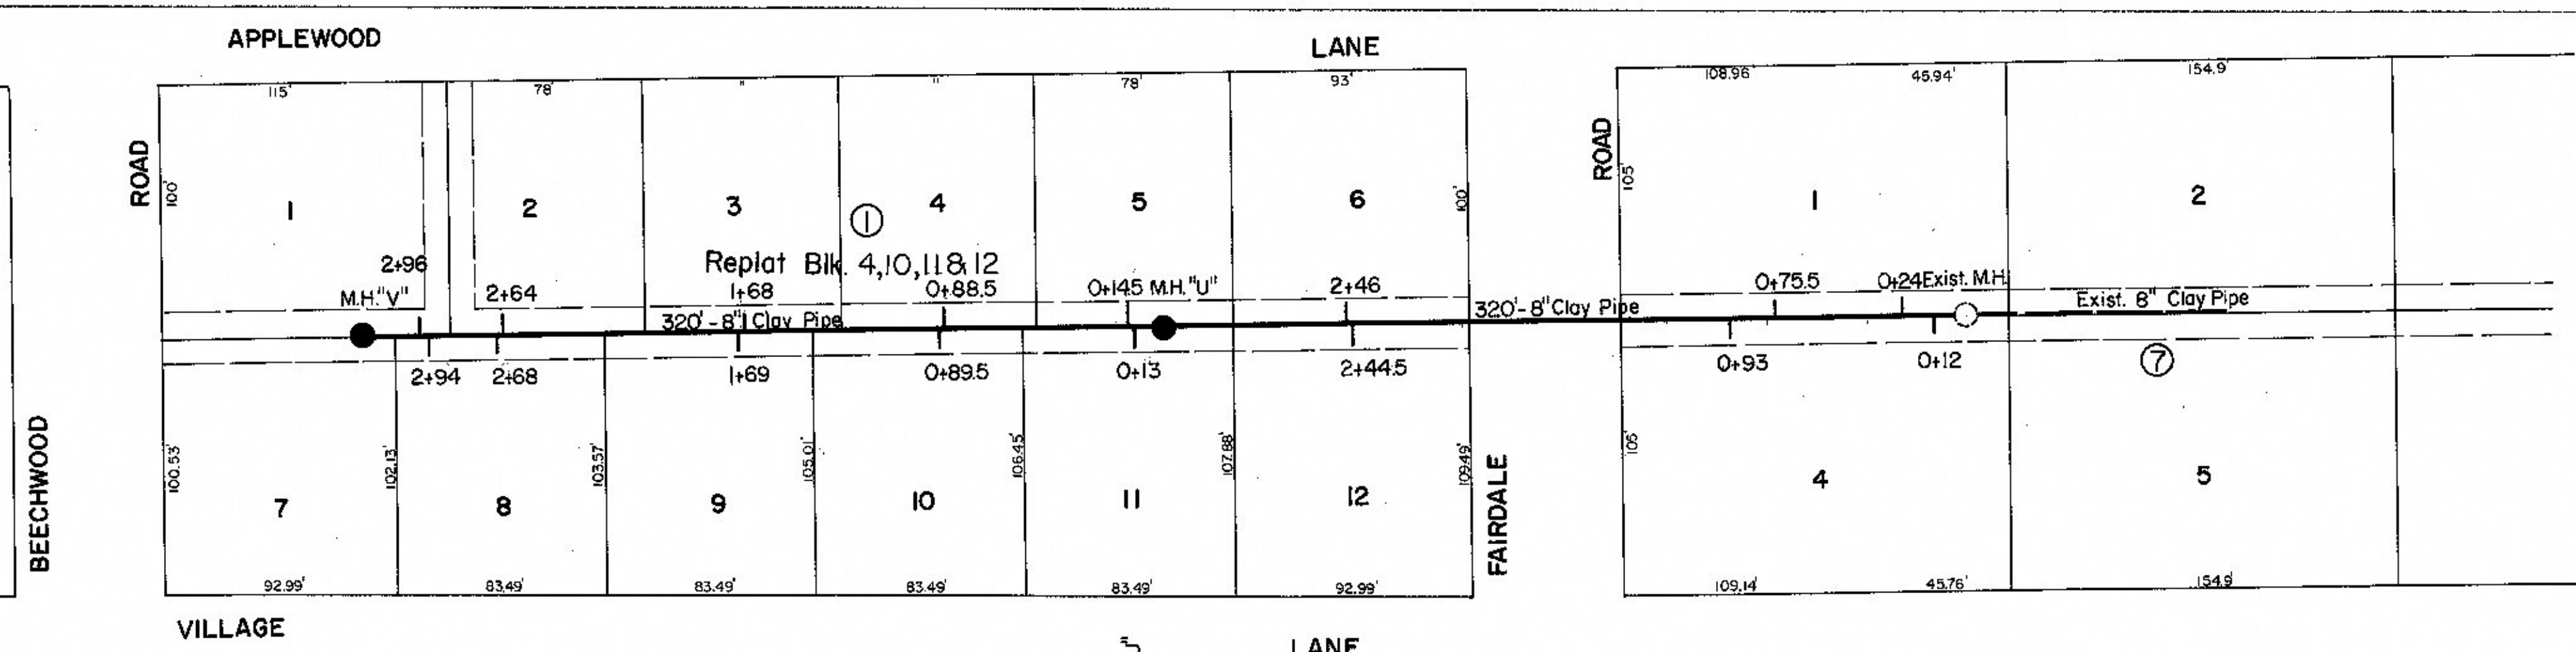


AS BUILT PLANS
PROJECT NO. 77-614
EARTH EXCAVATION
COMPLETION DATE 6-'77

PLAN	DESIGNED BY	DATE
	CHECKED BY	
	PLOTTED BY	
	DATE	
NOTE BOOK NO.		
BY		

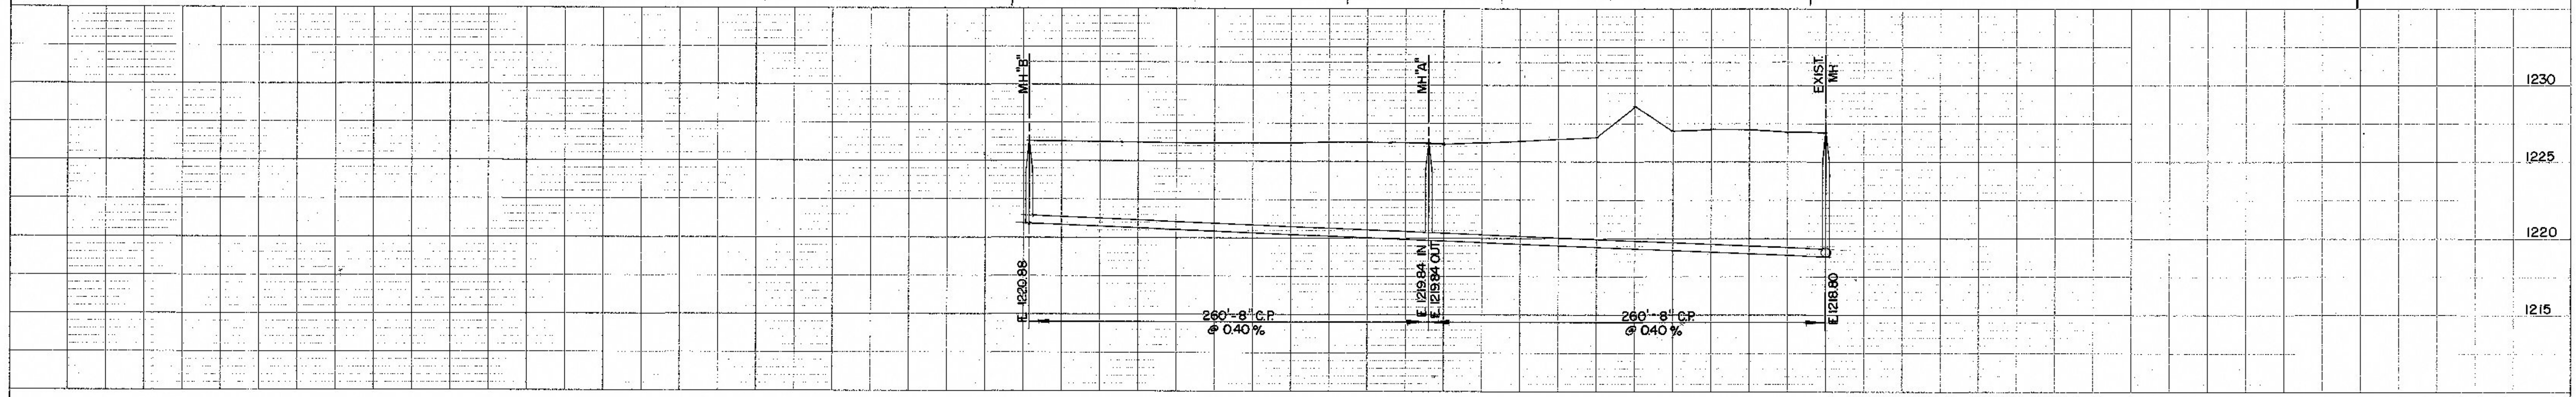

AS BUILT PLANS
PROJECT NO. 77-618
EARTH EXCAVATION
COMPLETION DATE 6-'77

PROFILE	DESIGNED BY	DATE
	CHECKED BY	
	PLOTTED BY	
	DATE	
NOTE BOOK NO.		
BY		

