


DATE	
BY	
NO.	
PLAN	
NO.	
DATE	
BY	
NO.	
PROFILE	
NO.	
DATE	
BY	
NO.	

DATE	
BY	
NO.	
PROFILE	
NO.	
DATE	
BY	
NO.	

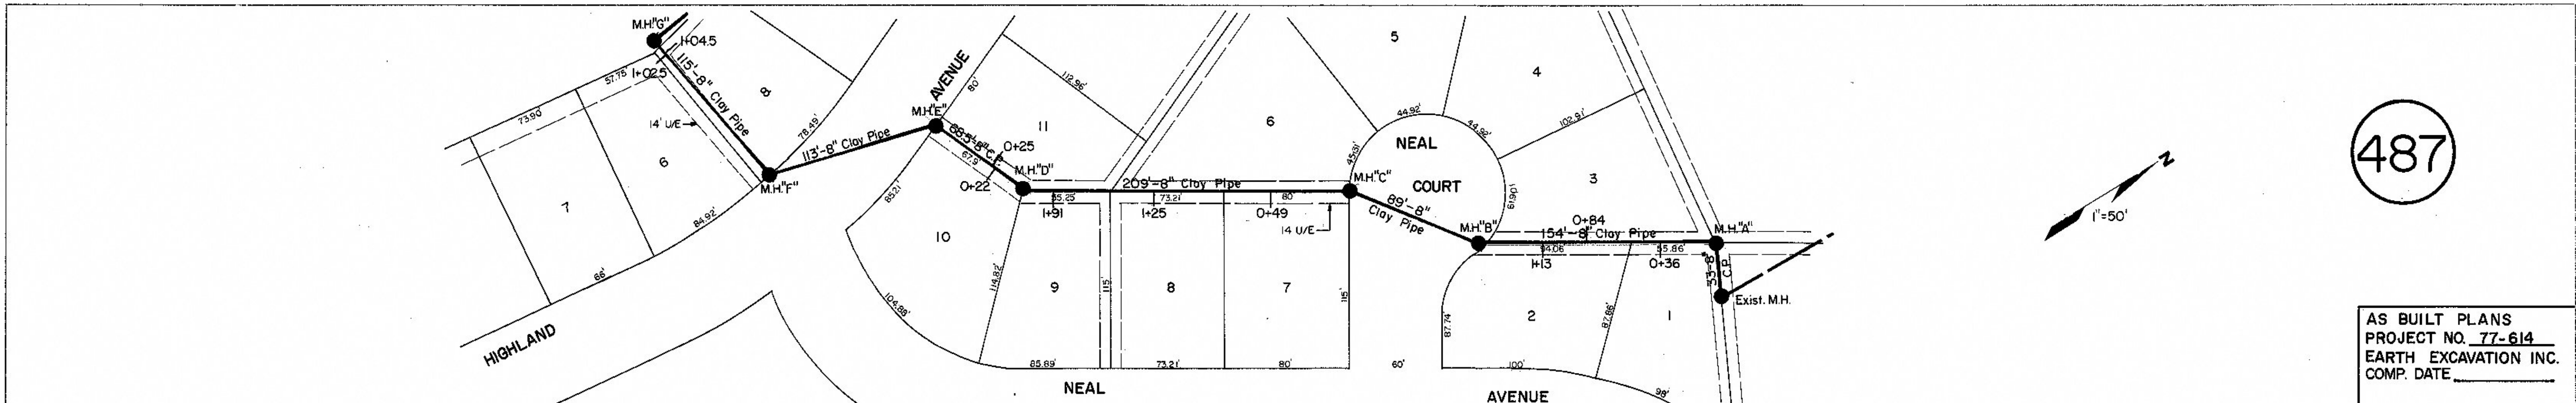

487

AS BUILT PLANS
PROJECT NO. 77-614
EARTH EXCAVATION INC.
COMP. DATE _____

