
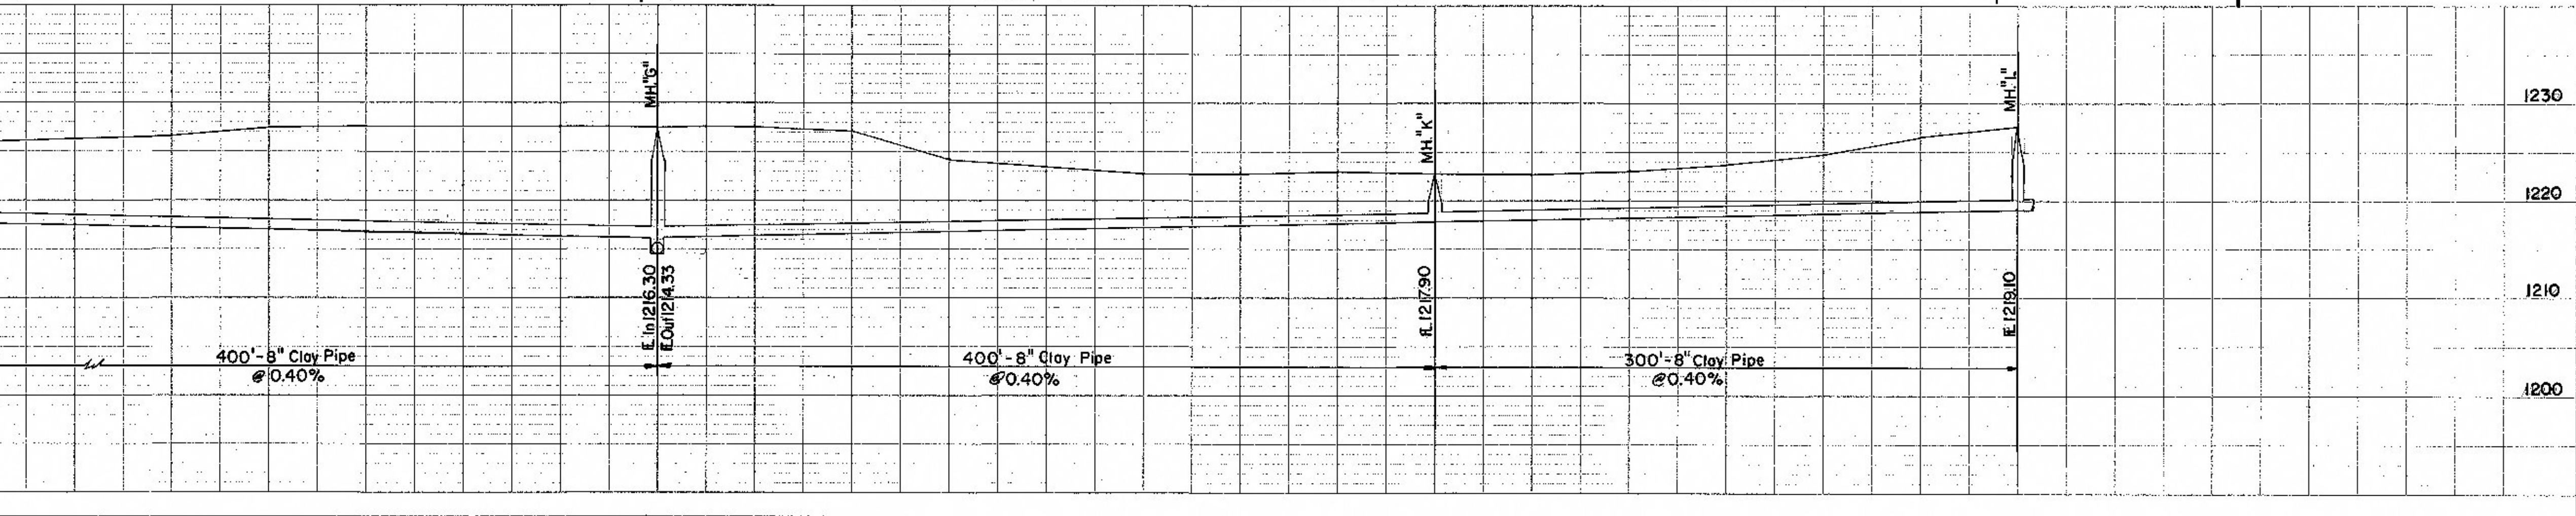
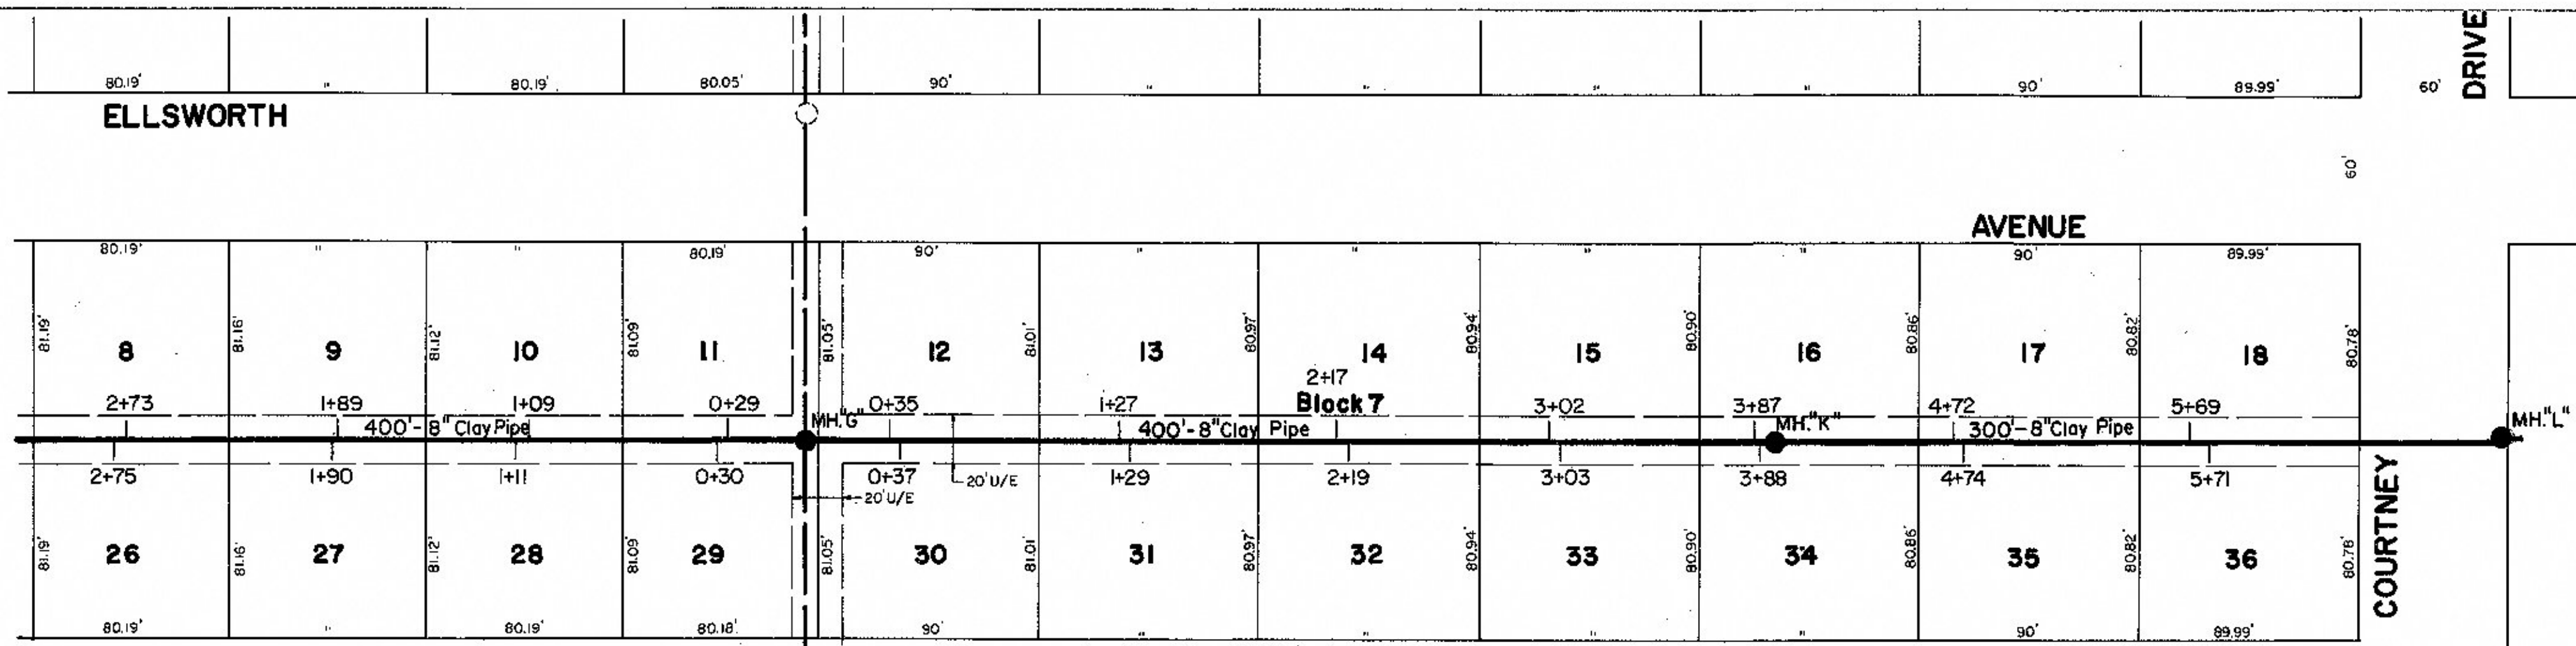
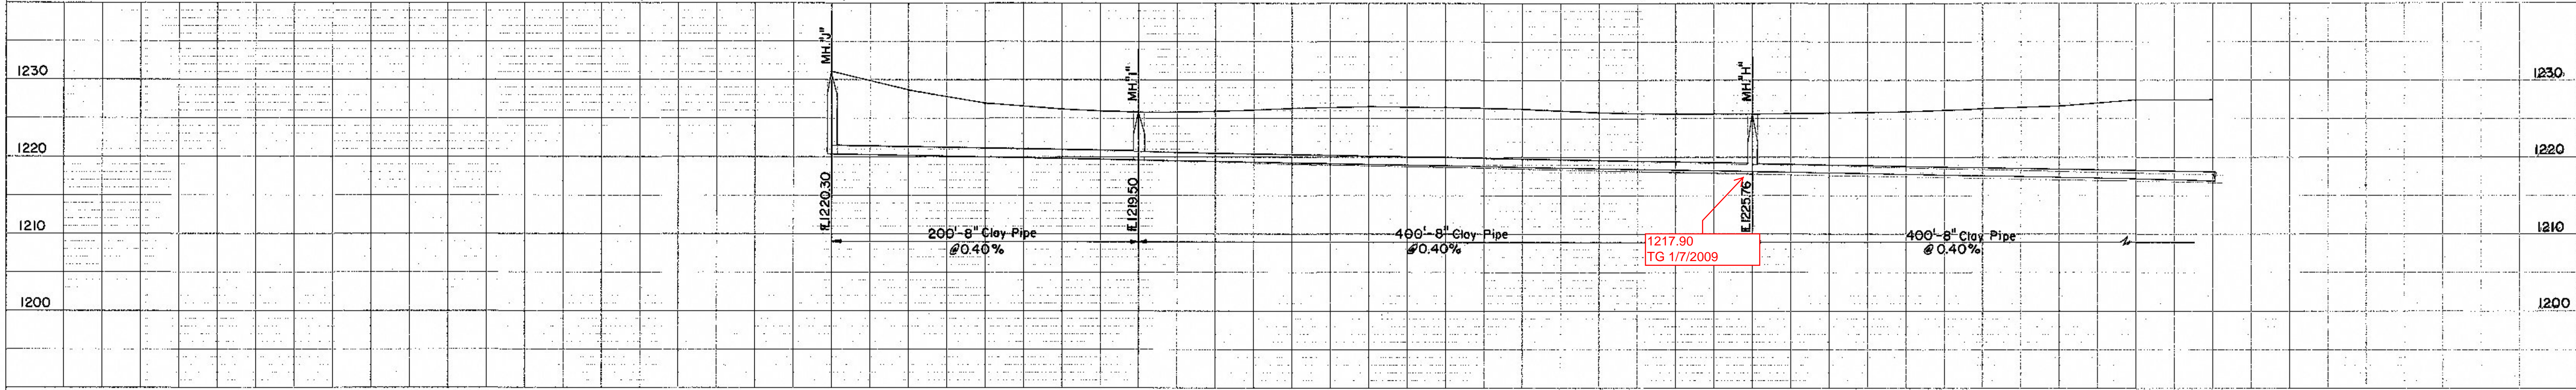


PLAN
 SURVEYED
 ALIGNMENT CHECKED
 SEC. OF WAY CHECKED
 NO.

PROFILE
 SURVEYED
 GRADES CHECKED
 H.M. NOTED
 STRUCTURE NOTES CHECKED
 NO.

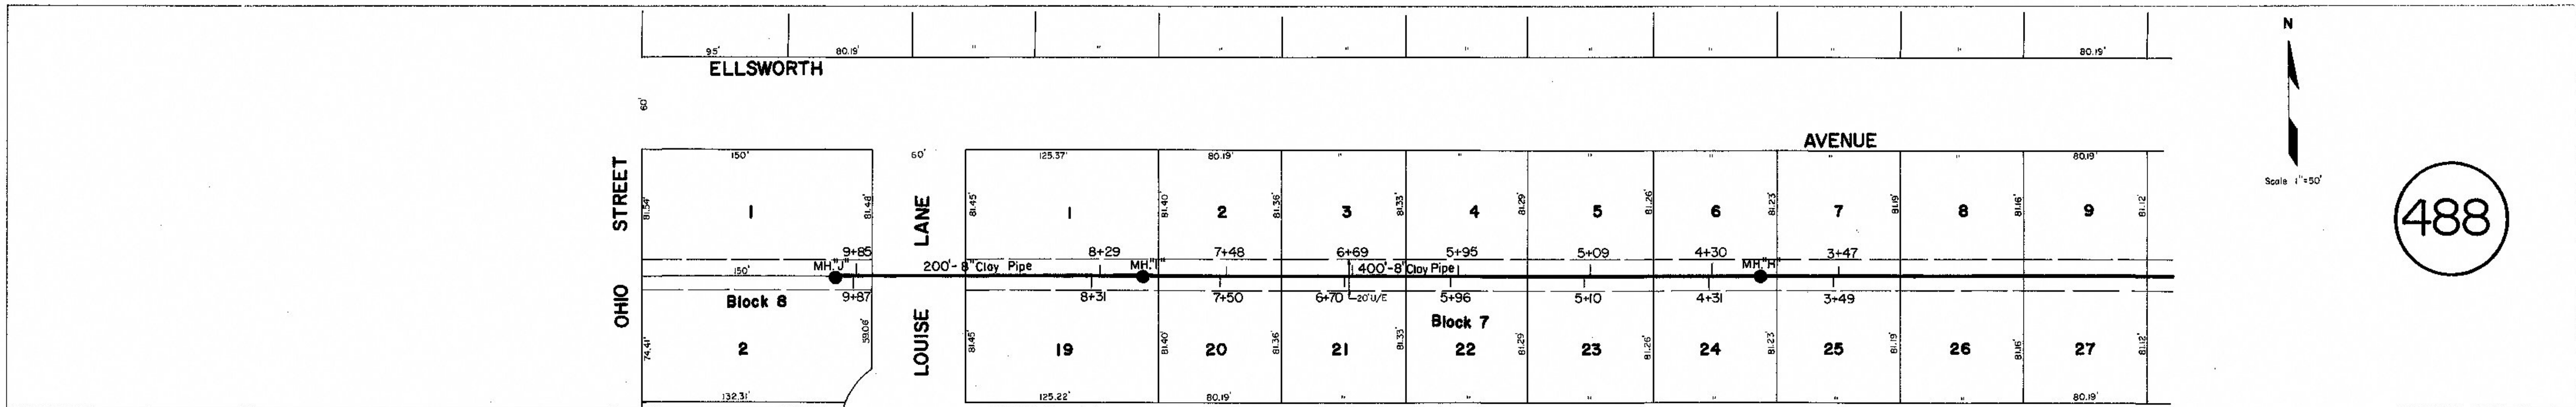

AS BUILT PLANS
PROJECT NO. 77-620
SMOKY HILL INC.
COMP. DATE

488