

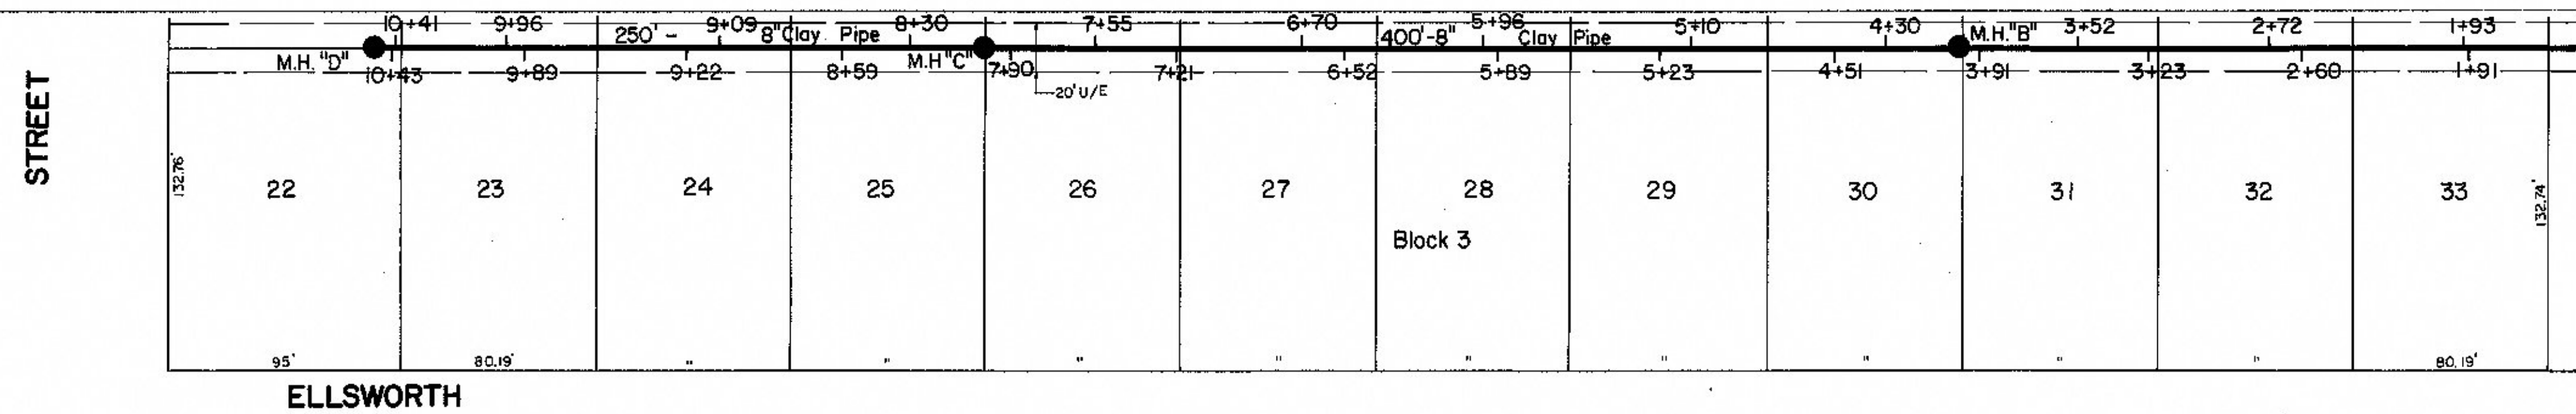
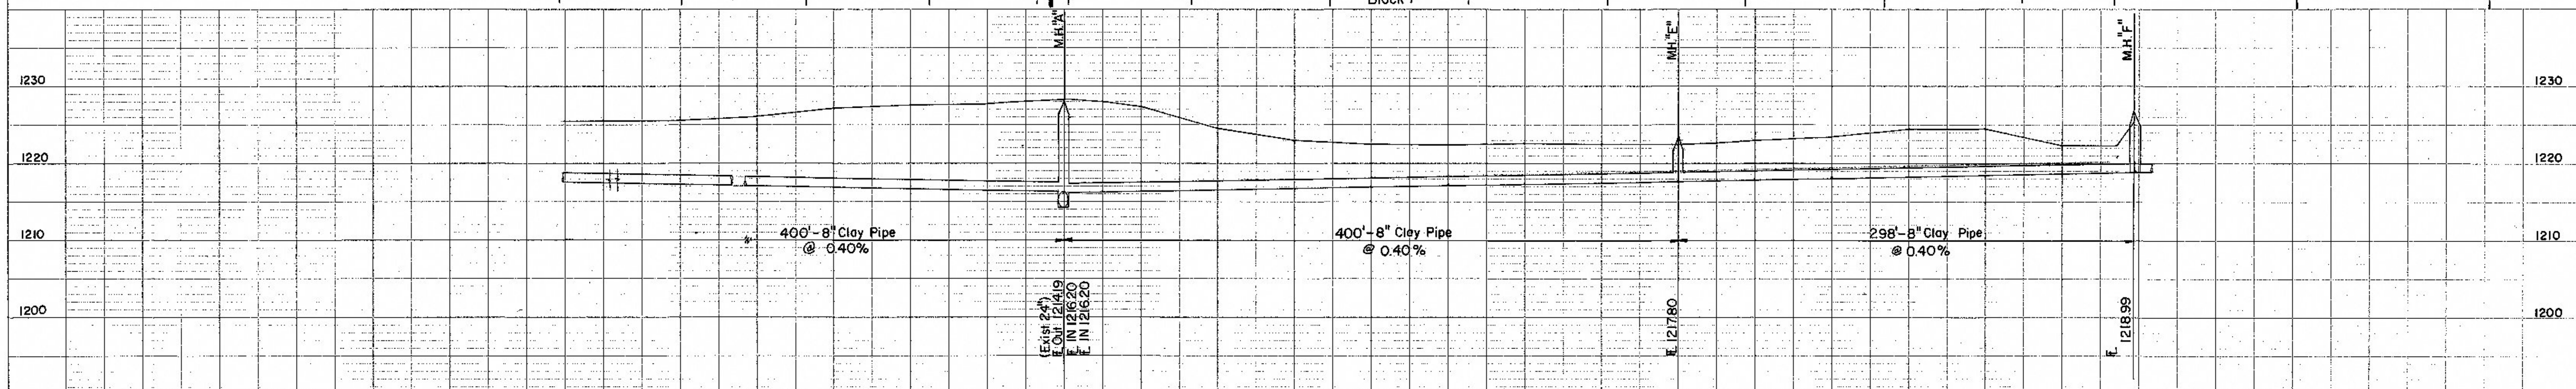


PLAN	SUBMITTED	DATE
	PLOTTED	
	ALIGNMENT CHECKED	
	BY	
	NO.	

PROFILE	ENGINEER	DATE
	GRADES CHECKED	
	STRUCTURE NOTATION	
	NO.	

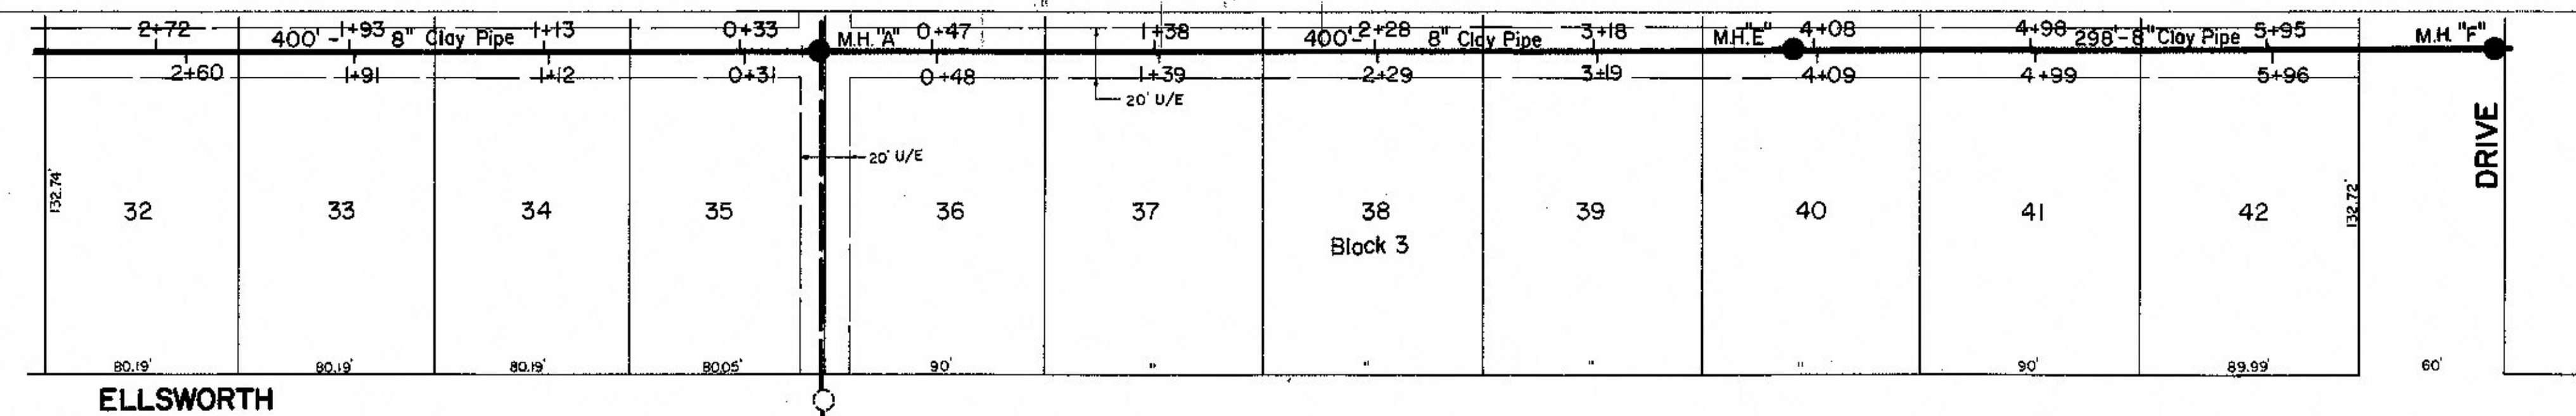

489

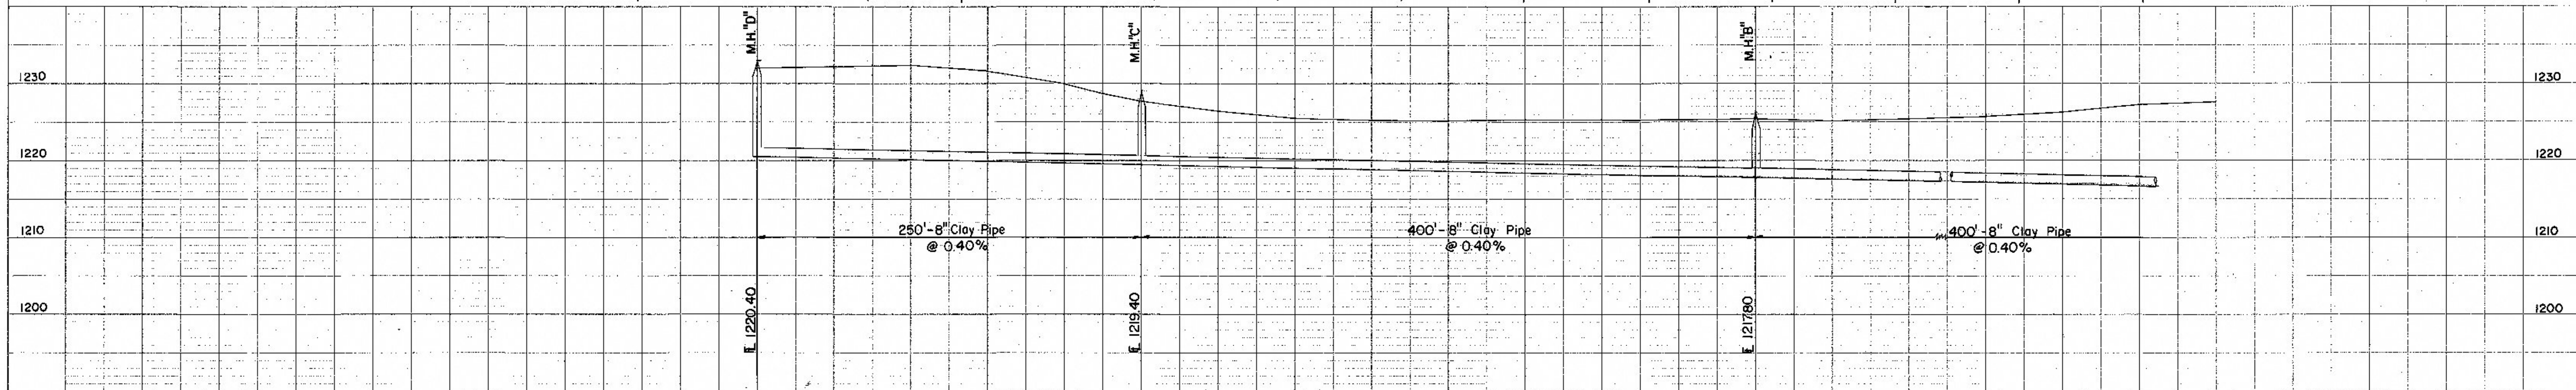

AS BUILT PLANS
PROJECT NO. 77-620
SMOKY HILL INC.
COMP. DATE