

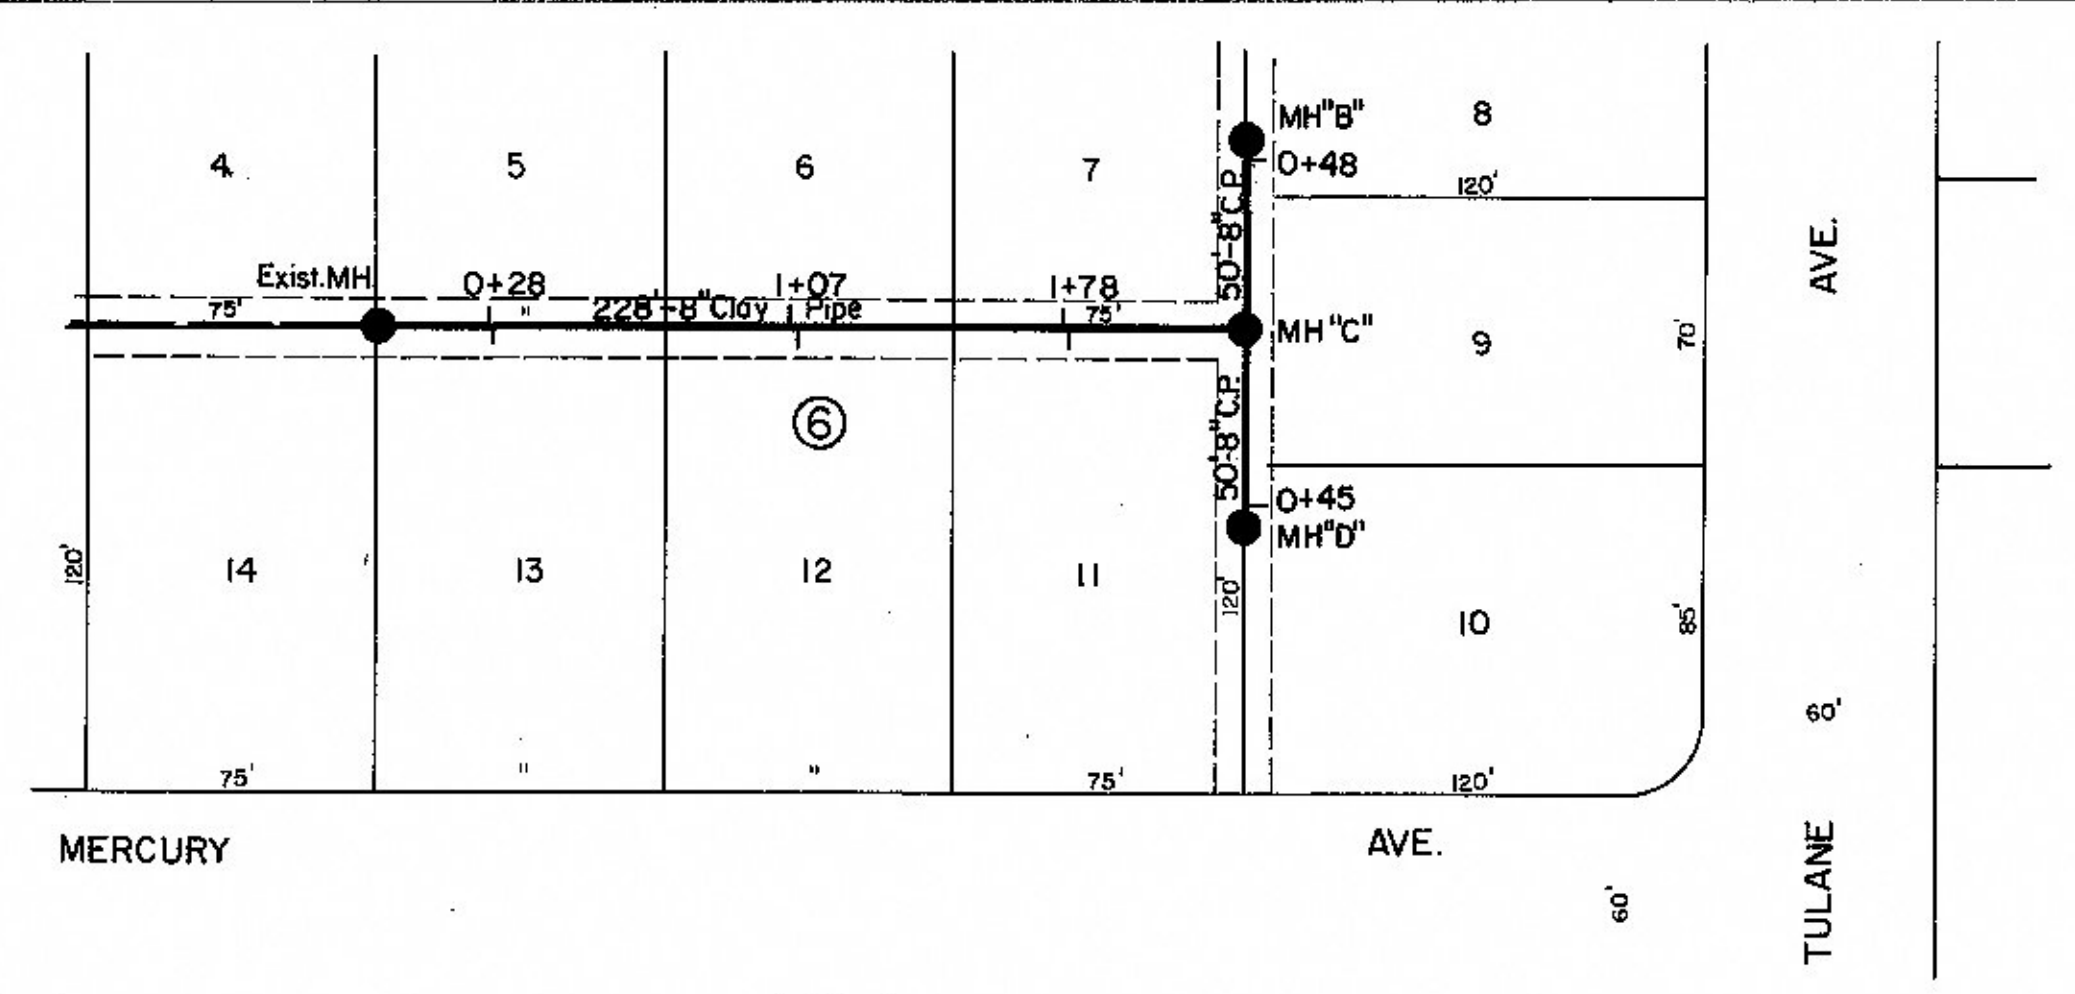
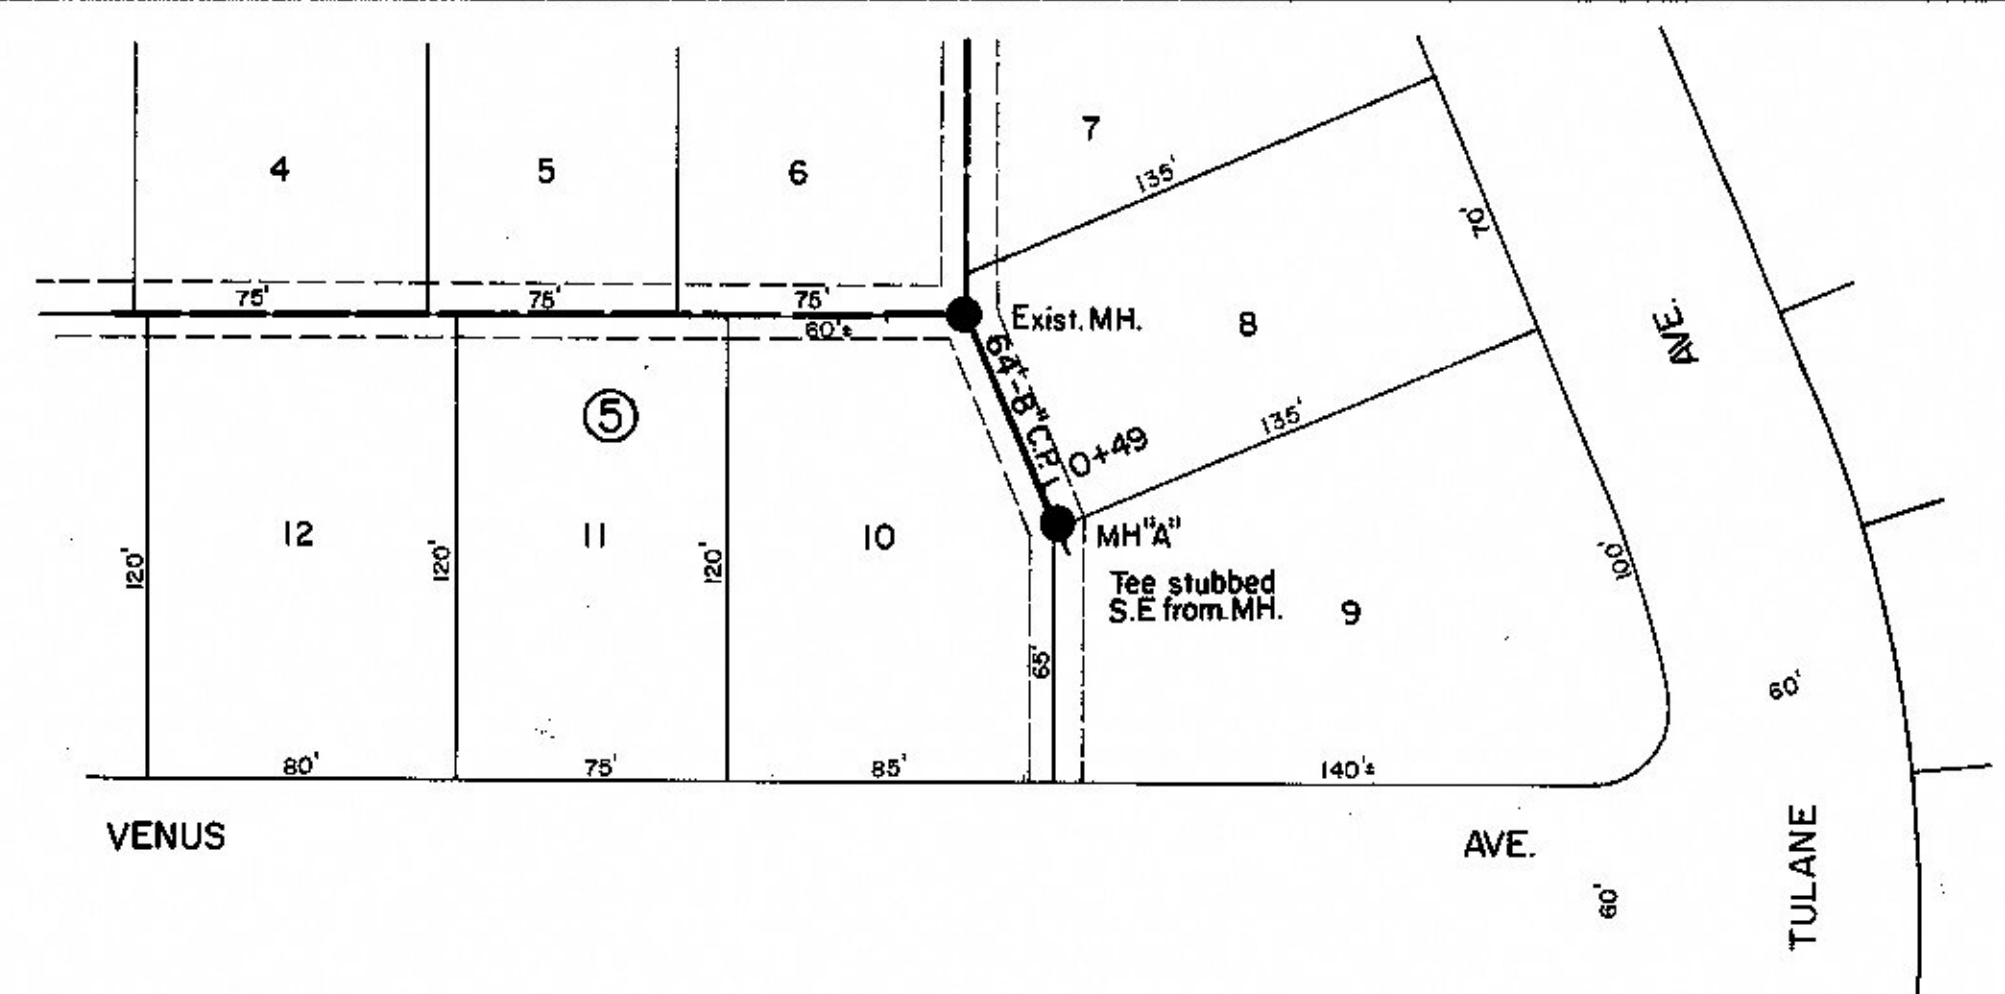
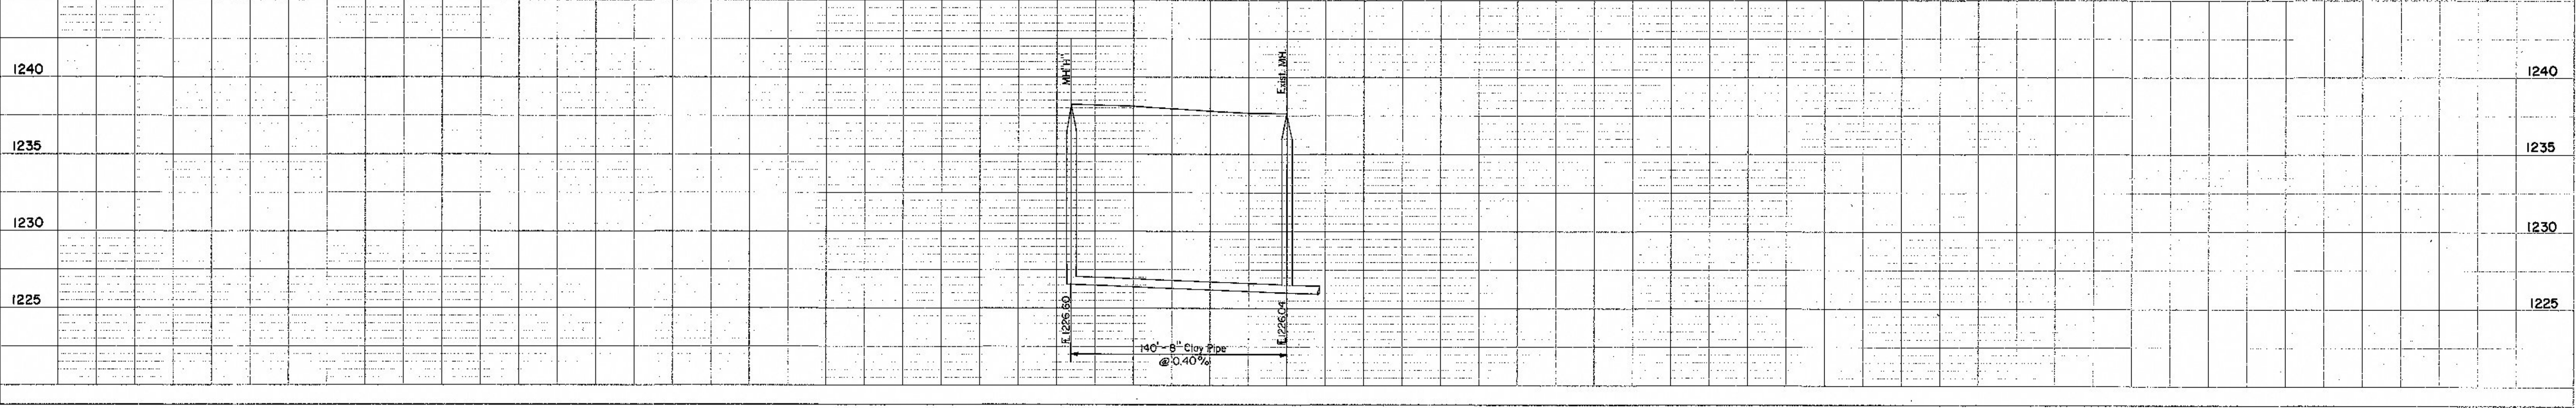


DATE: _____ BY: _____
 SURVEYED: _____
 PLAN CHECKED: _____
 ALIGNED: _____
 ST. OF WAY CHECKED: _____
 NO. _____

DATE: _____ BY: _____
 SURVEYED: _____
 PROFILE CHECKED: _____
 8 AM. NOTED: _____
 STRUCTURE NOTATIONS: _____
 NO. _____

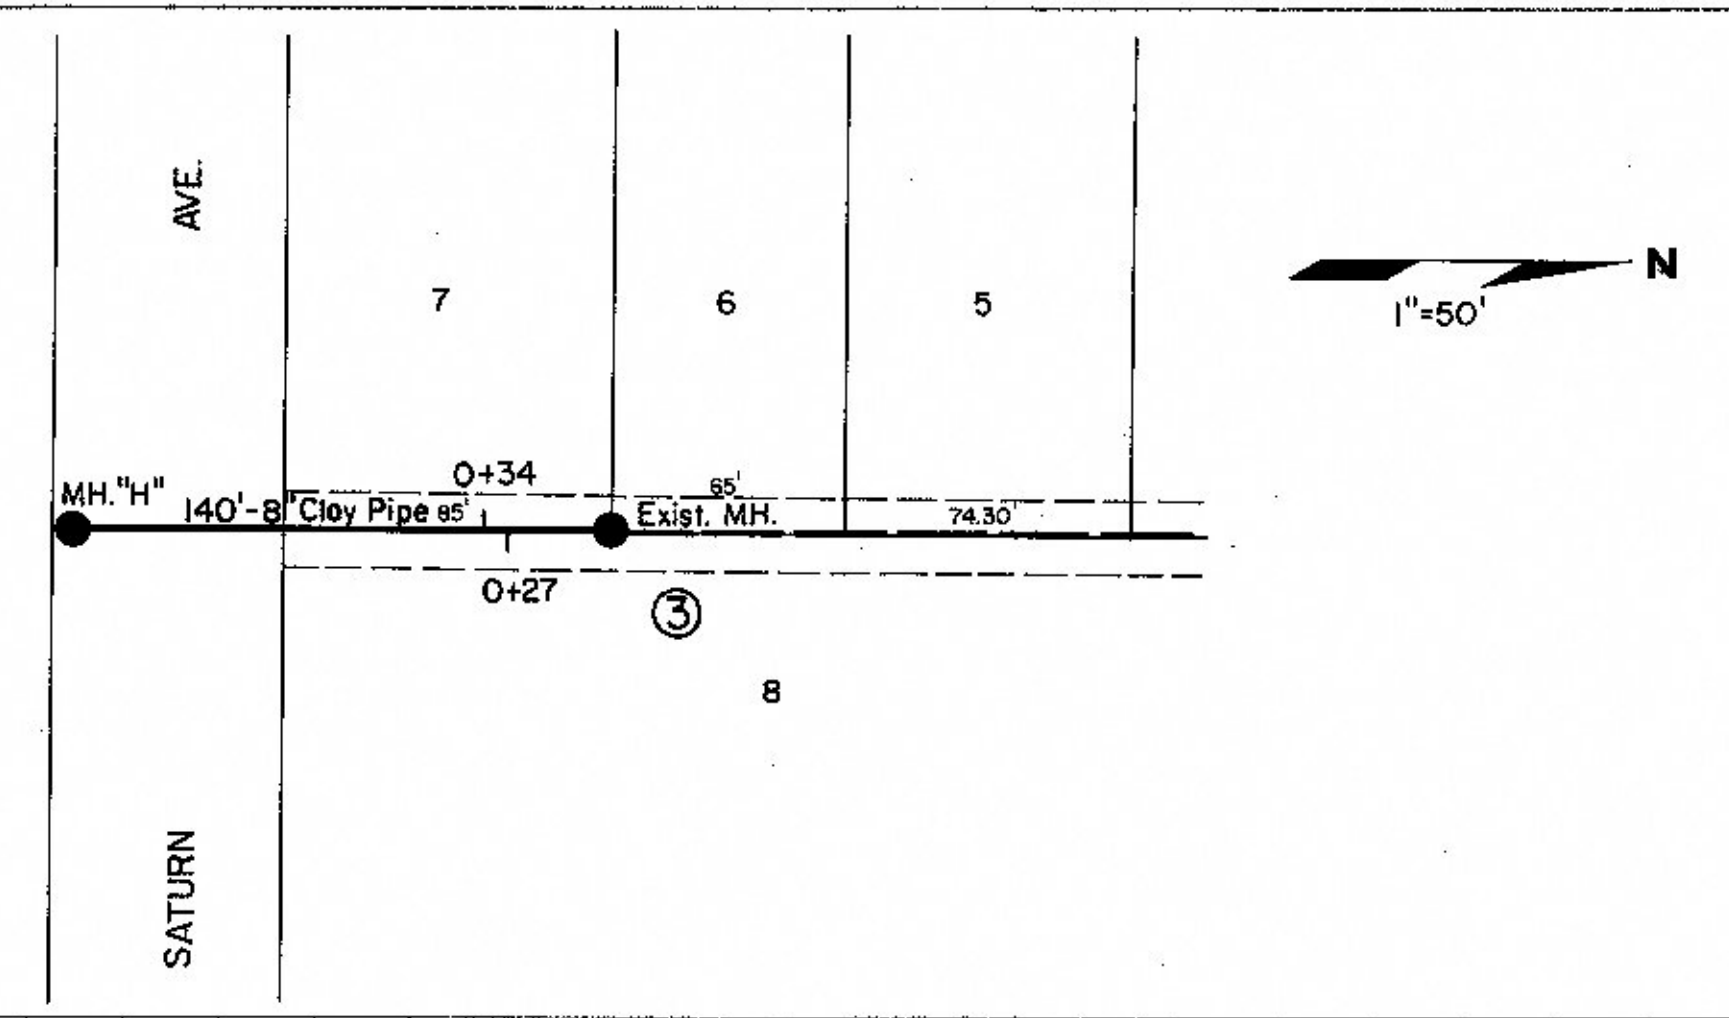

490

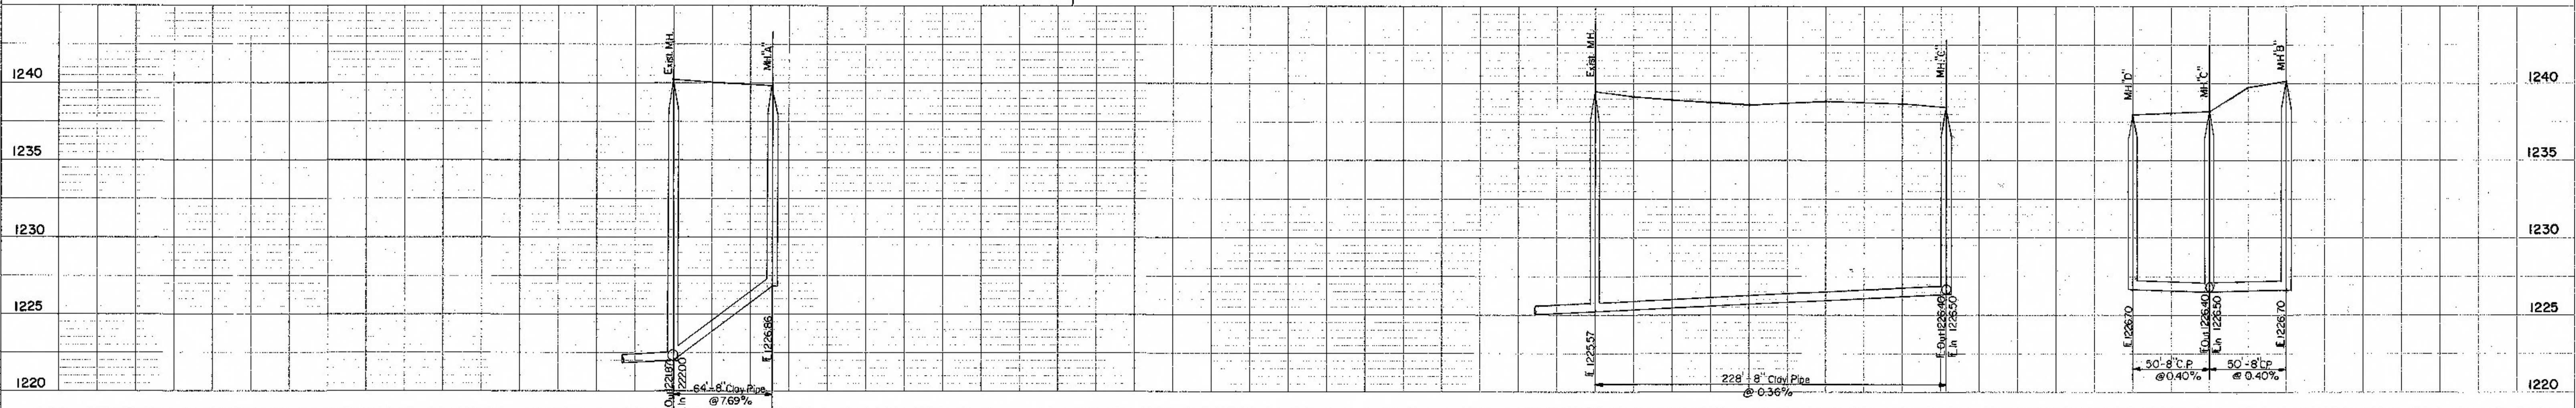

AS BUILT PLANS
 PROJECT NO 77-614
 EARTH EXCAVATION INC.
 COMP. DATE