

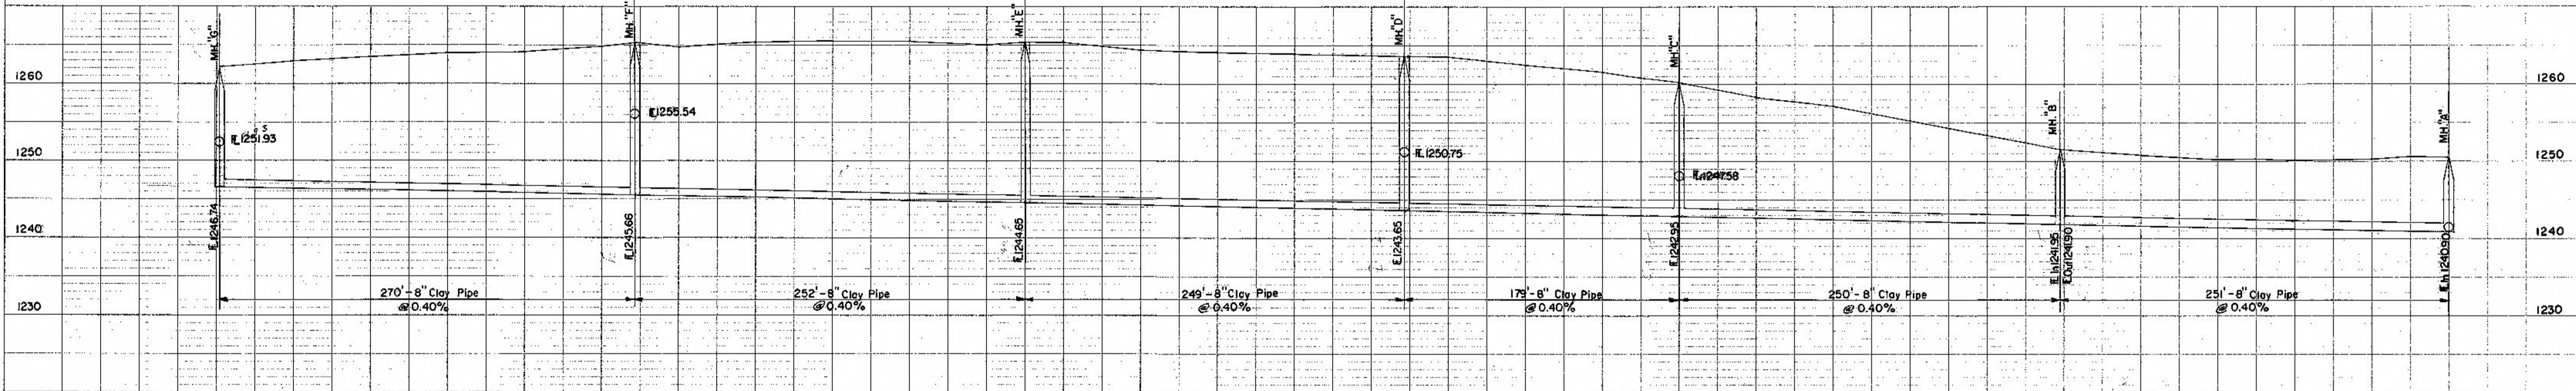
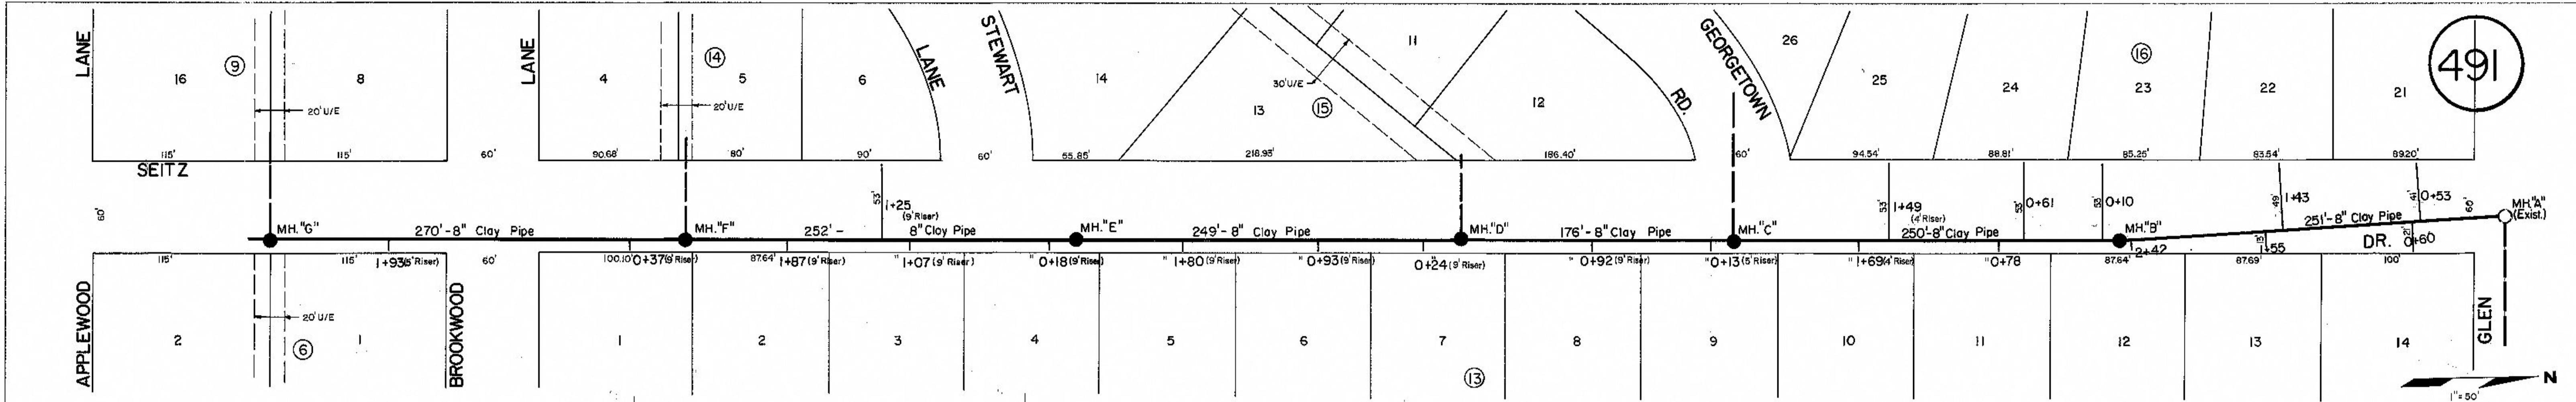
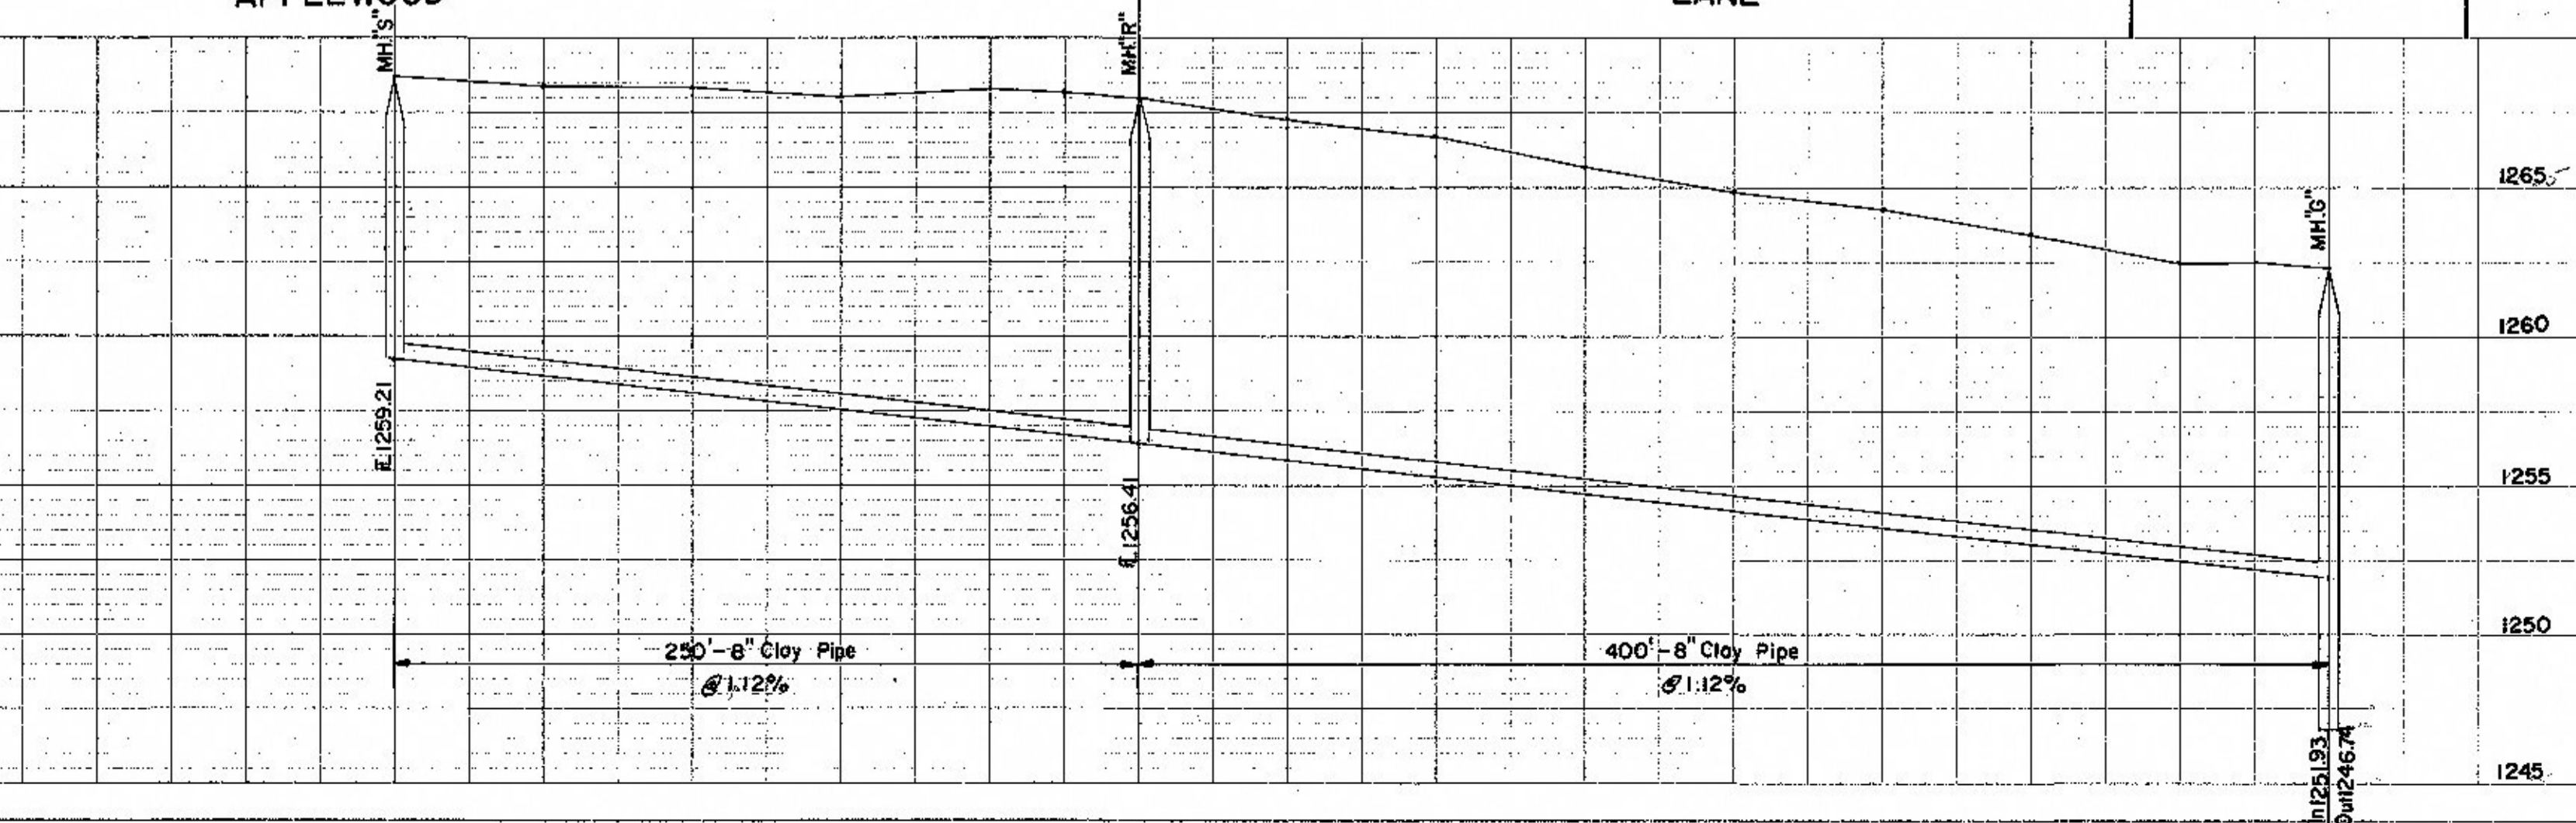
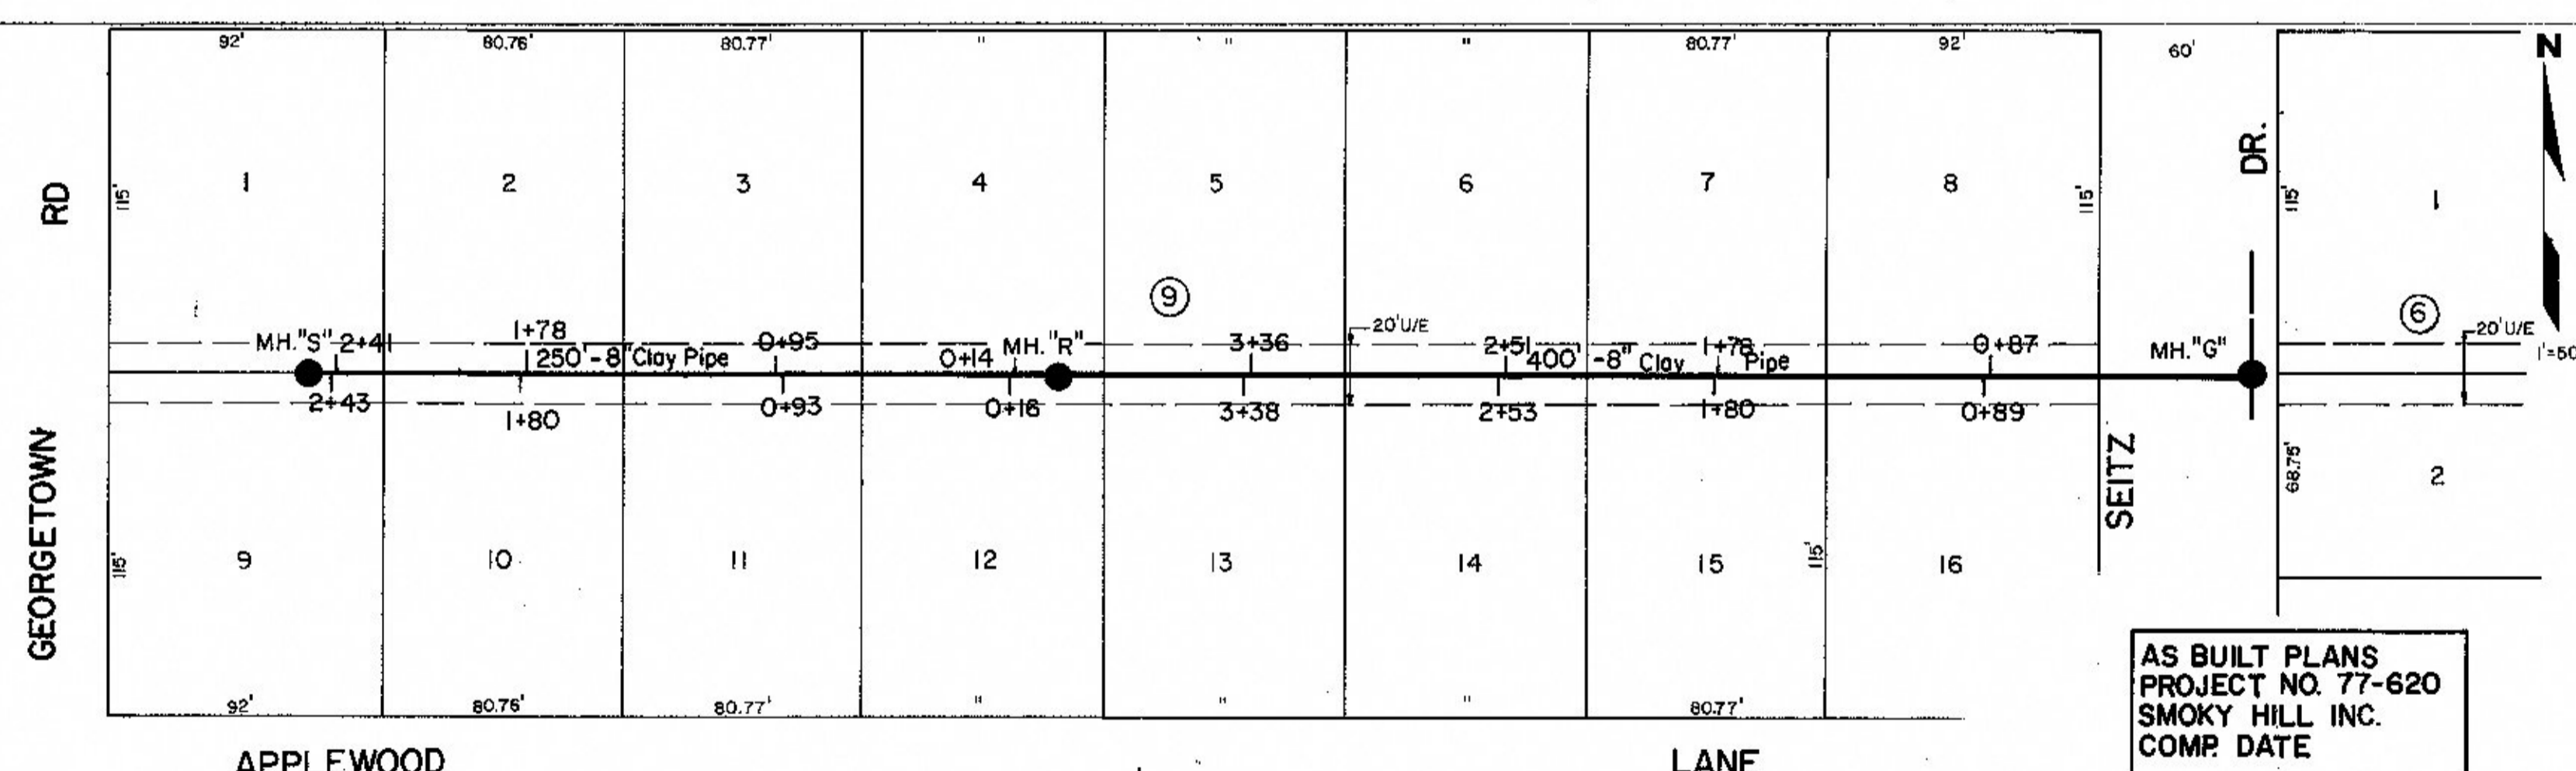


DATE	
BY	
REVISIONS	
PLANNING	
DESIGN	
CONSTRUCTION	
NOTE BOOK	
NO.	

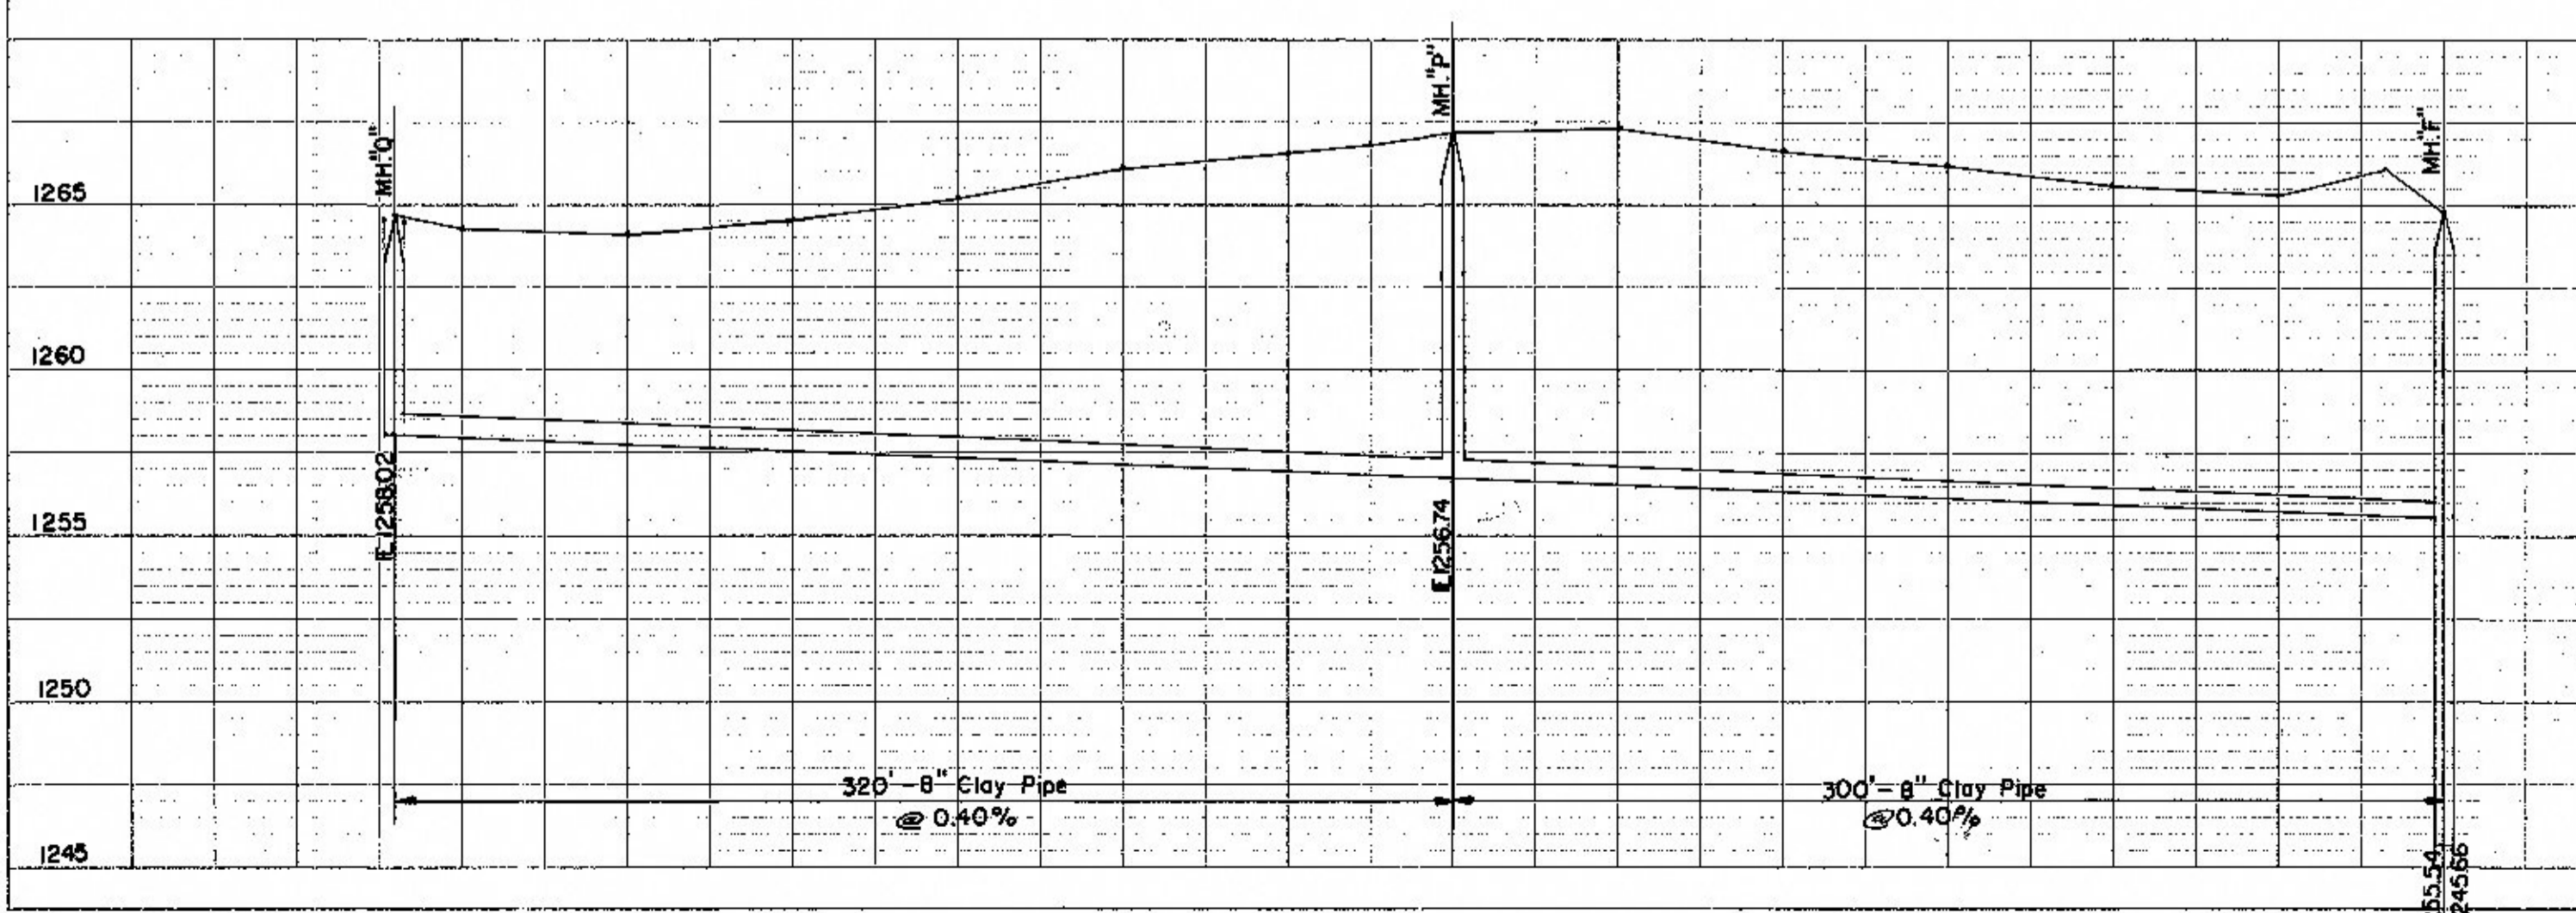

DATE	
BY	
REVISIONS	
PLANNING	
DESIGN	
CONSTRUCTION	
NOTE BOOK	
NO.	

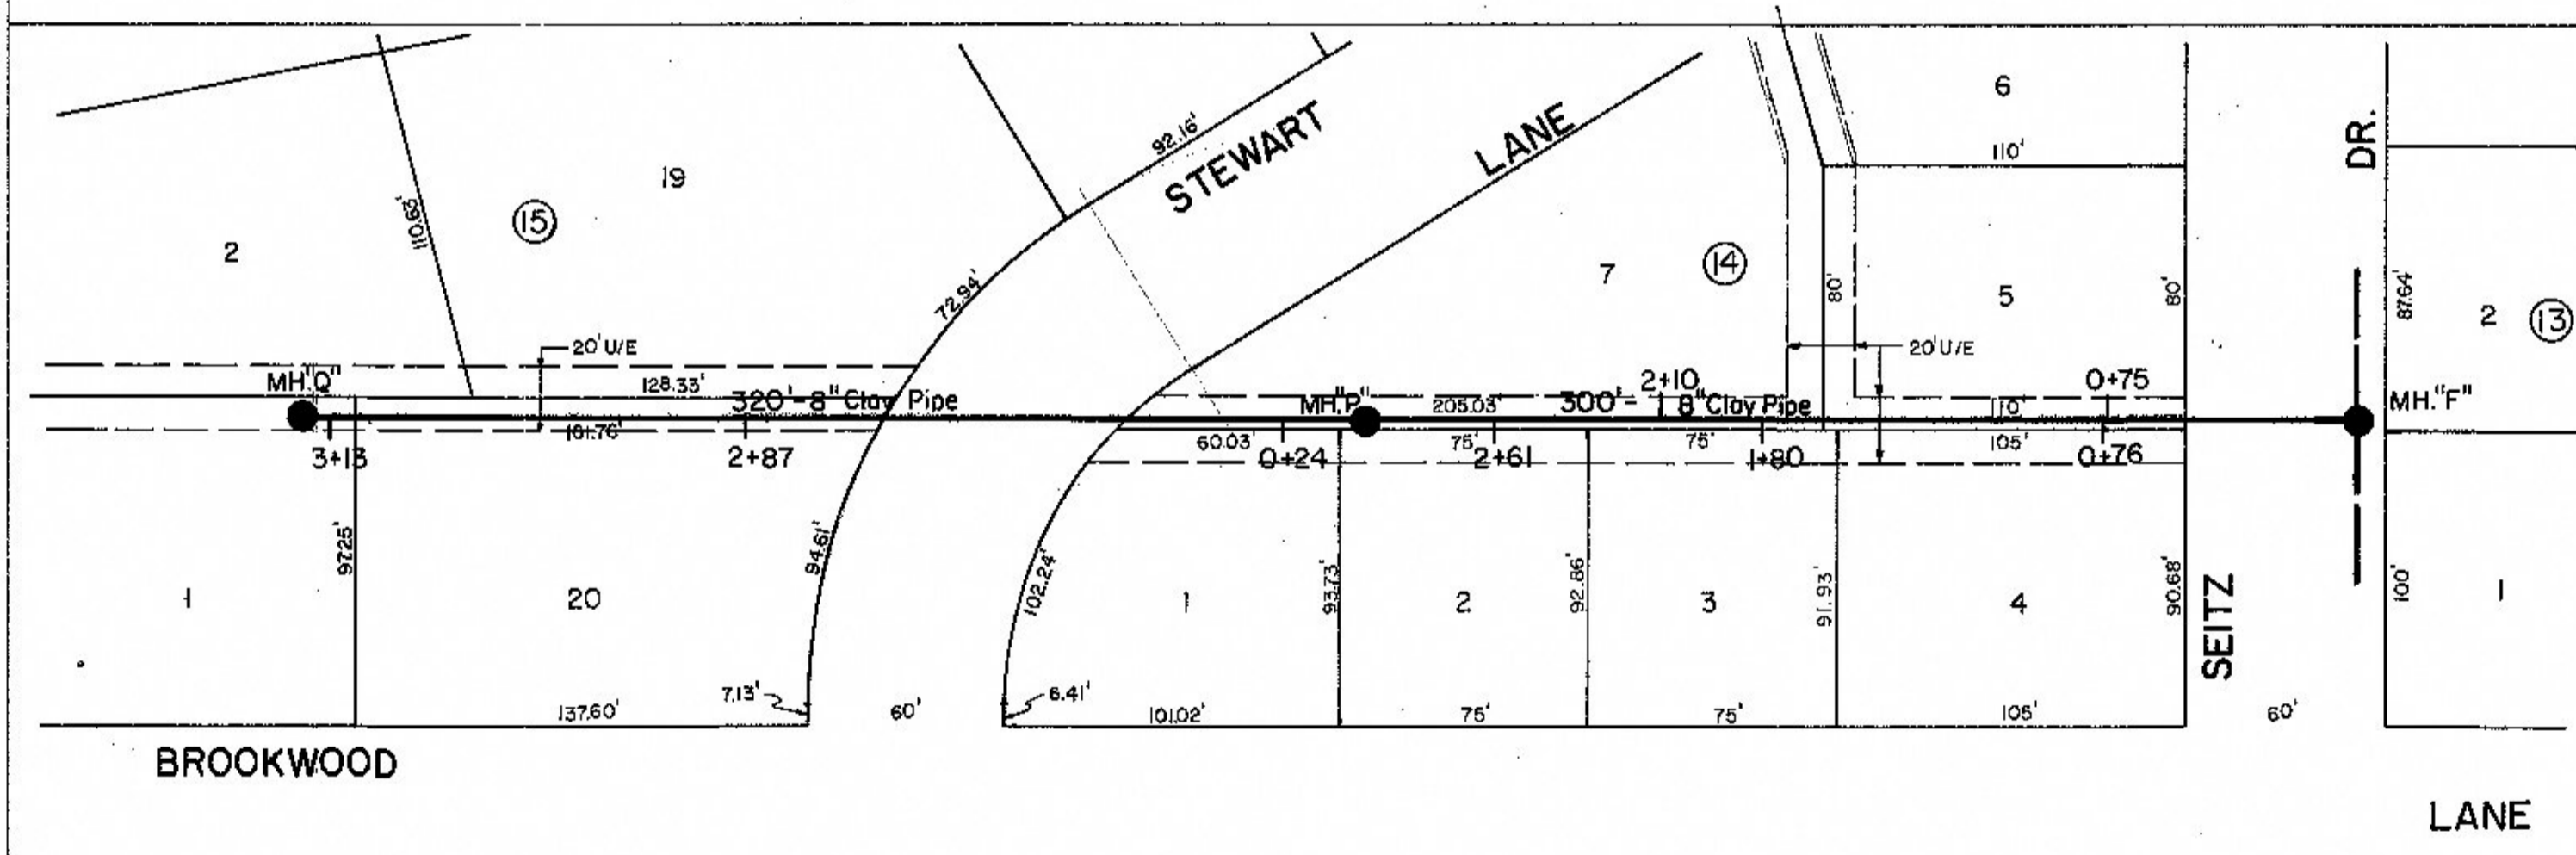

AS BUILT PLANS
PROJECT NO. 77-620
SMOKY HILL INC.
COMP. DATE