

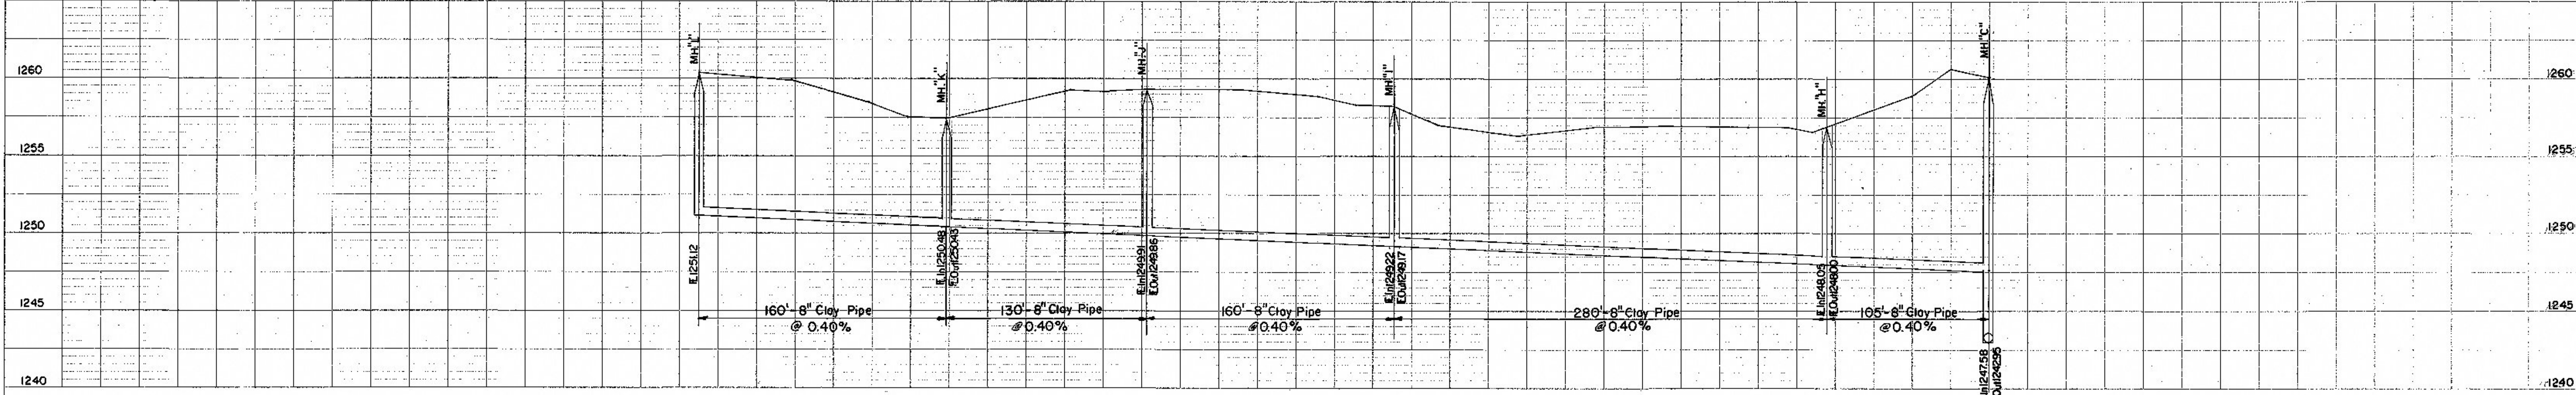
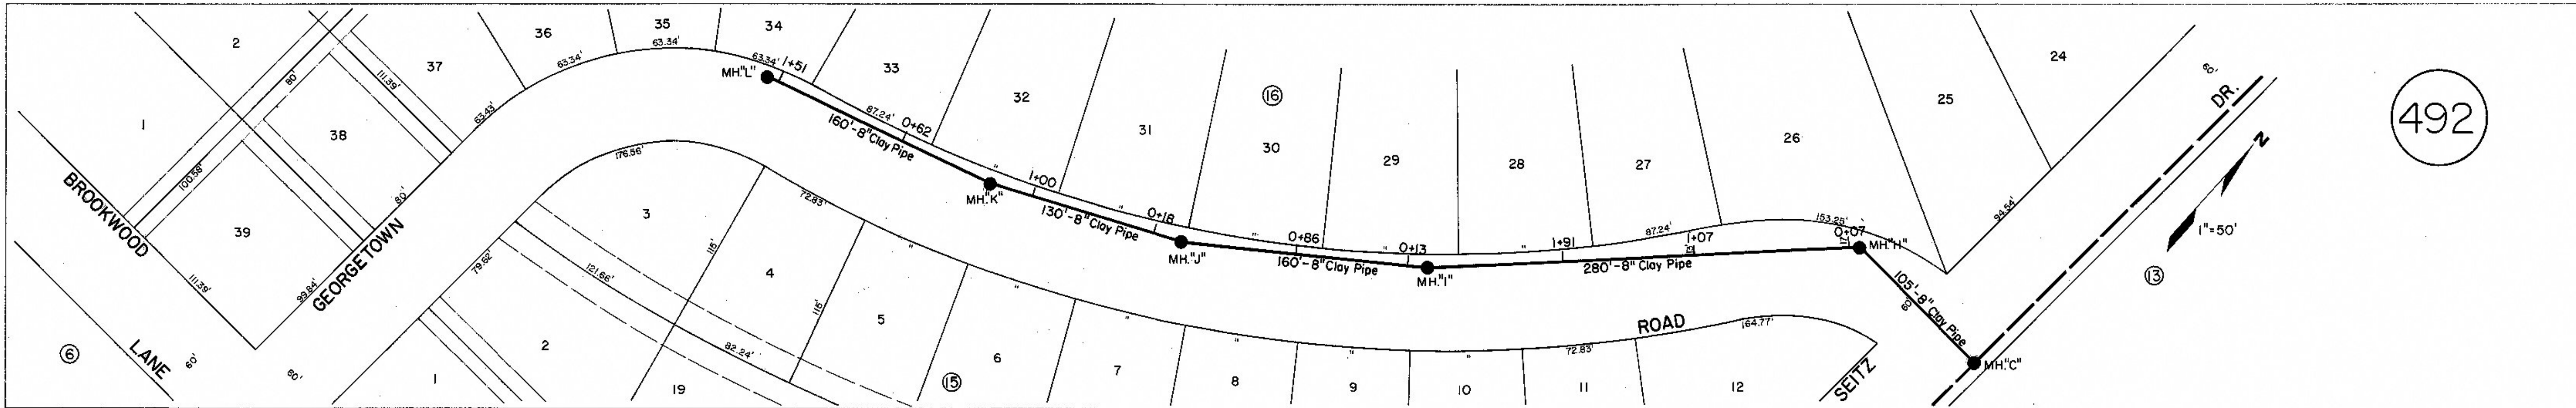


PLAN
 SURVEYED BY _____ DATE _____
 NOTE BOOK ALIGNMENT CHECKED _____
 NO. _____

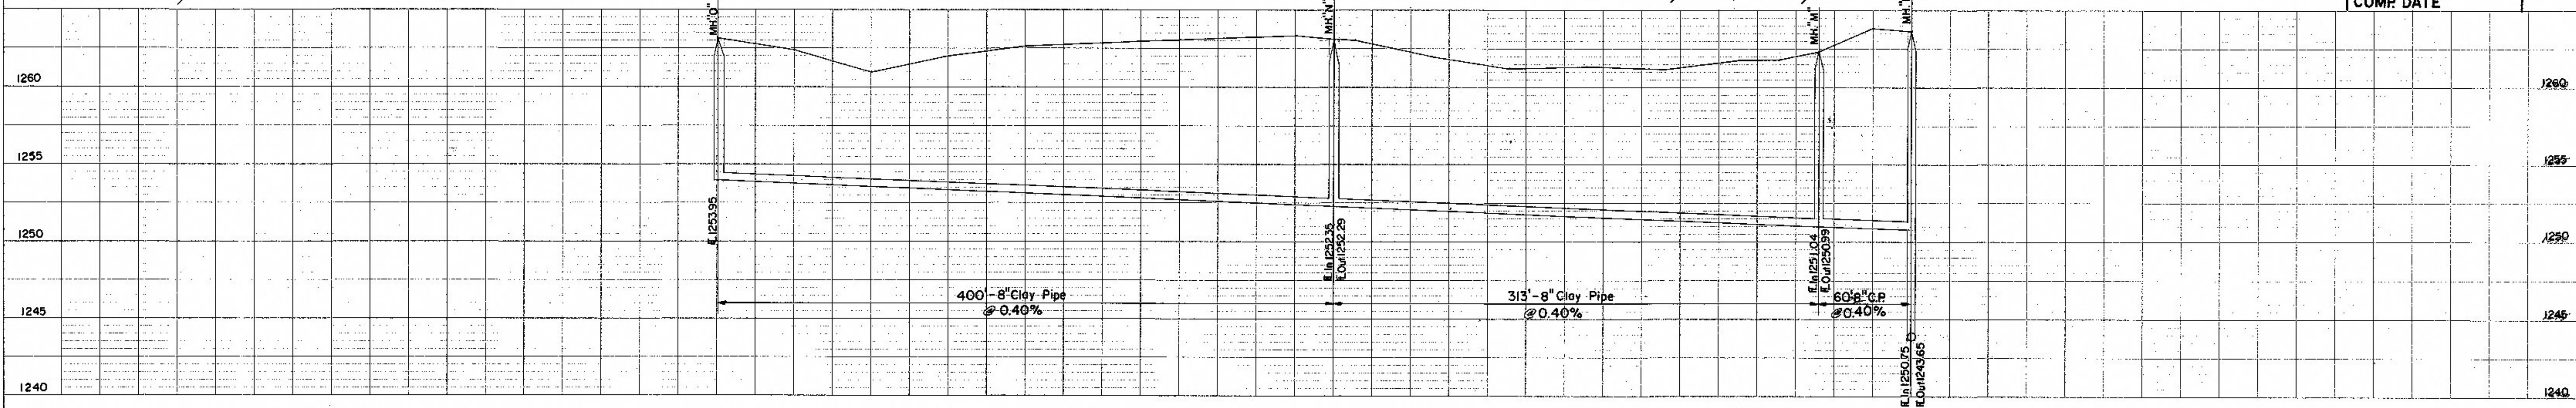

PROFILE
 SURVEYED BY _____ DATE _____
 NOTE BOOK SPACES CHECKED _____
 NO. _____

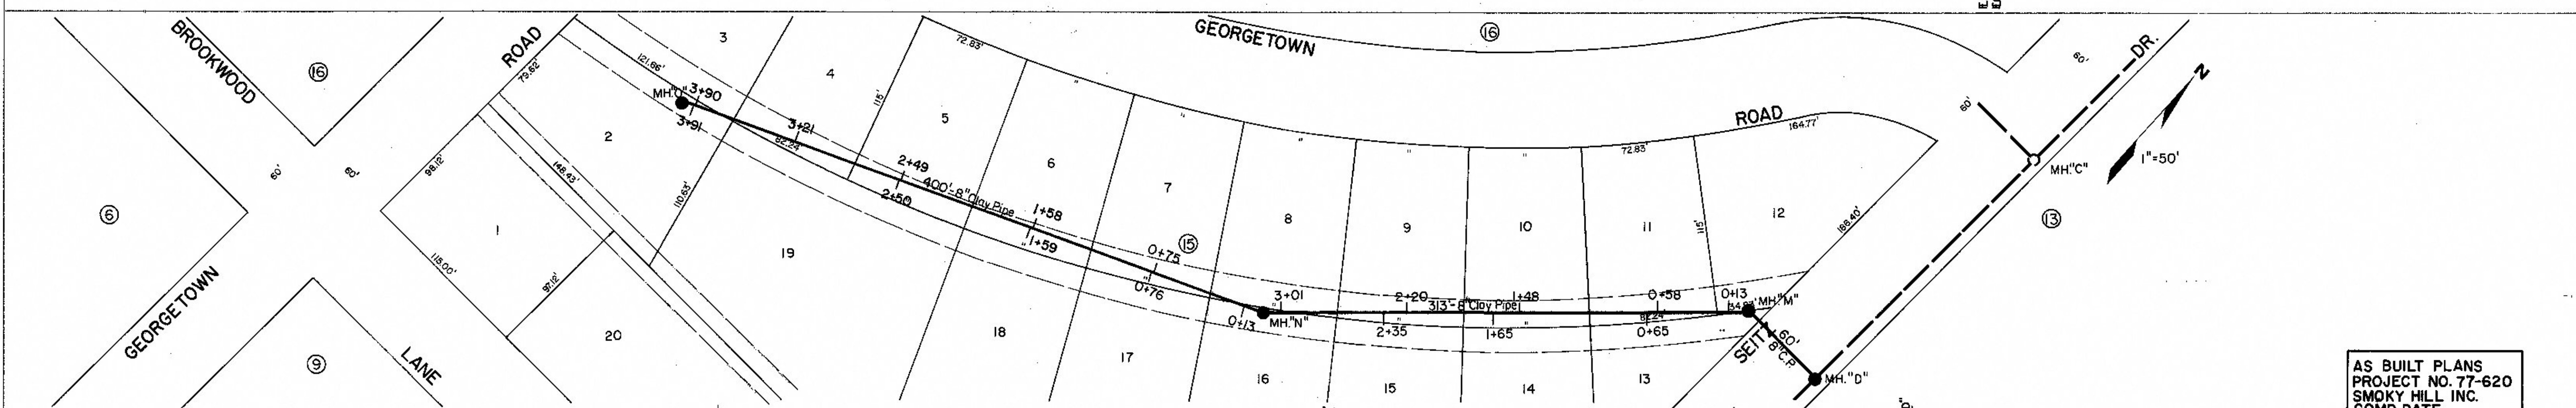

AS BUILT PLANS
 PROJECT NO. 77-620
 SMOKY HILL INC.
 COMP. DATE _____