
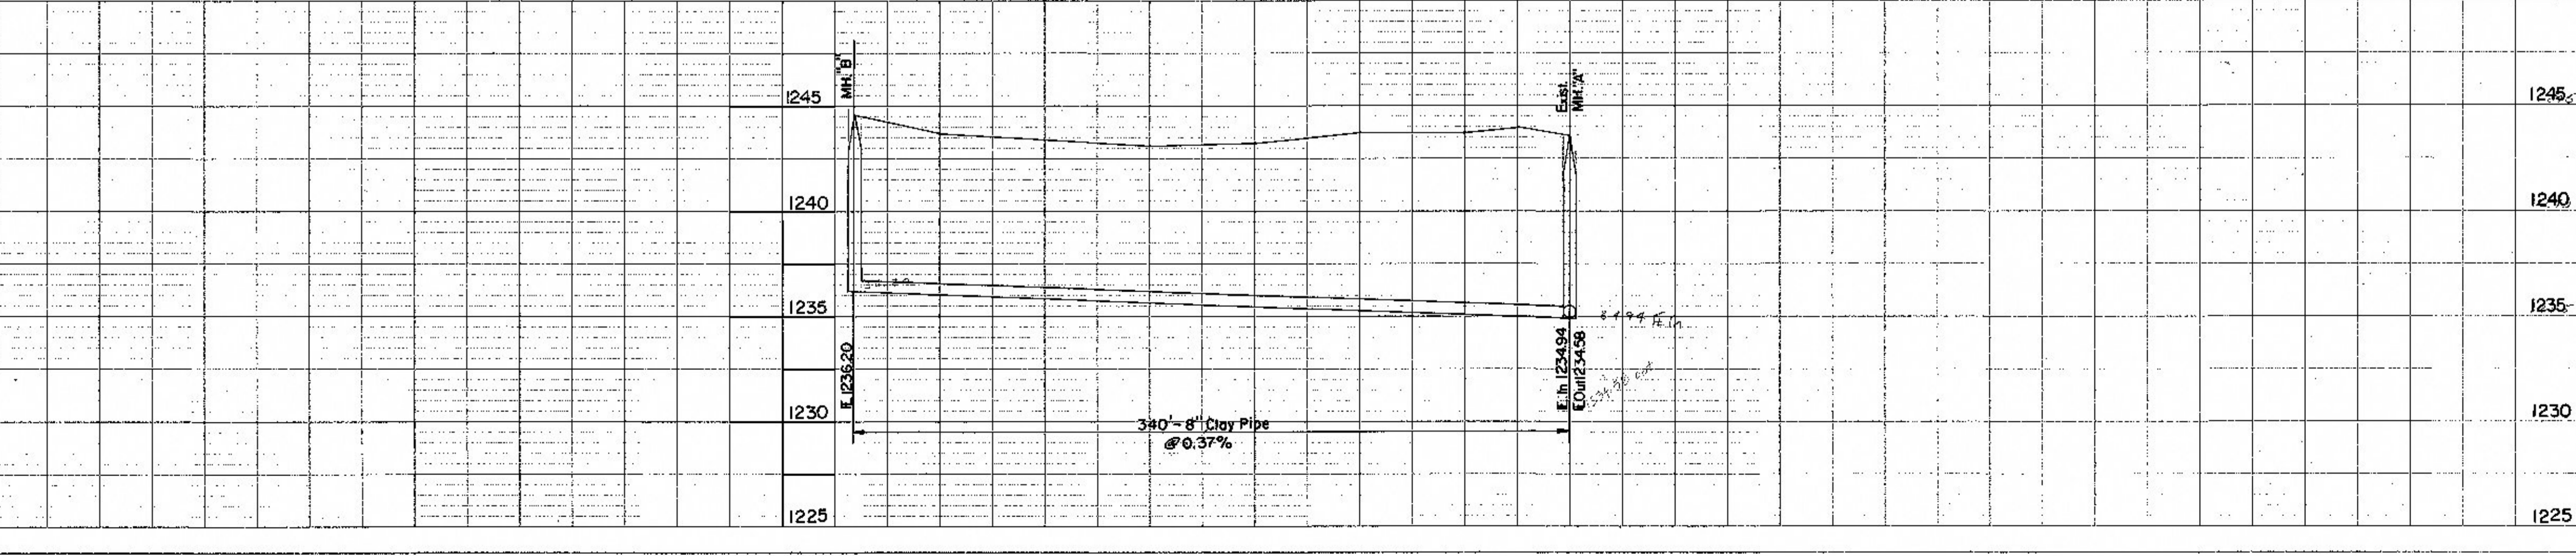
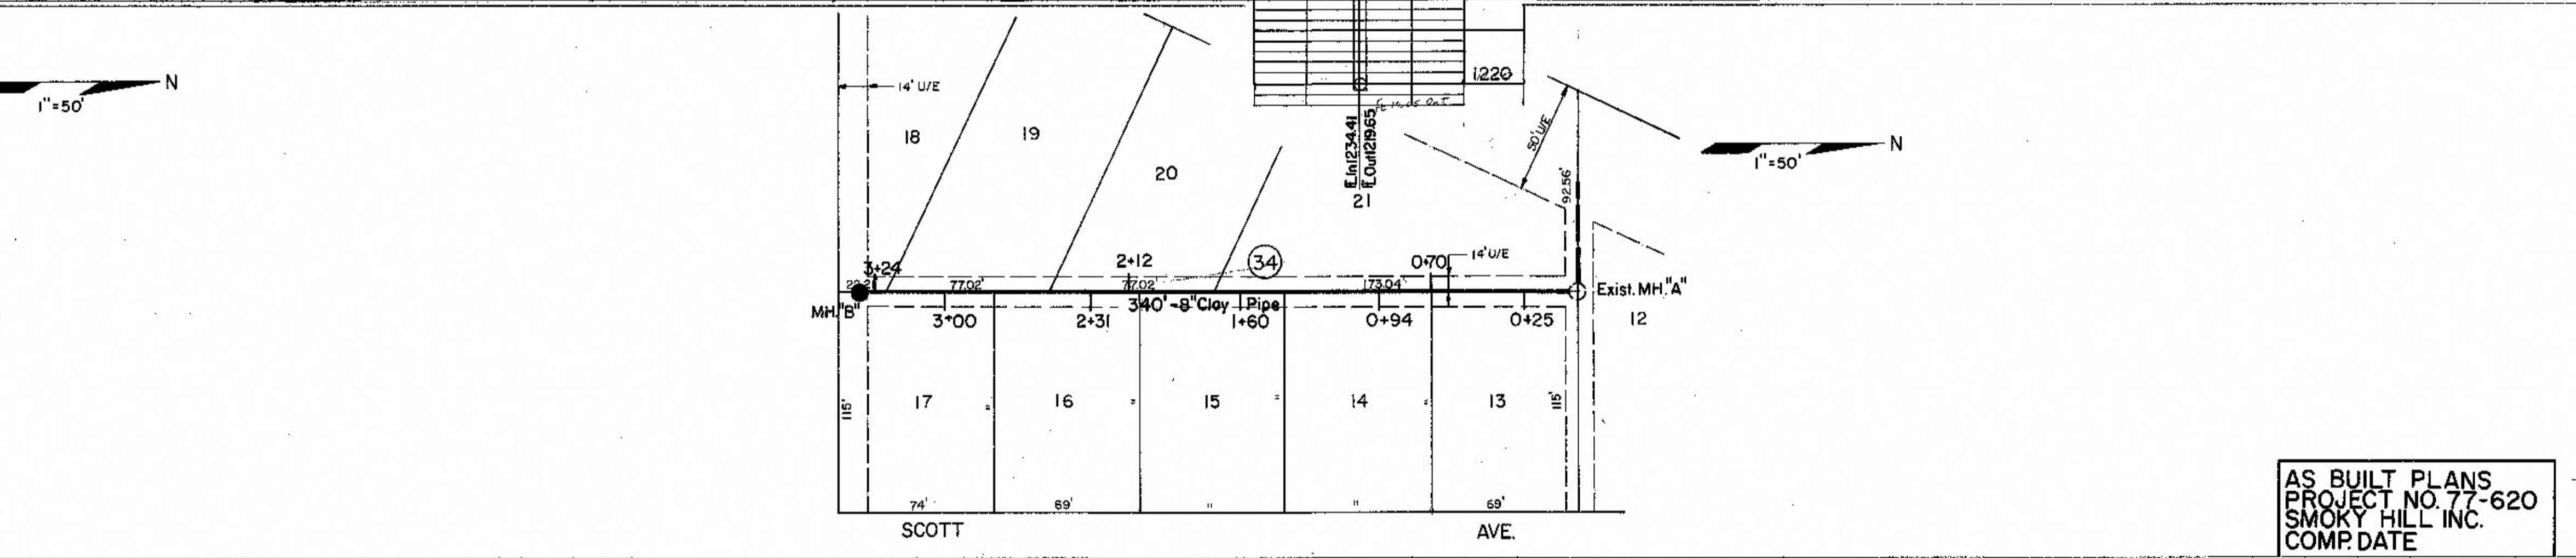
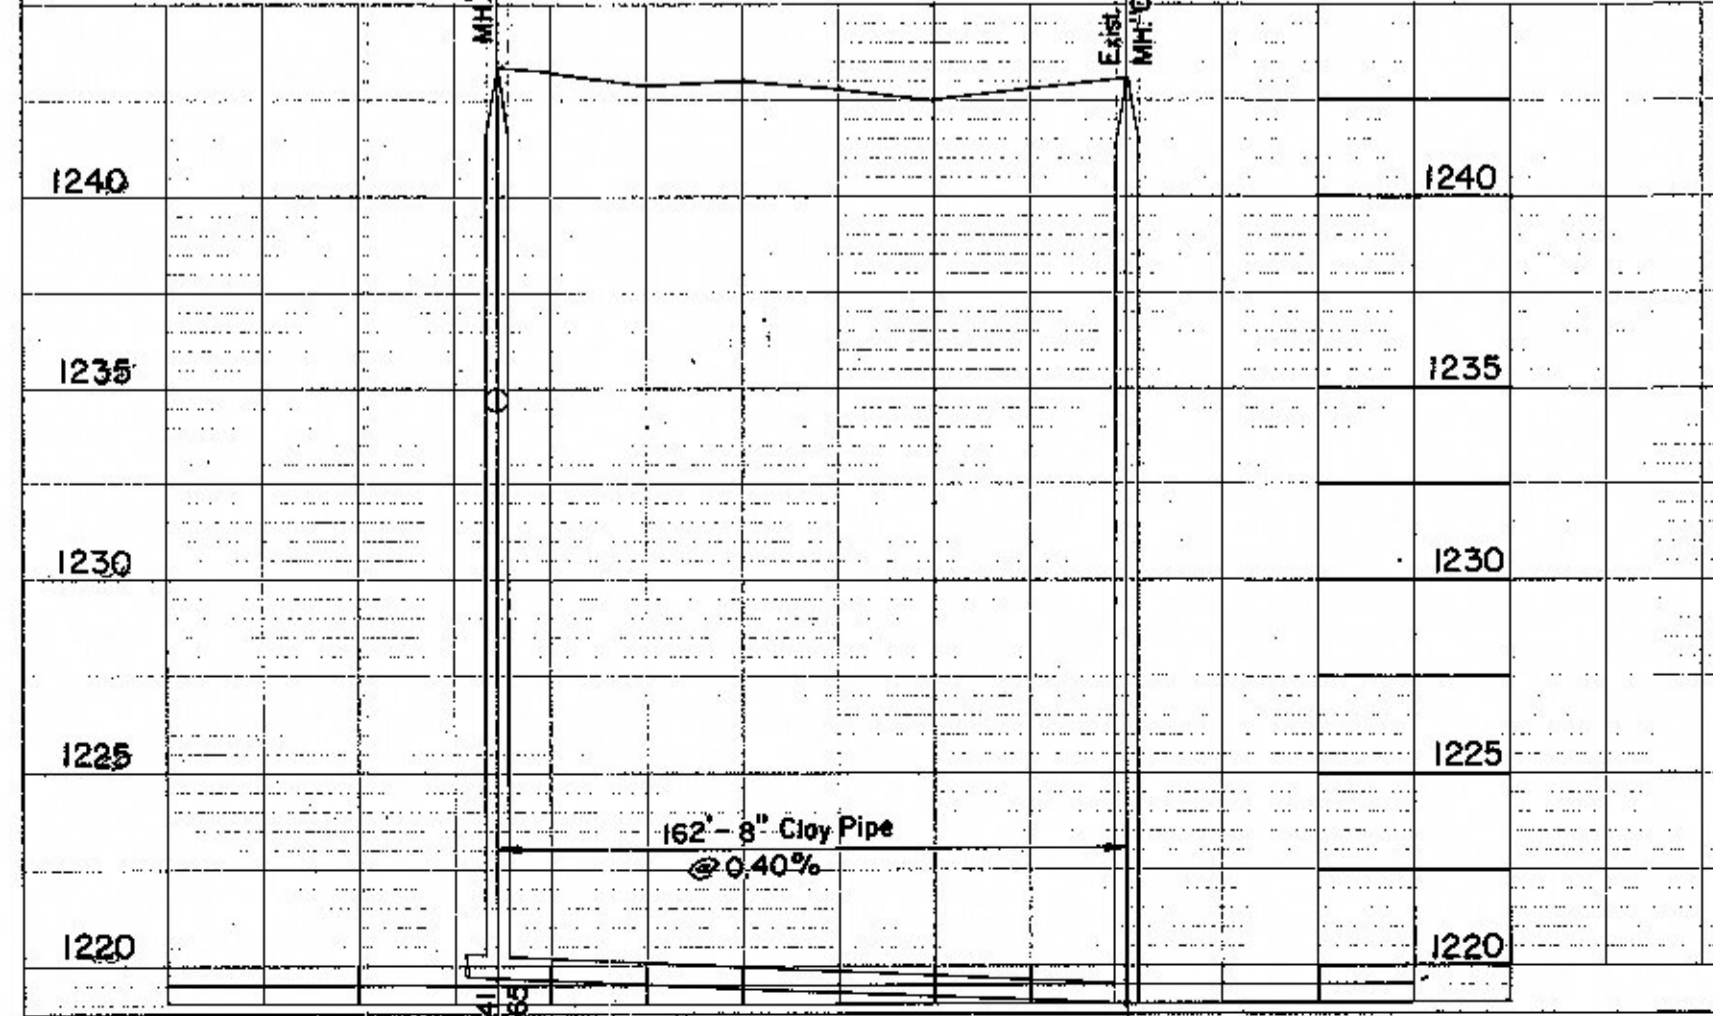
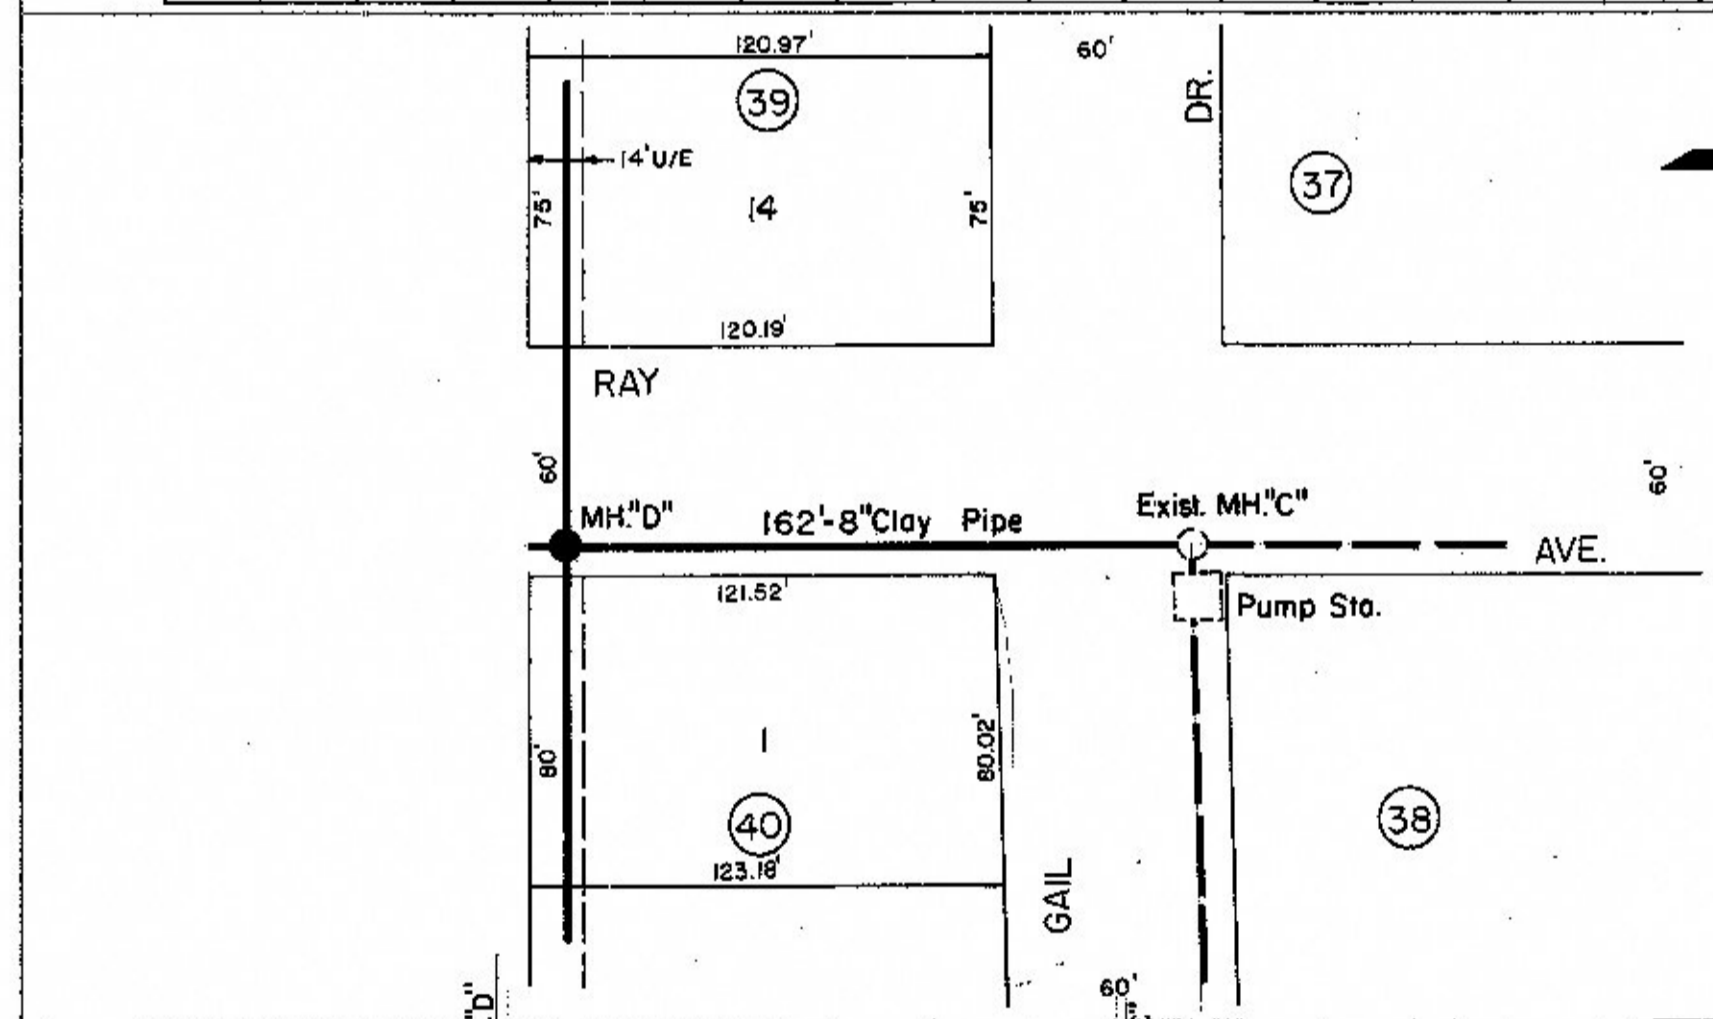
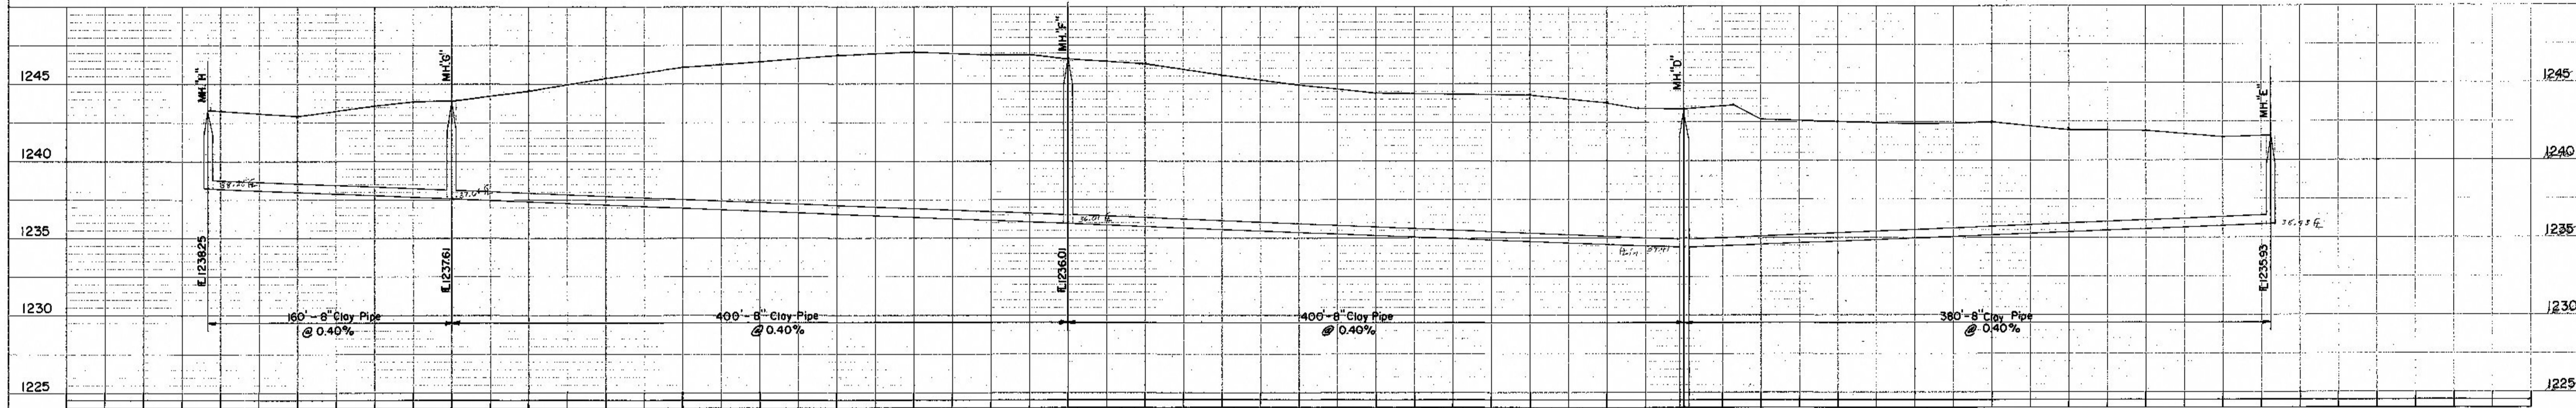


PLAN  
 SURVEYED BY  
 DATE  
 CHECKED BY  
 DATE  
 NOTE BOOK NO.  
 ALIGNMENT CHECKED BY  
 RET. BY  
 WAY CHECKED BY

PROFILE  
 SURVEYED BY  
 DATE  
 CHECKED BY  
 DATE  
 NOTE BOOK NO.  
 ADJUSTED BY  
 STRUCTURE NOTED ON P.O.

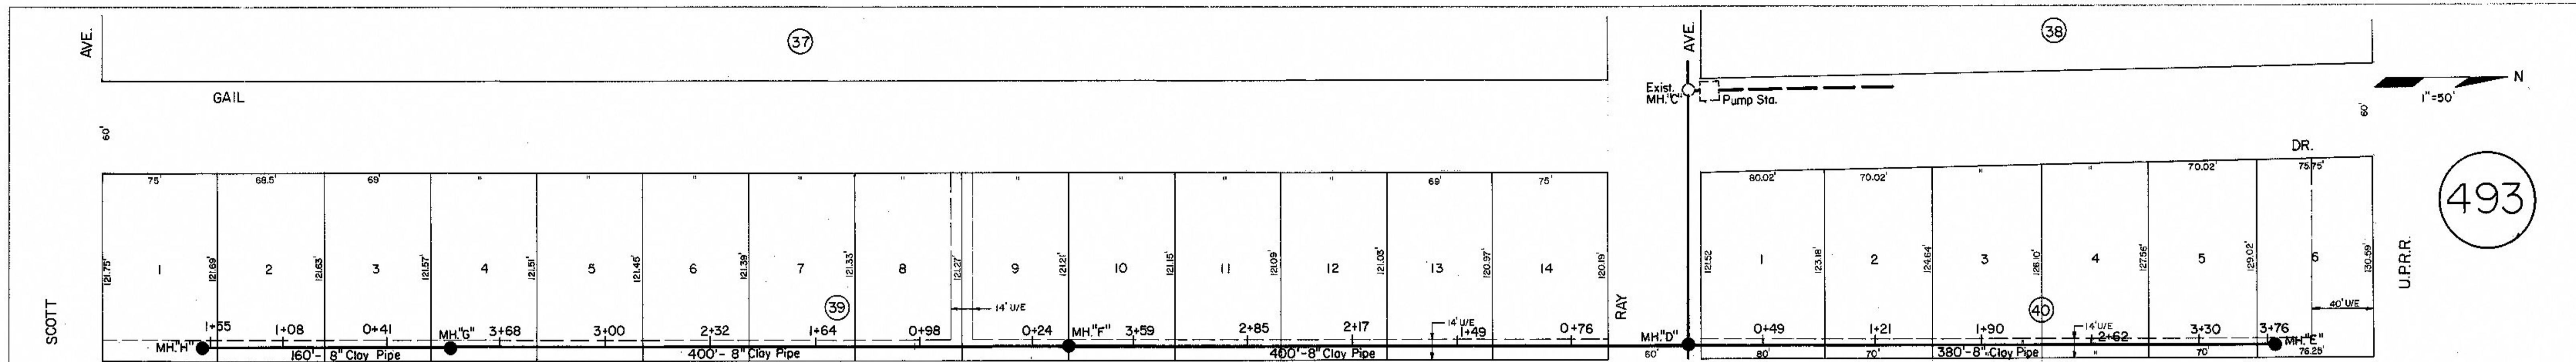

AS BUILT PLANS  
 PROJECT NO. 77-620  
 SMOKY HILL INC.  
 COMP. DATE