





DATE	
BY	
SURVEYED	
NOTE BOOK	
AS BUILT	
REVISIONS	
NO.	

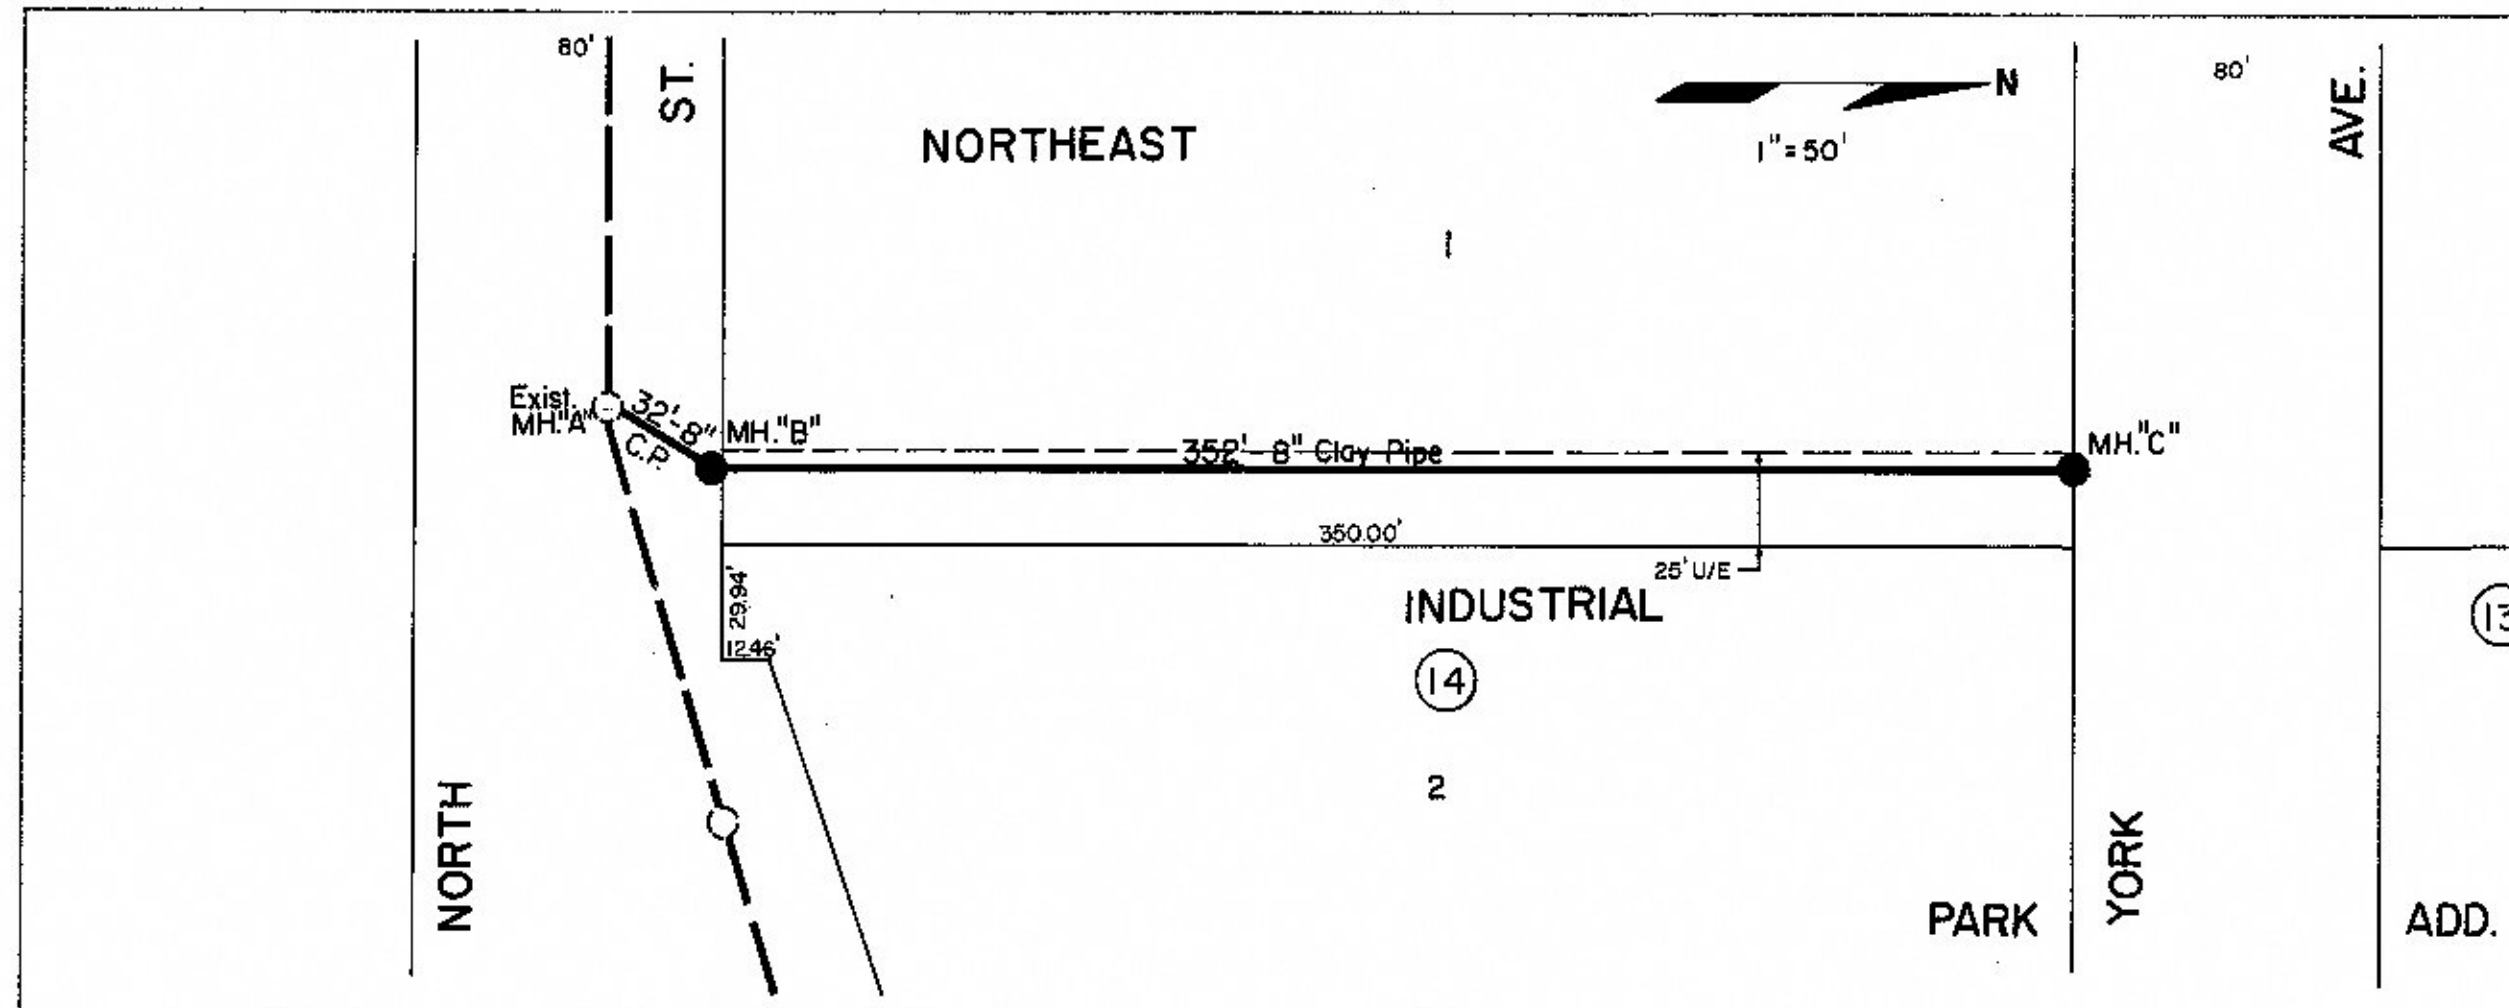




AS BUILT PLANS  
PROJECT NO. 77-621  
WILSON CONST. INC.  
COMP. DATE

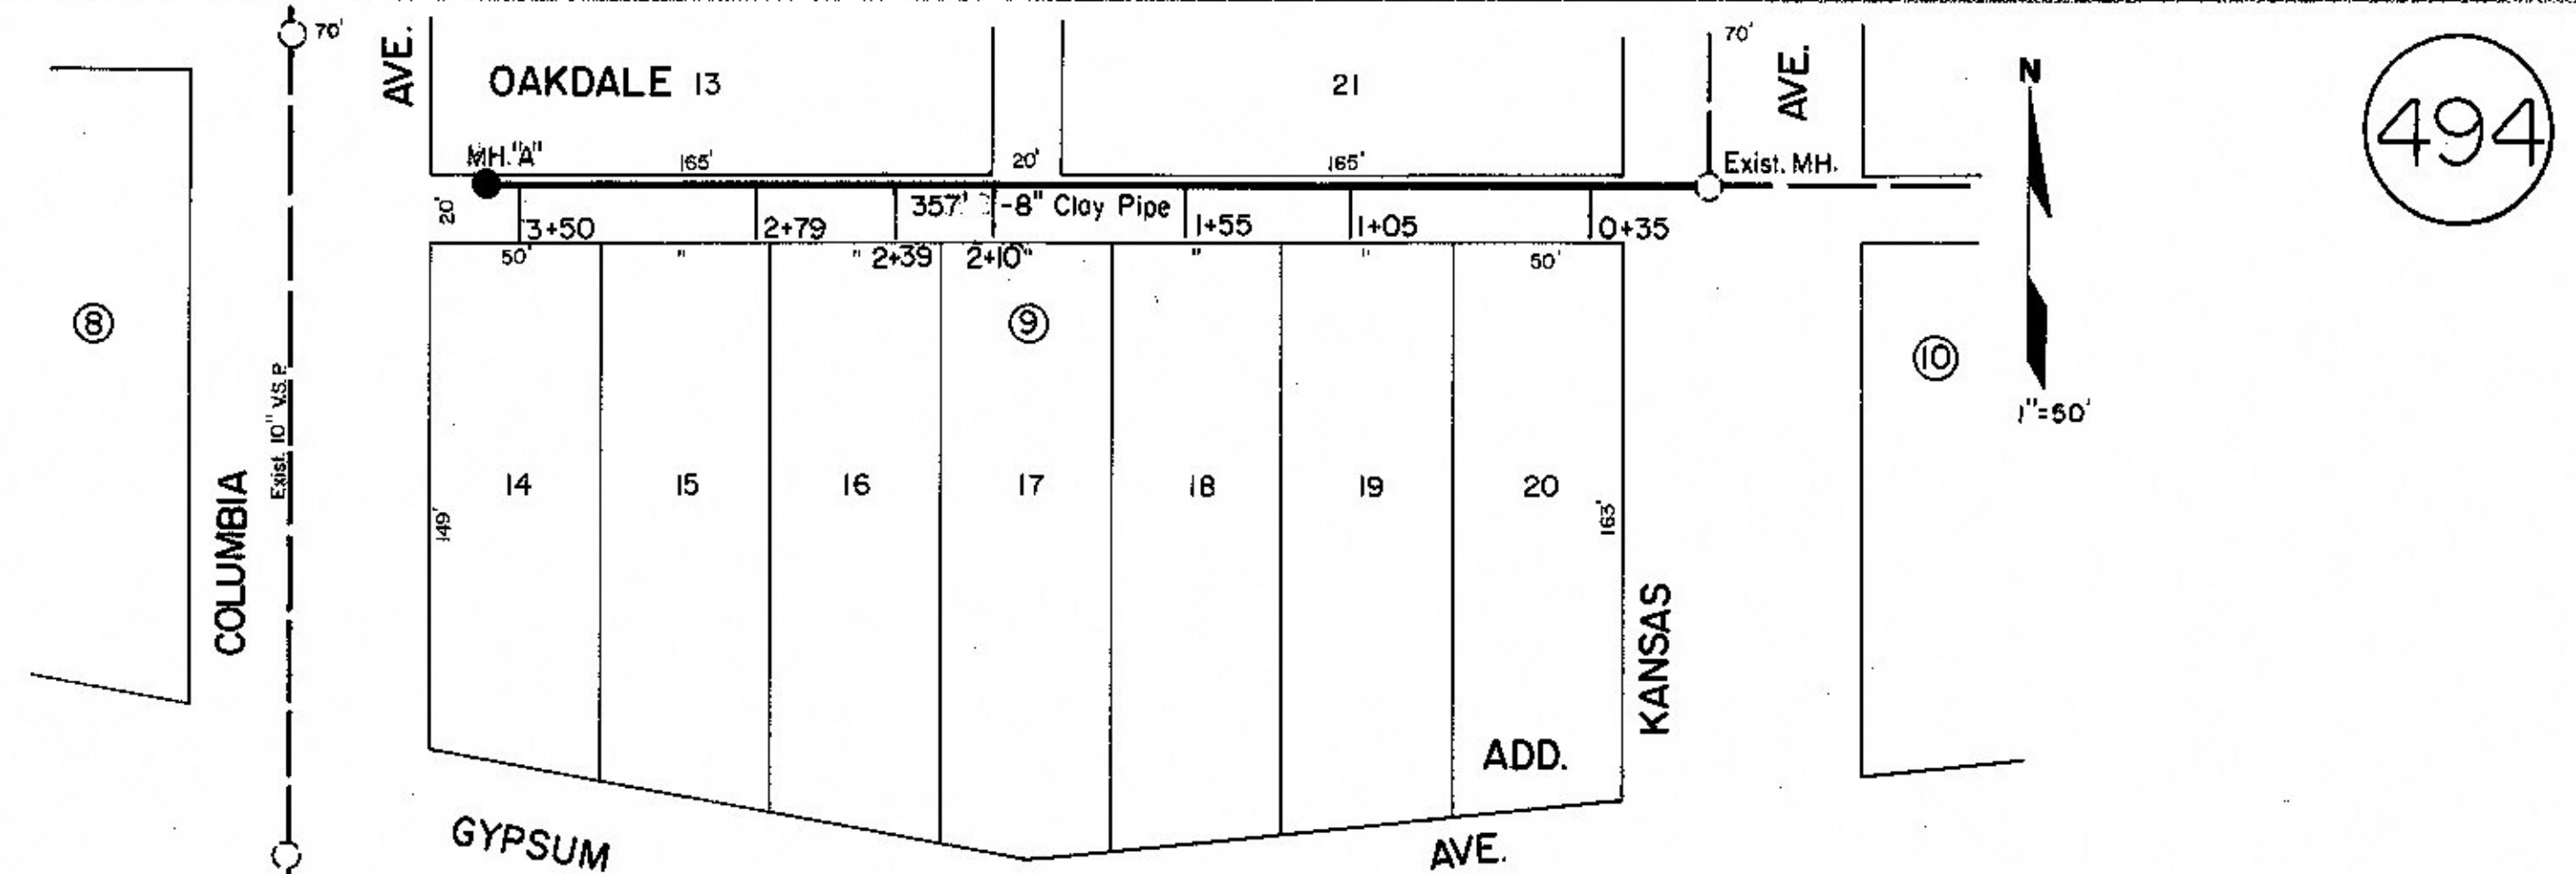

494

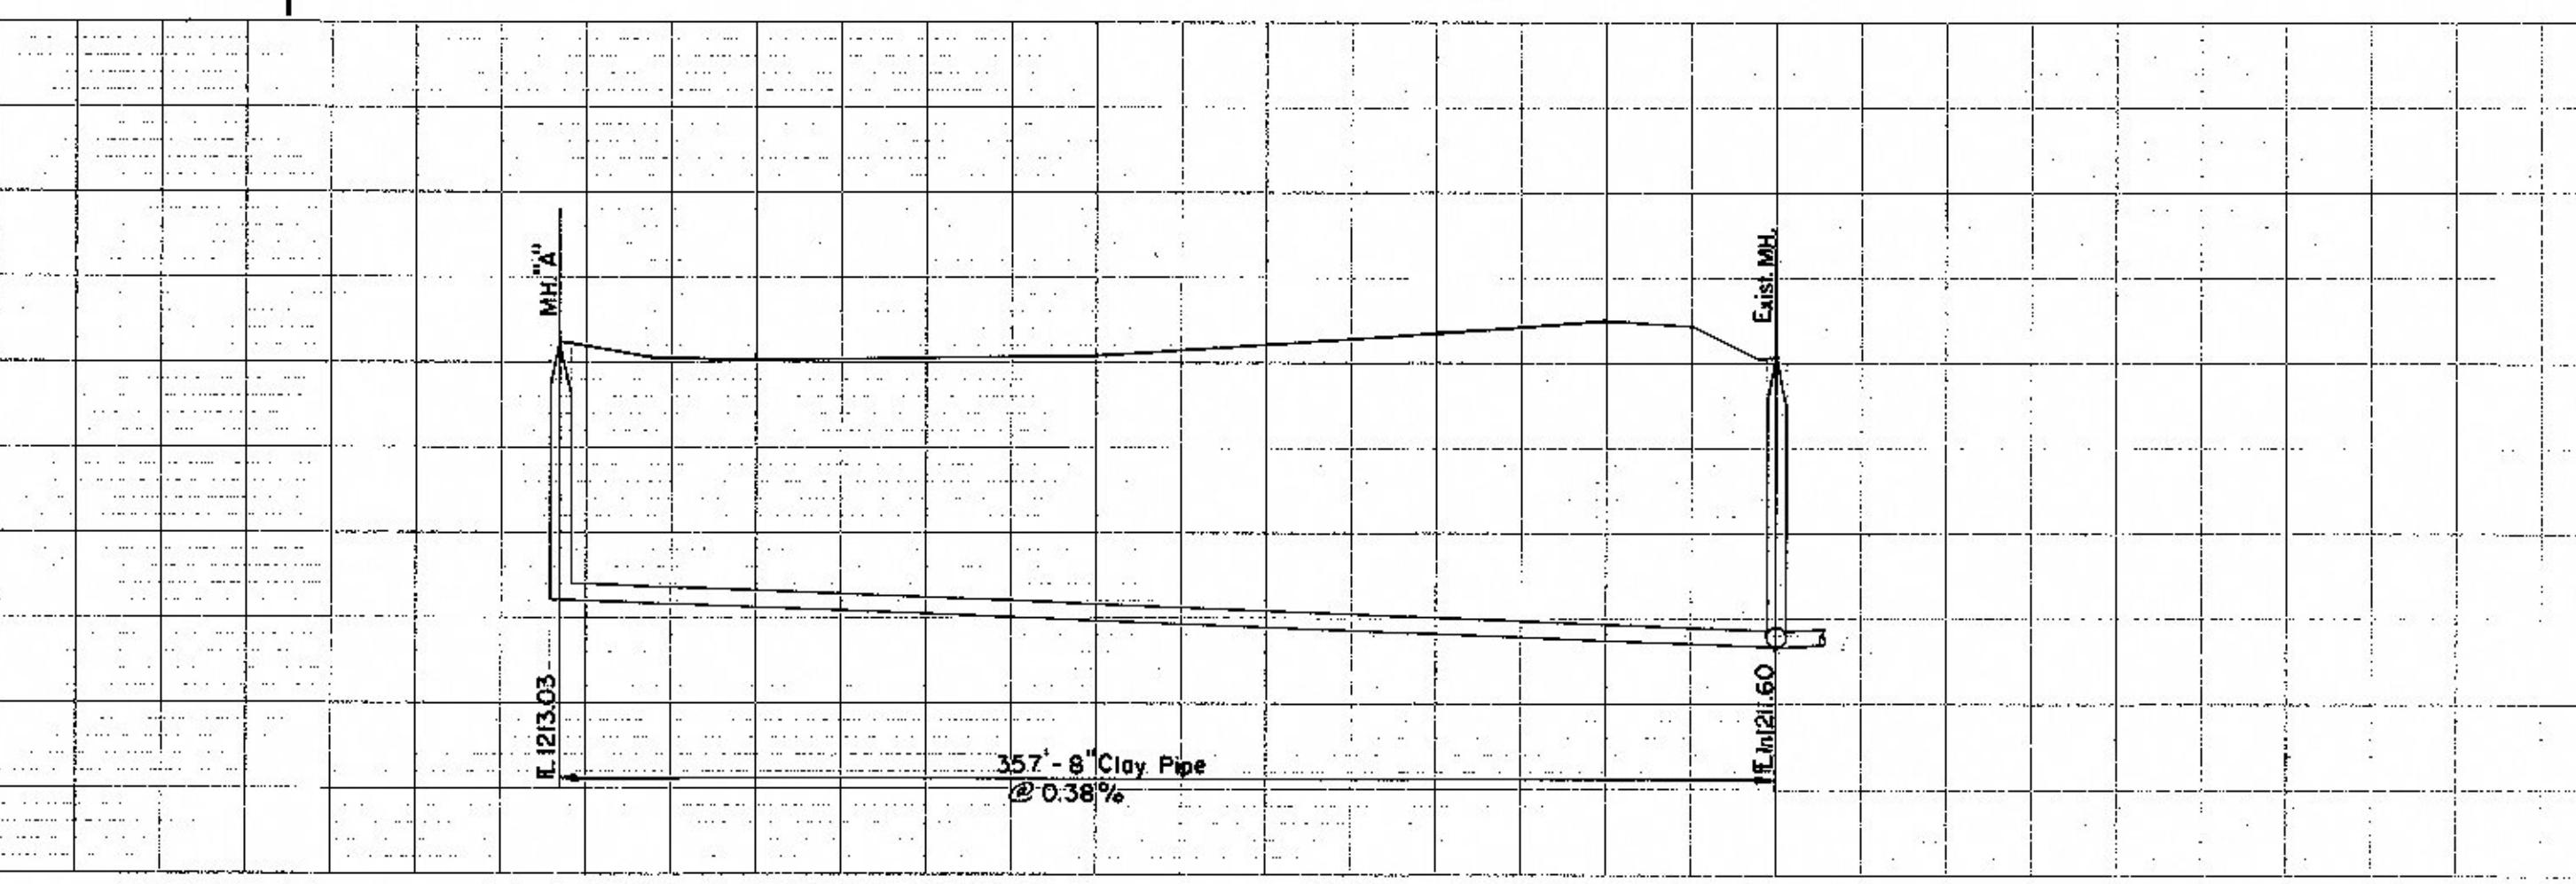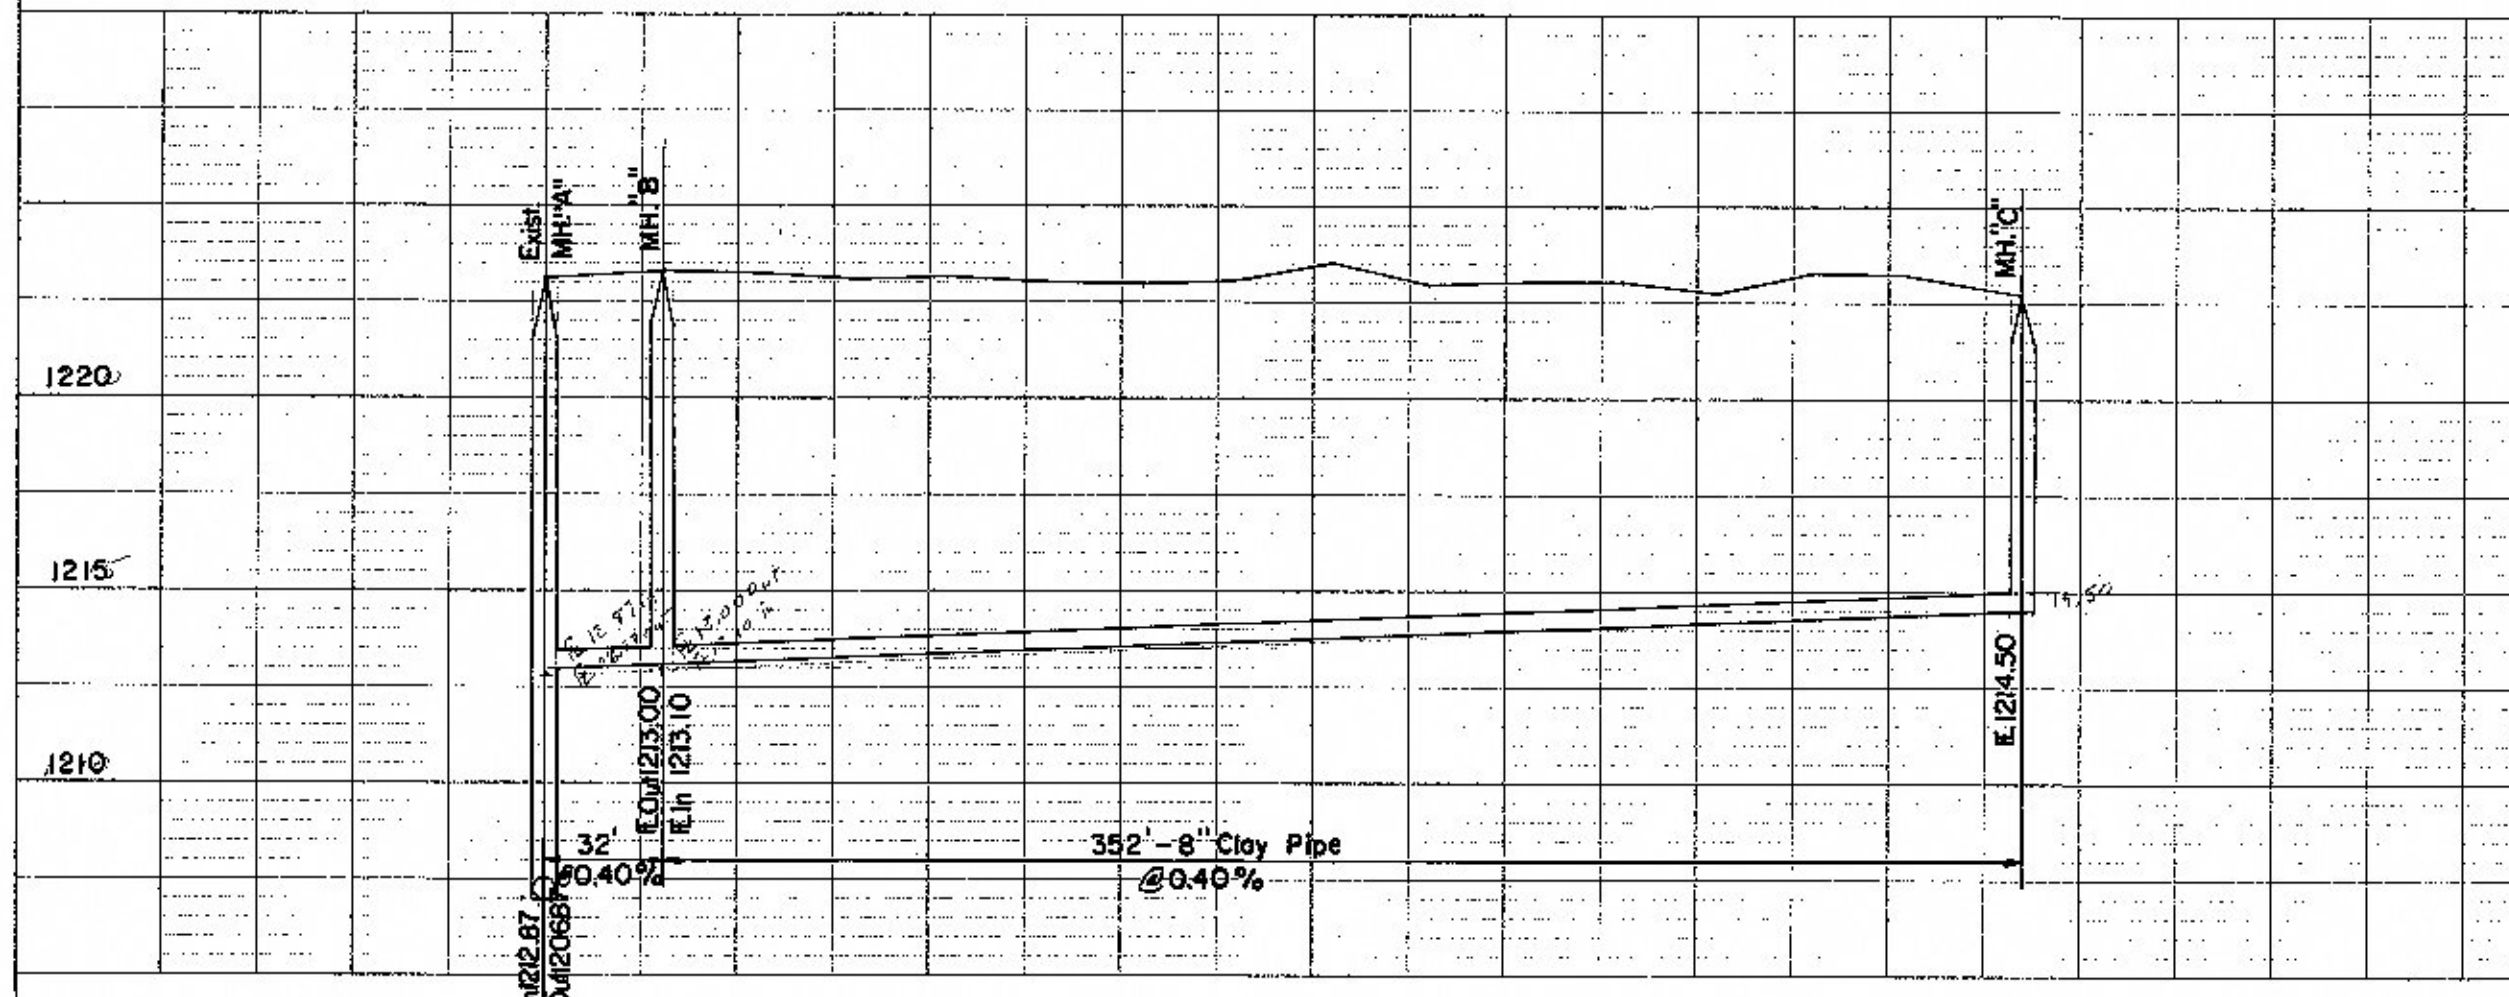

DATE	
BY	
SURVEYED	
NOTE BOOK	
AS BUILT	
REVISIONS	
NO.	

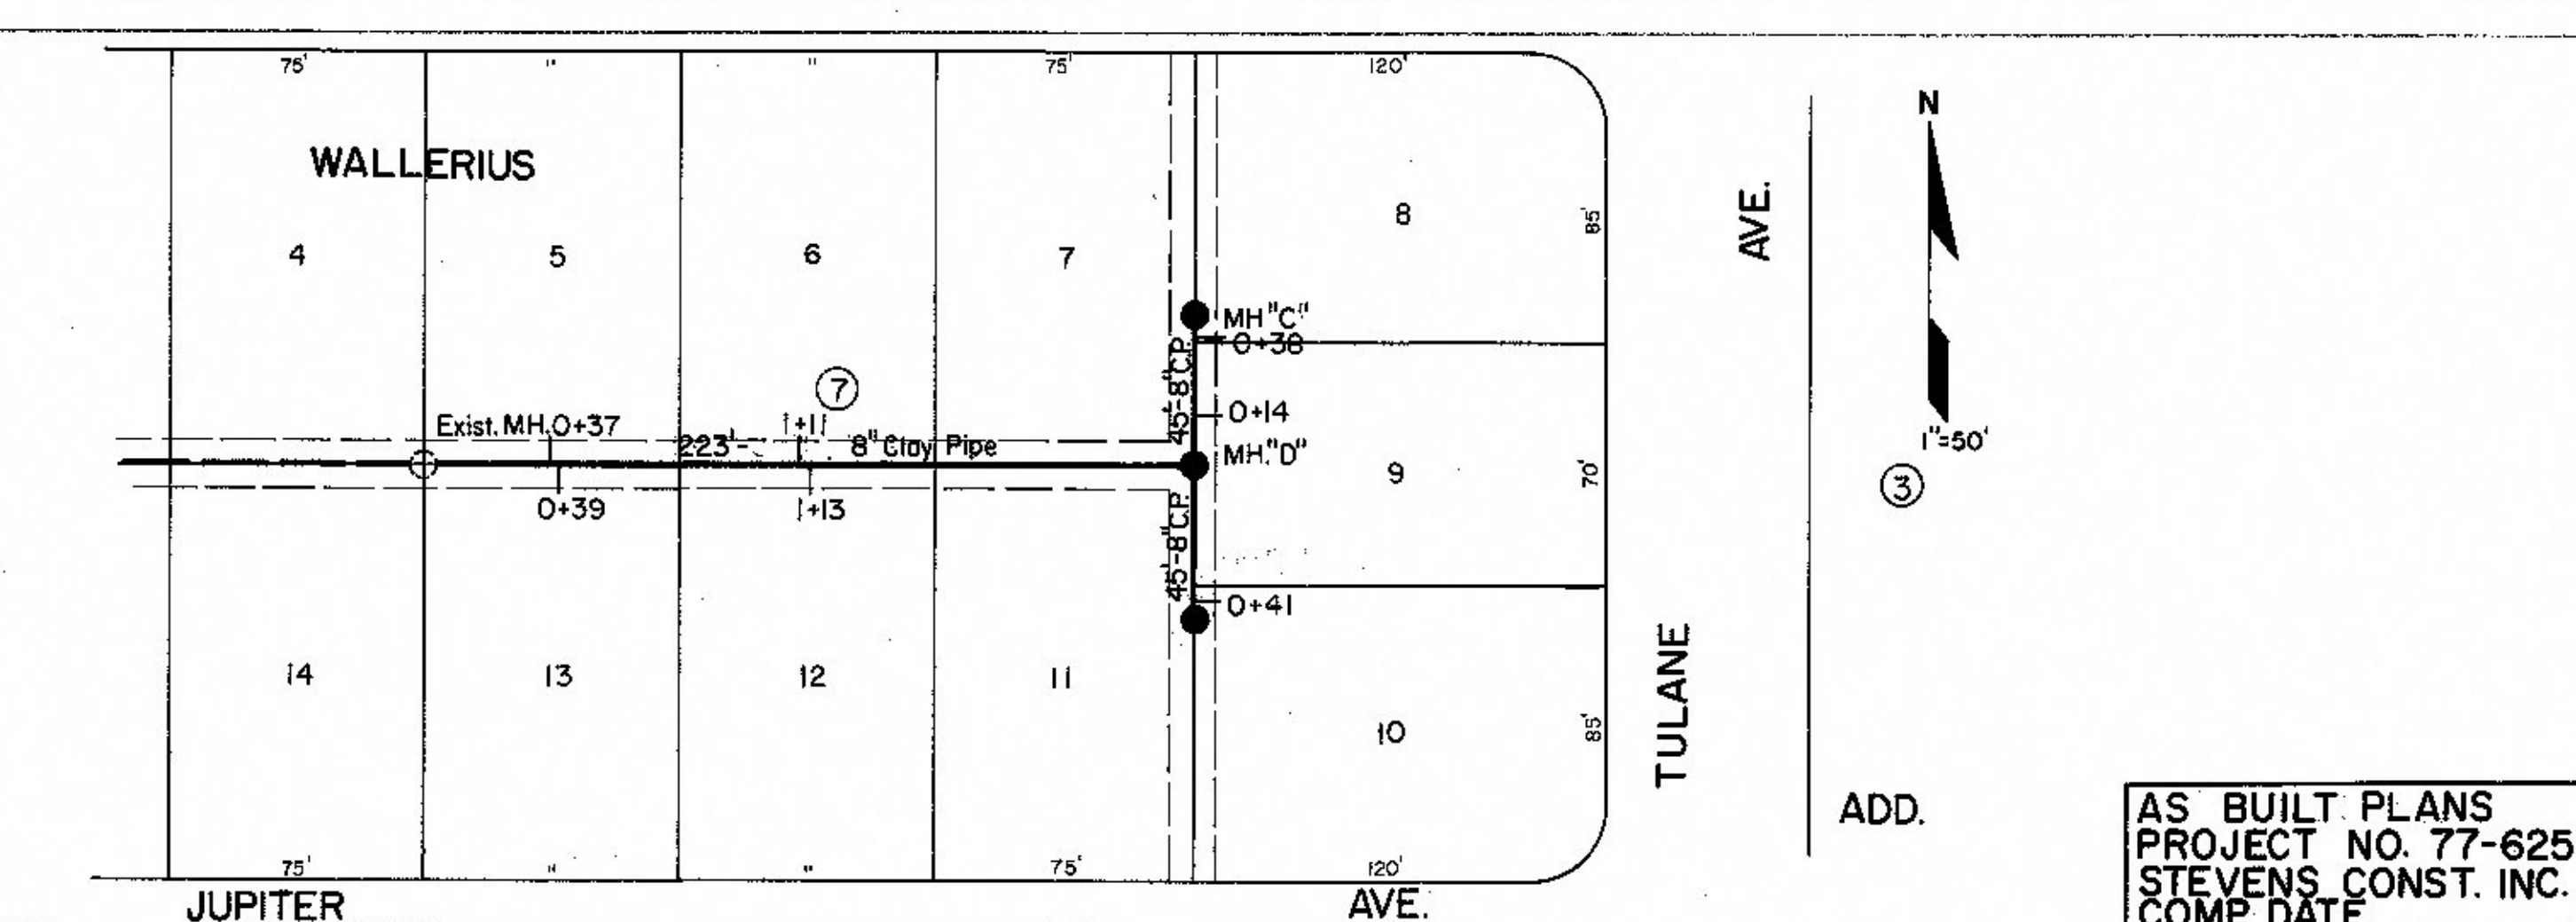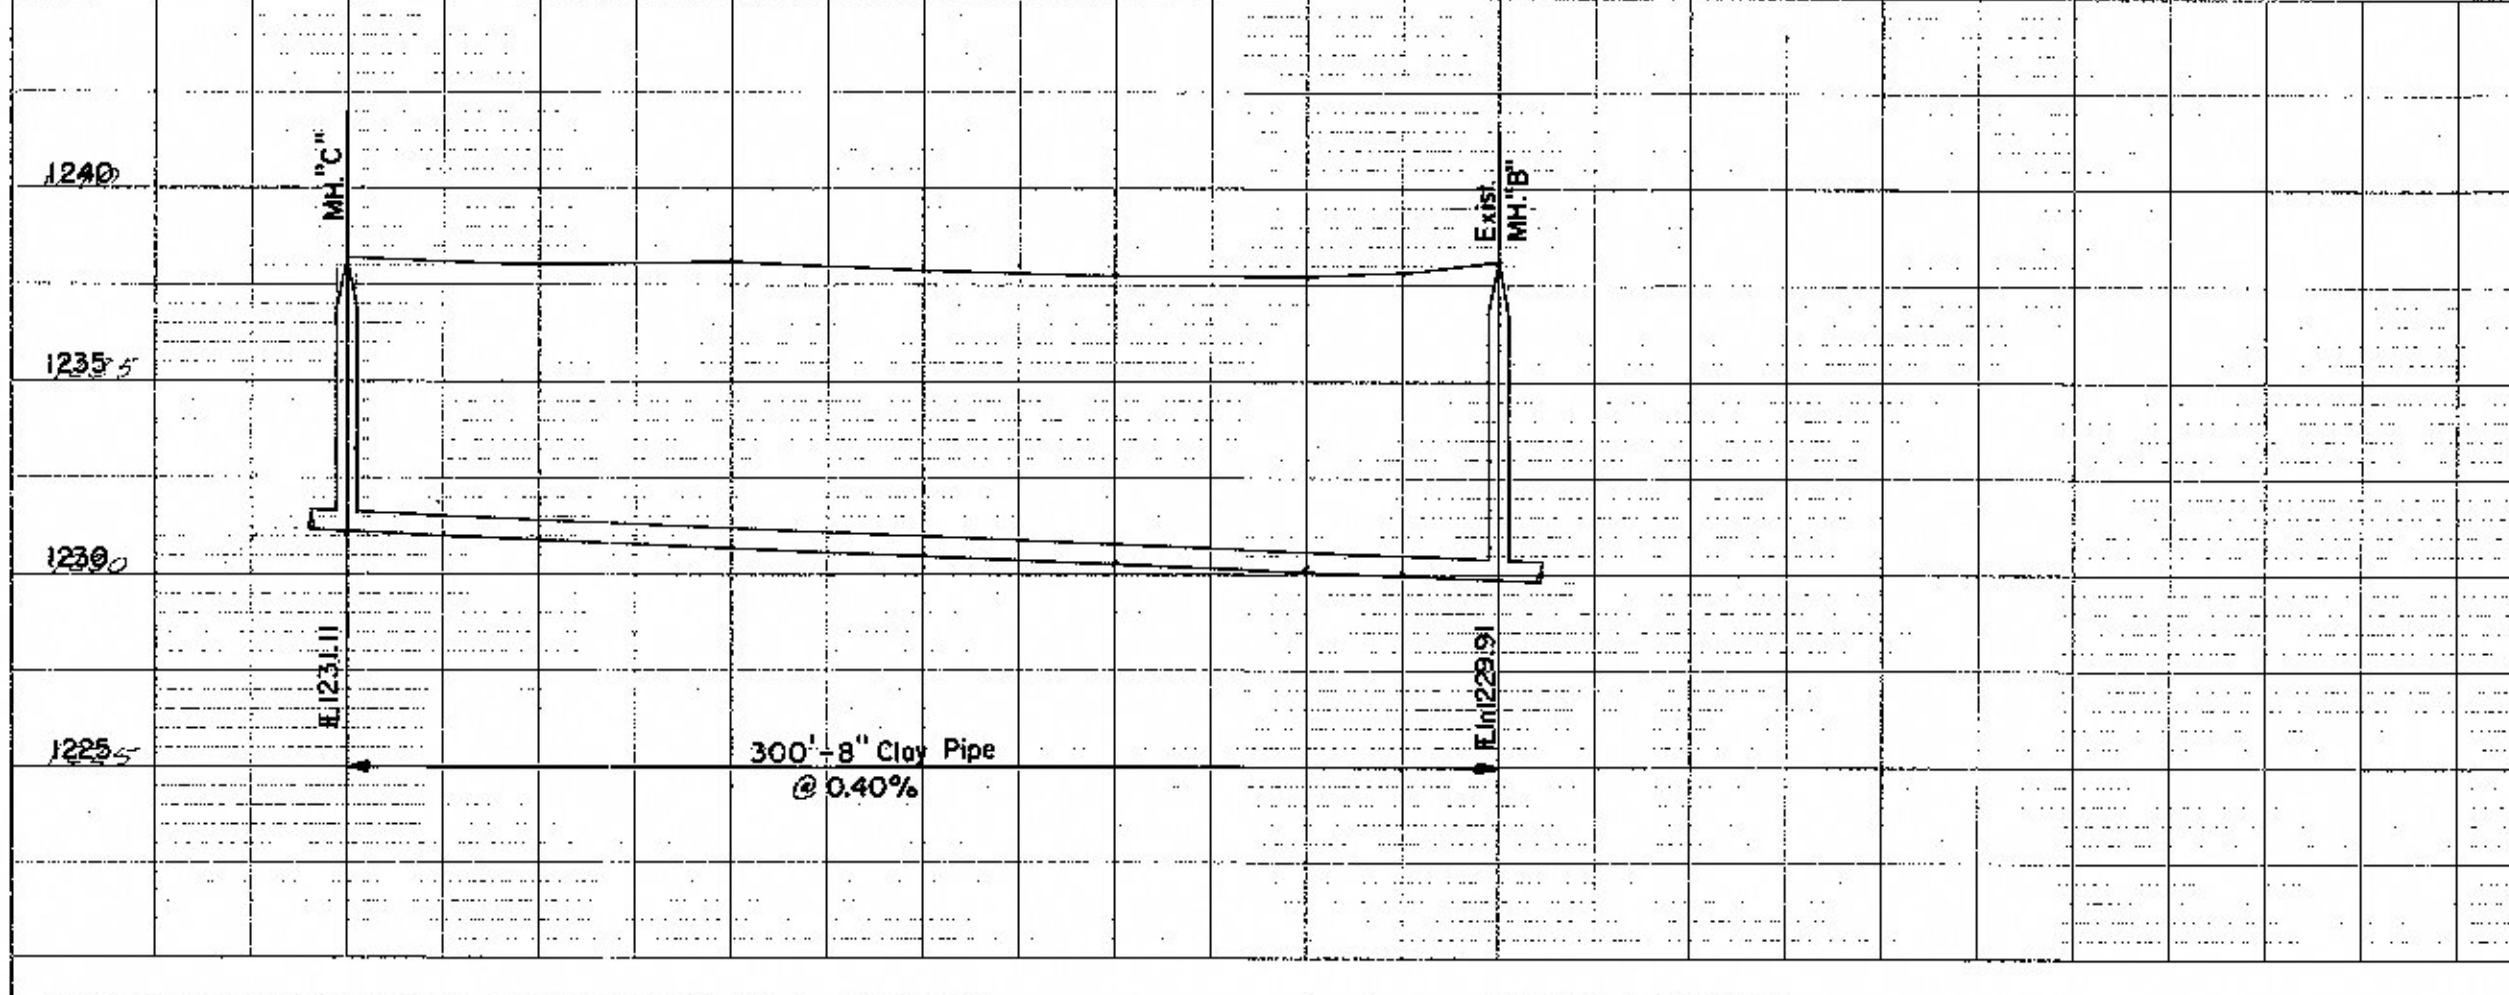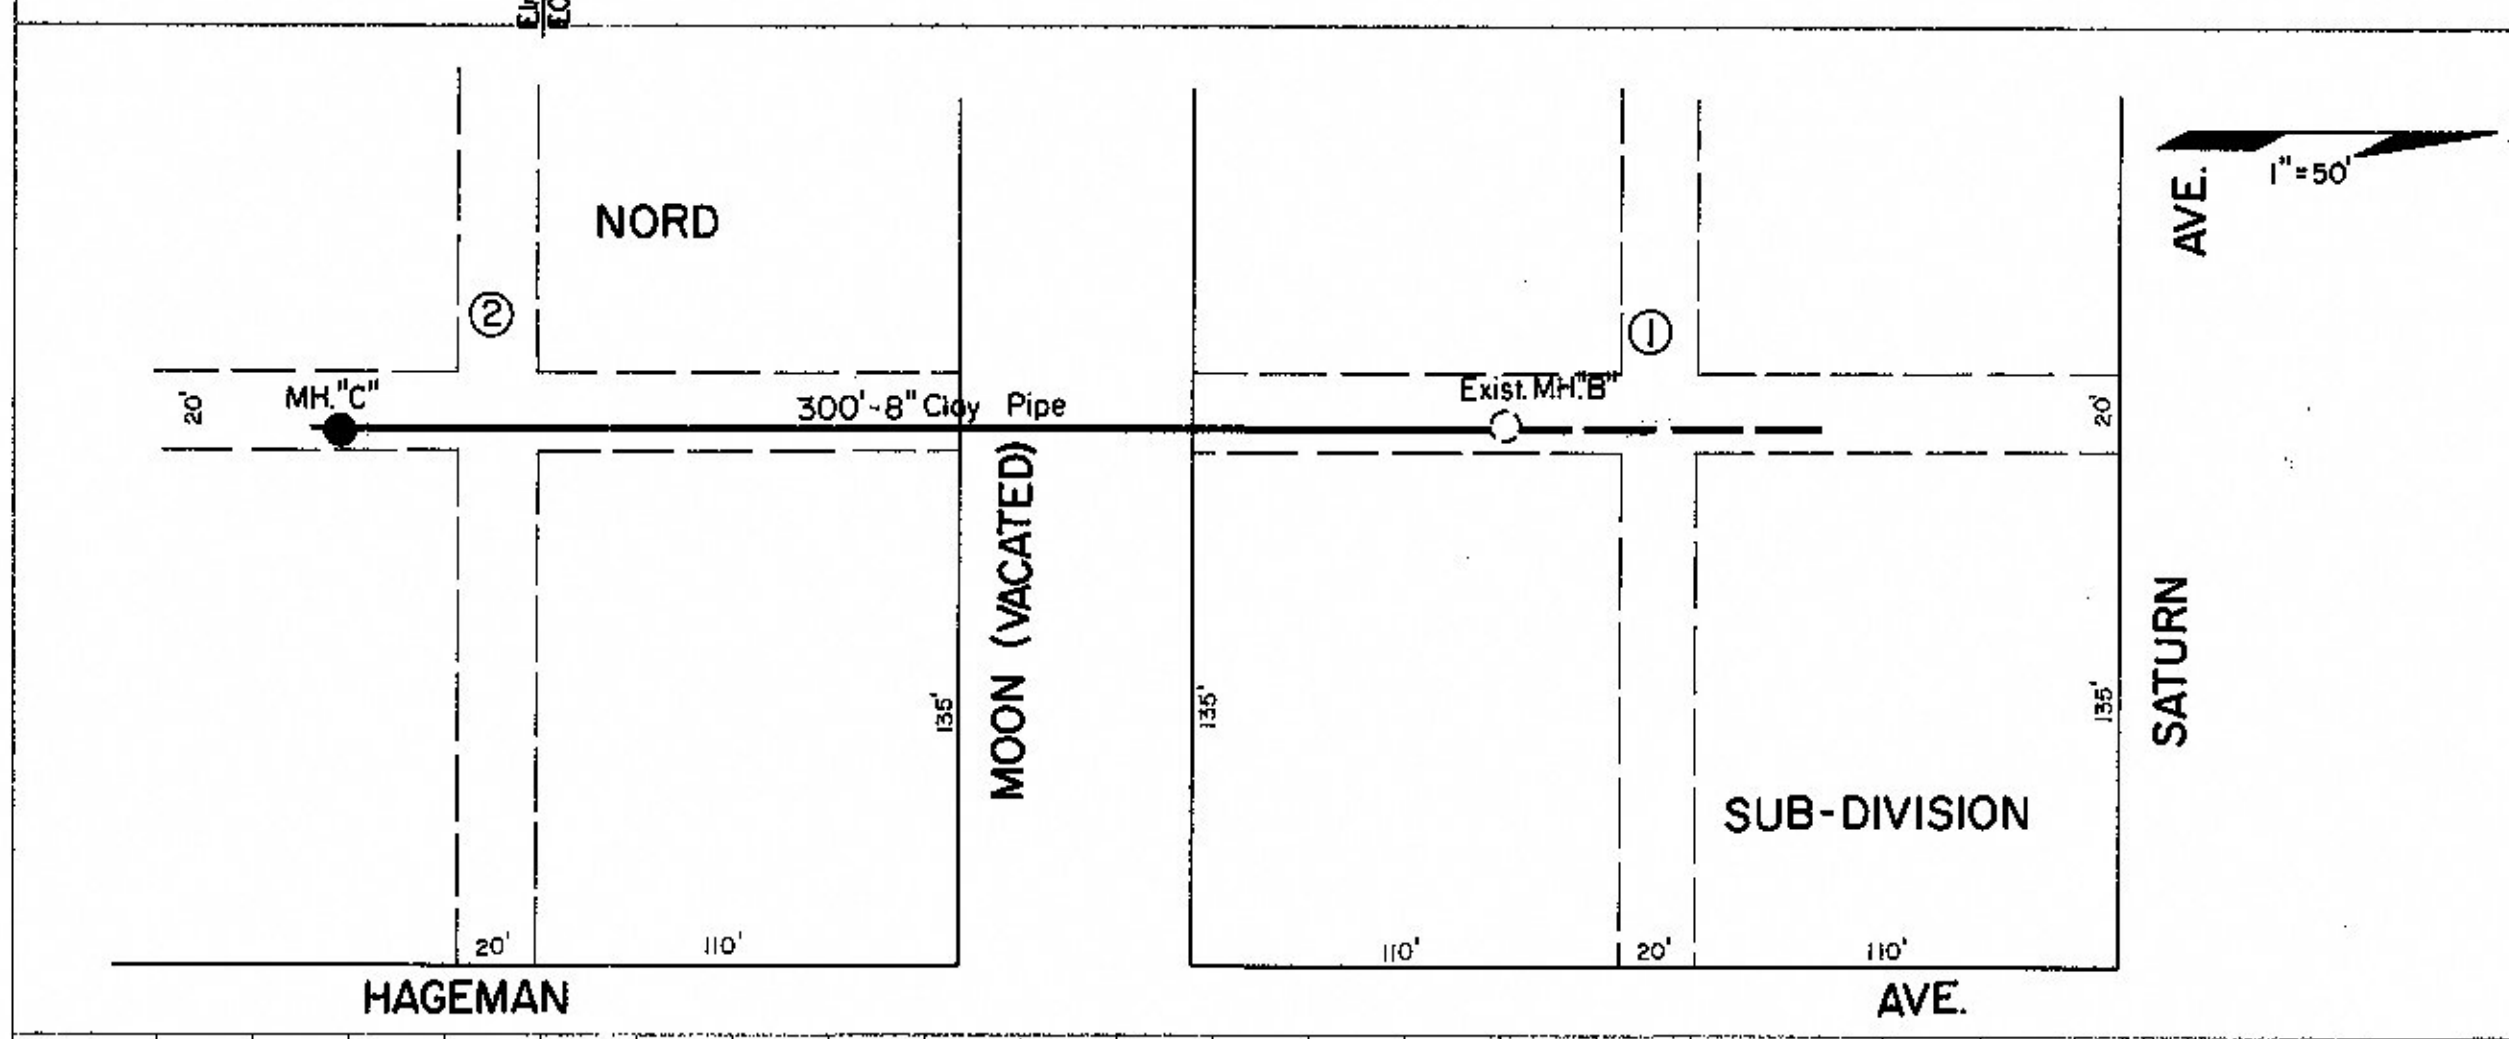

AS BUILT PLANS  
PROJECT NO. 77-625  
STEVENS CONST. INC.  
COMP. DATE

