
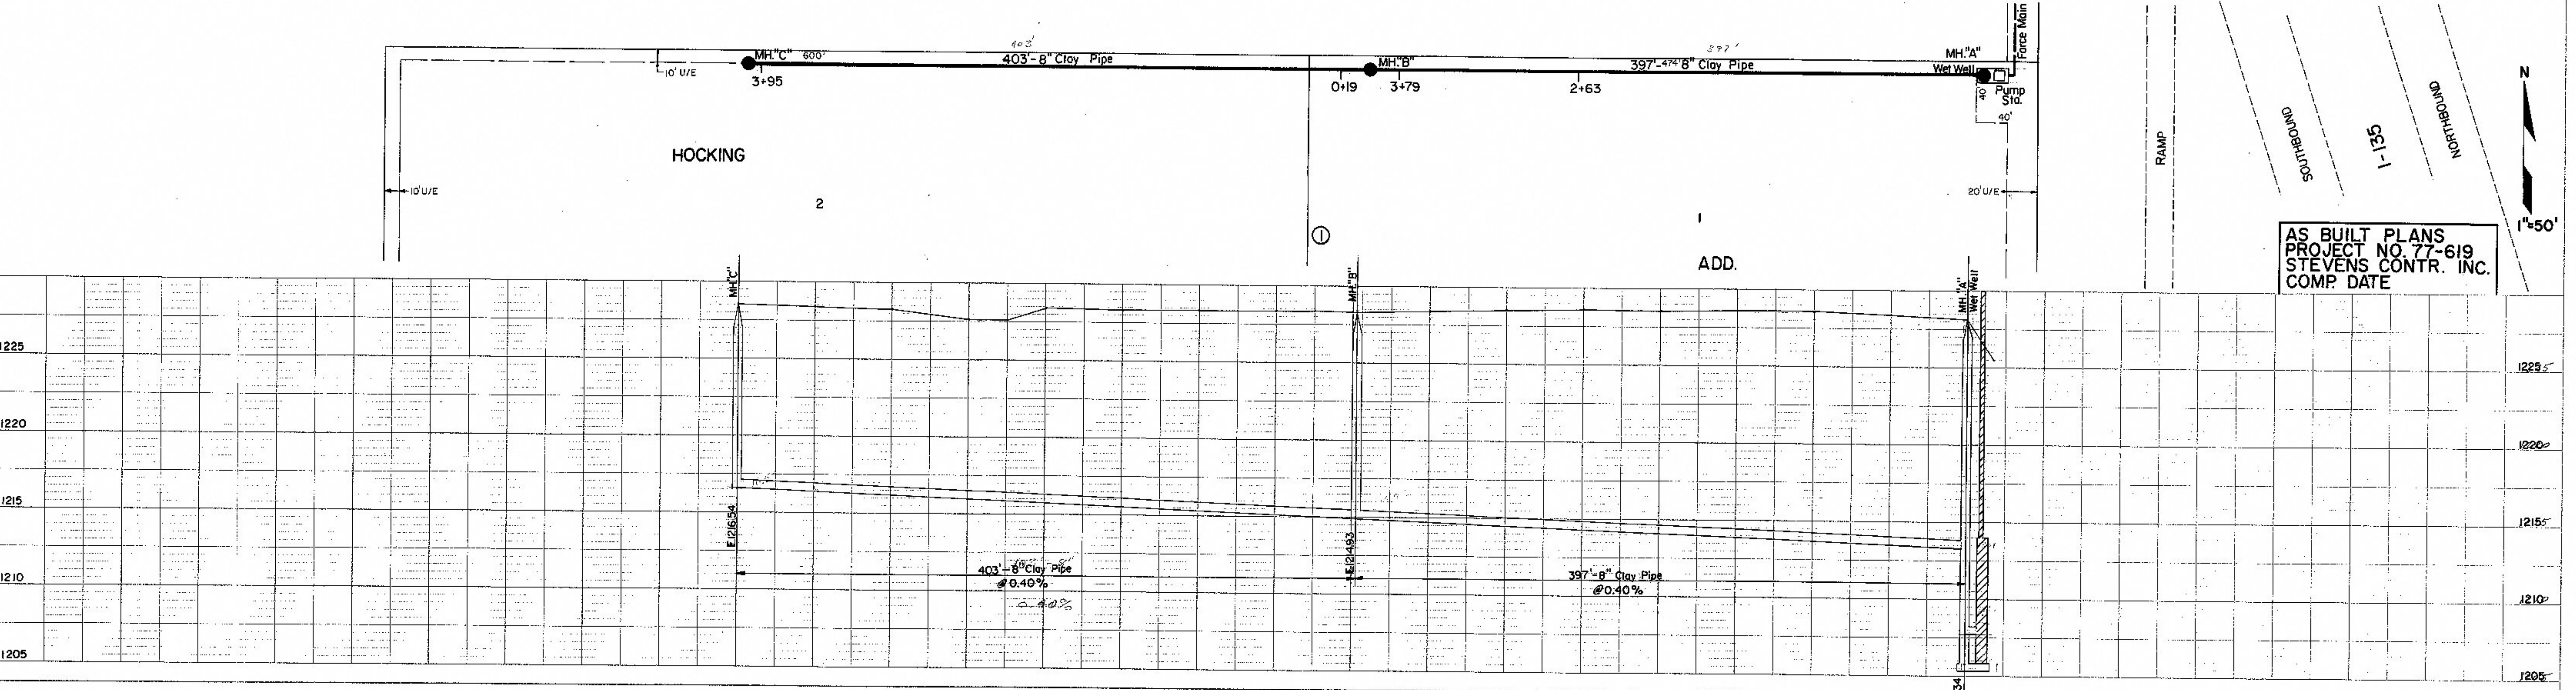


AS BUILT PLANS
PROJECT NO. 77-616
SMOKY HILL INC.
COMP. DATE

PLAN
BY: _____ DATE: _____
CHECKED: _____
NOTE BOOK: _____
NO. _____

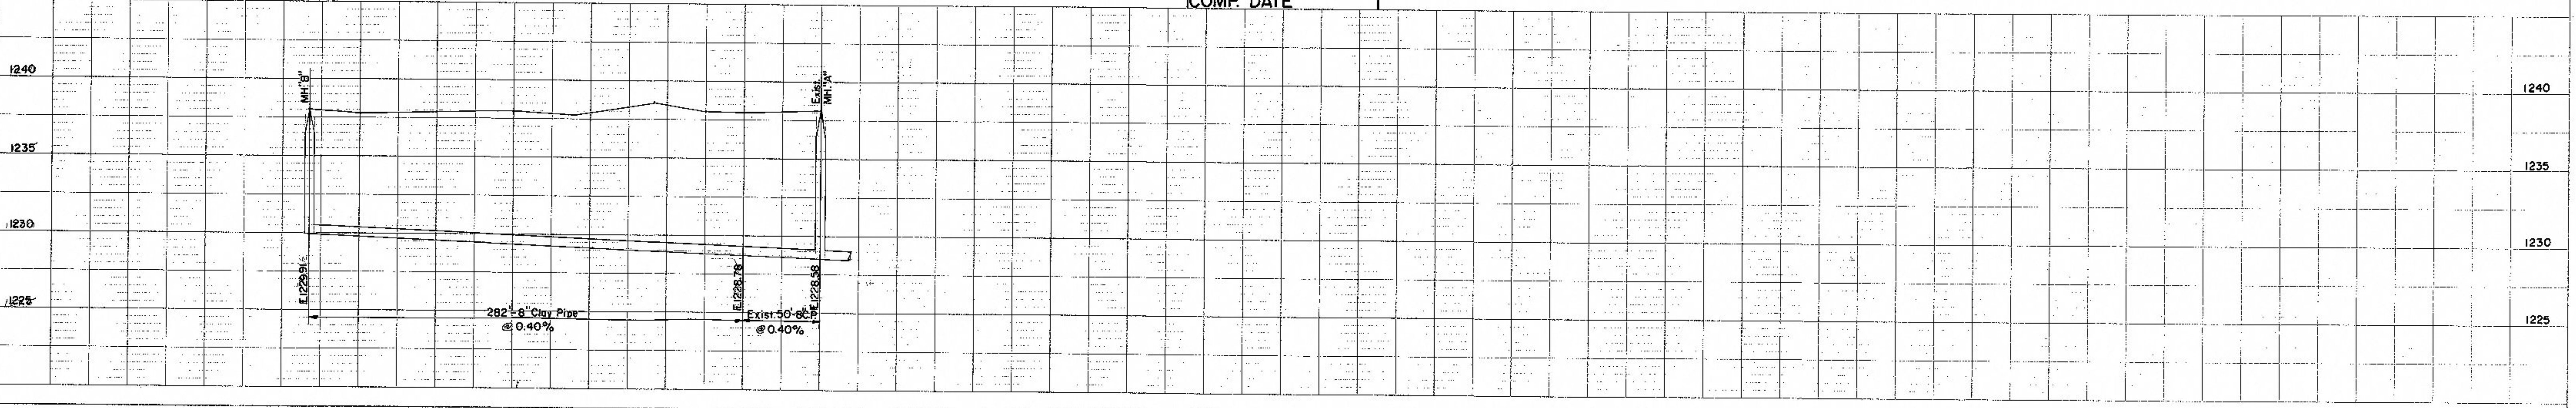

AS BUILT PLANS
PROJECT NO. 77-619
STEVENS CONTR. INC.
COMP. DATE

PROFILE
BY: _____ DATE: _____
CHECKED: _____
NOTE BOOK: _____
NO. _____