
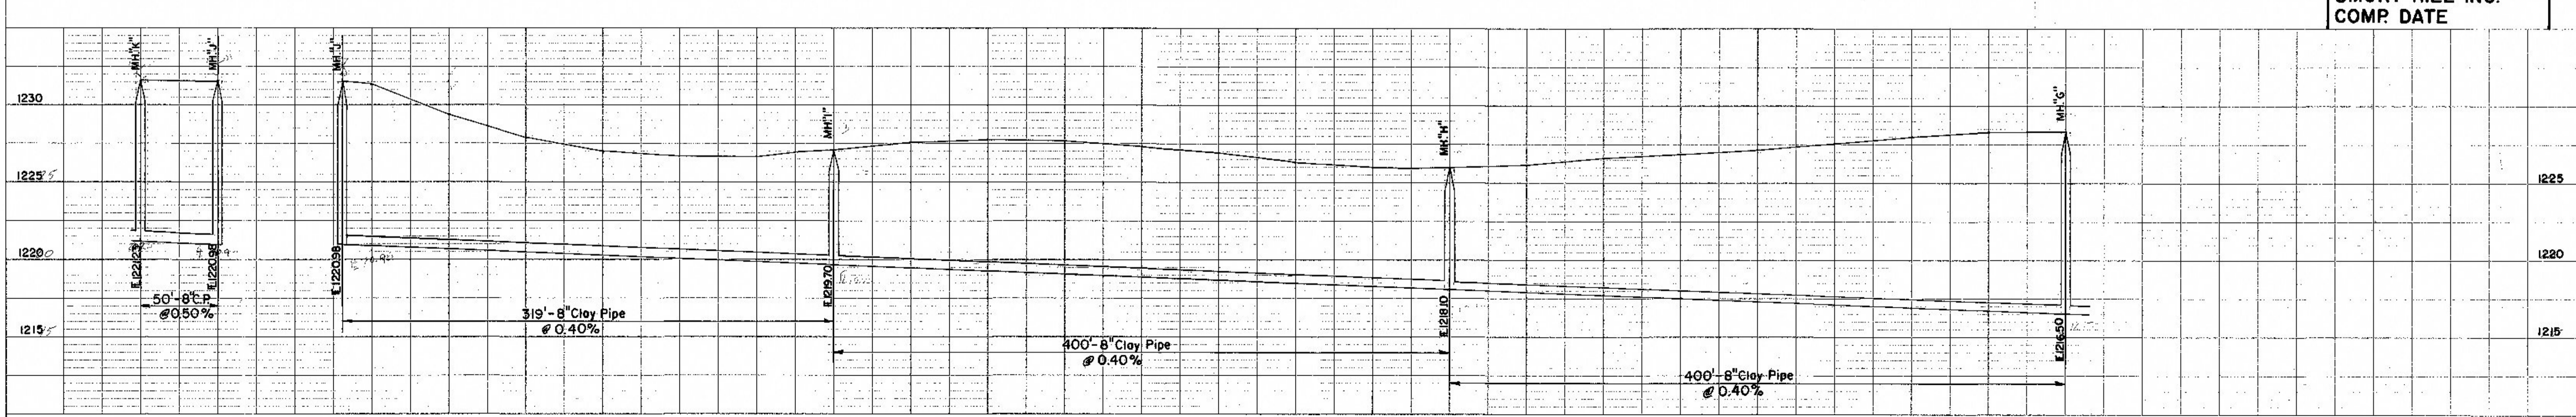
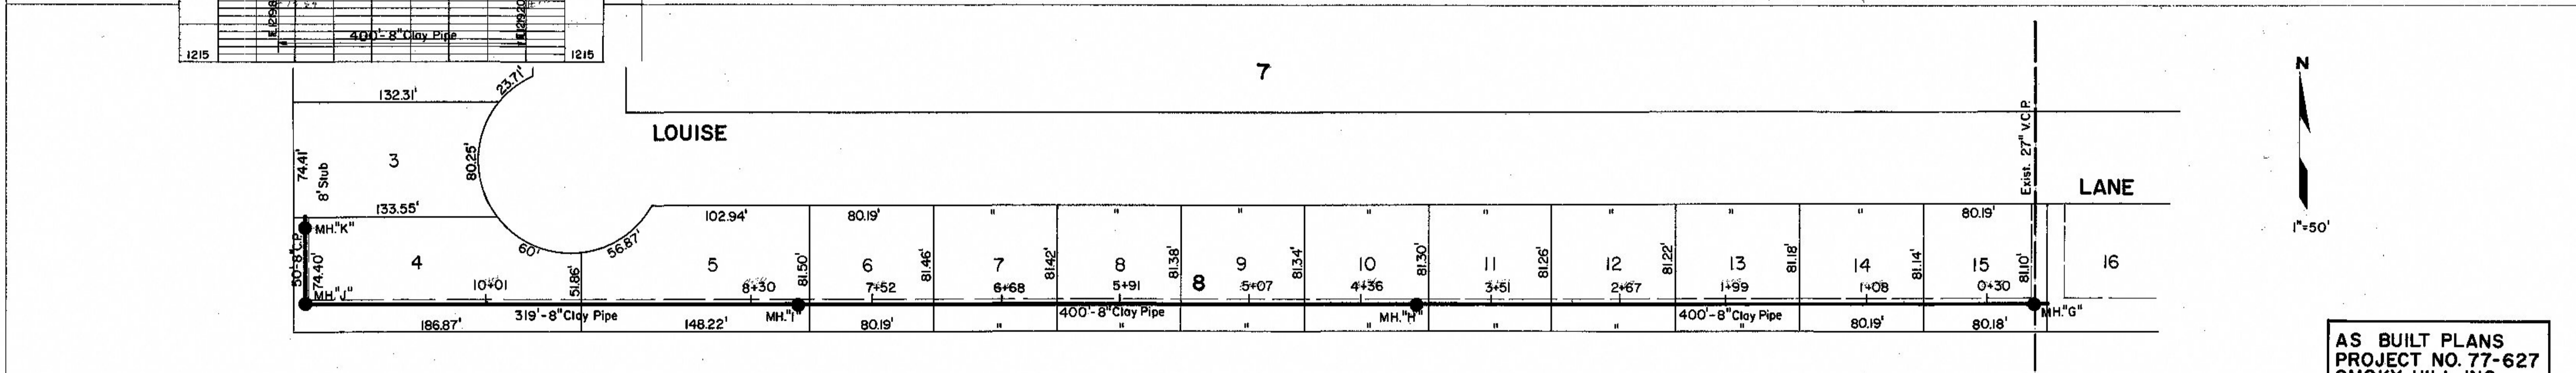
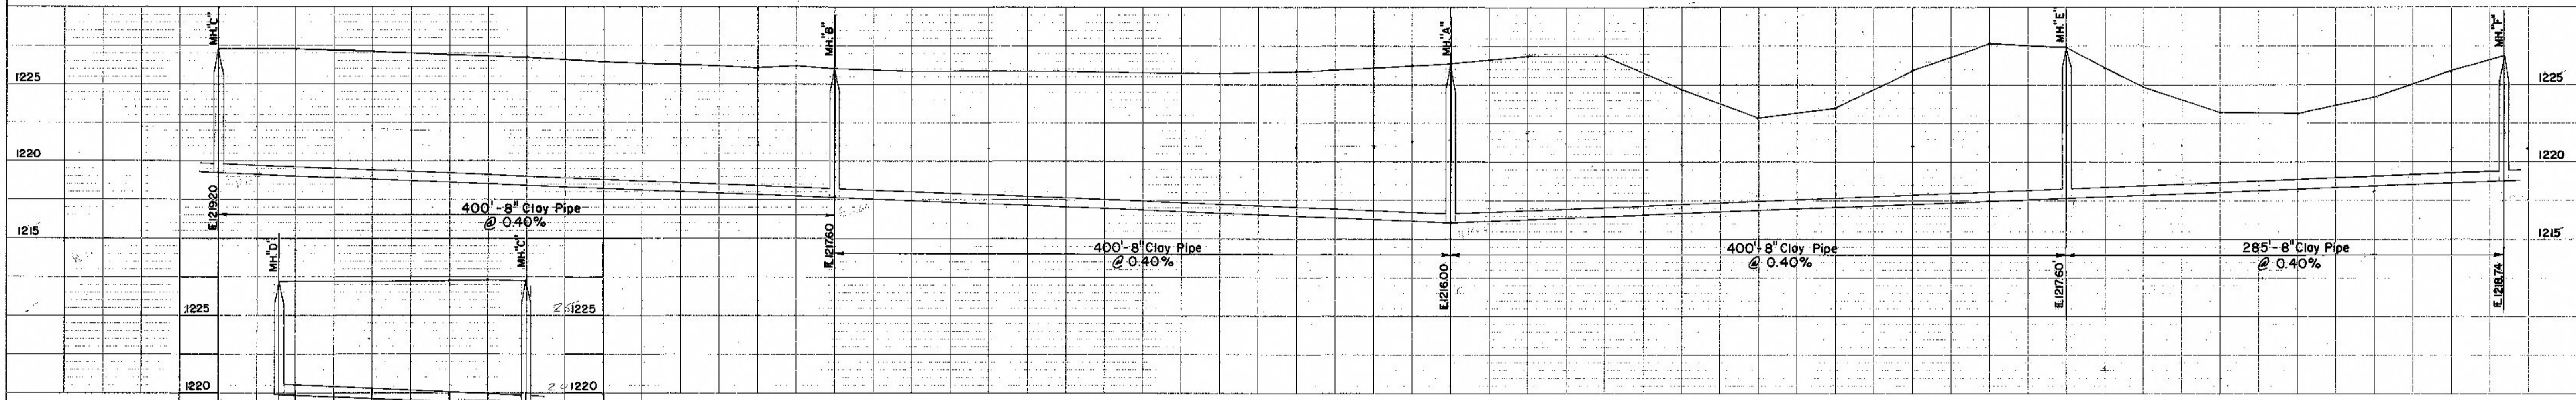


PLAN	DATE
BY	
REVISIONS	
1. DATE	
2. DATE	
PROFILE	DATE
BY	
REVISIONS	
1. DATE	
2. DATE	
3. DATE	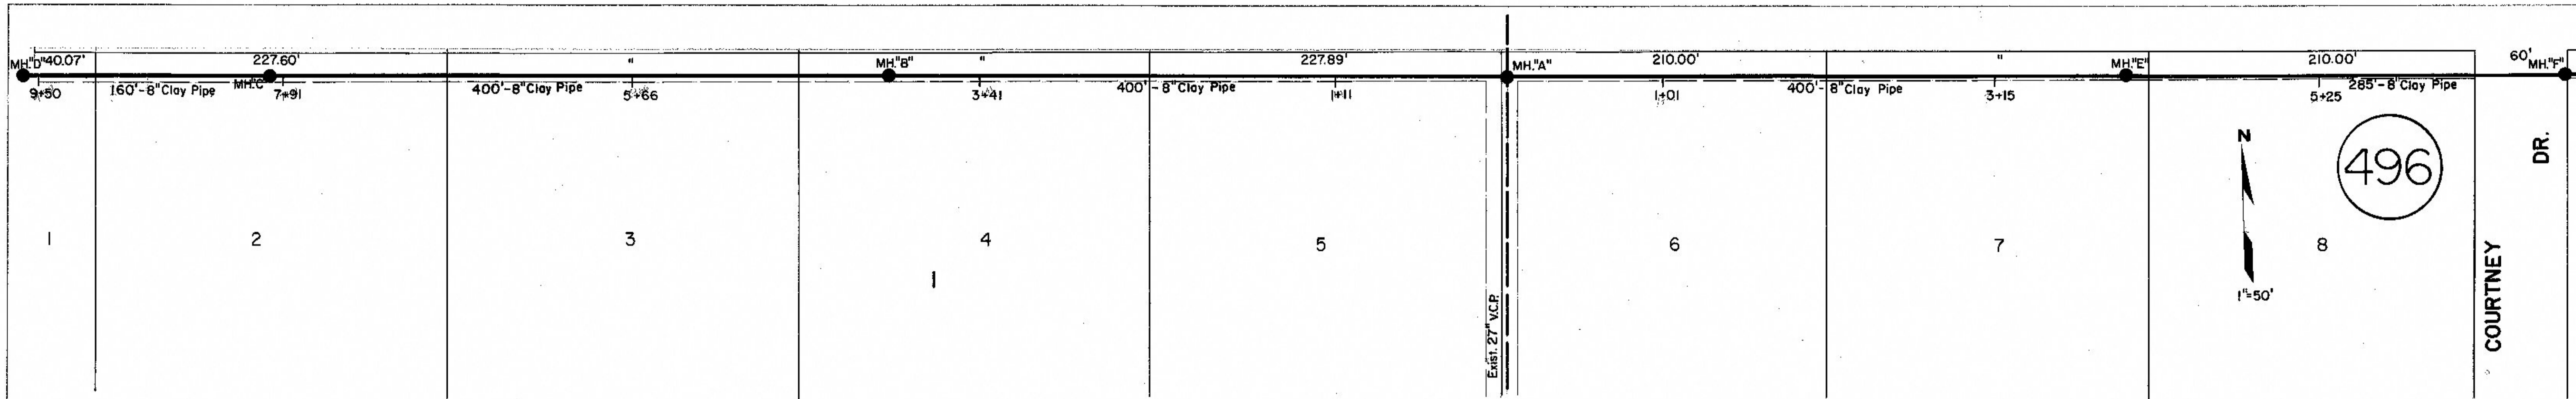
AS BUILT PLANS
PROJECT NO. 77-627
SMOKY HILL INC.
COMP. DATE