
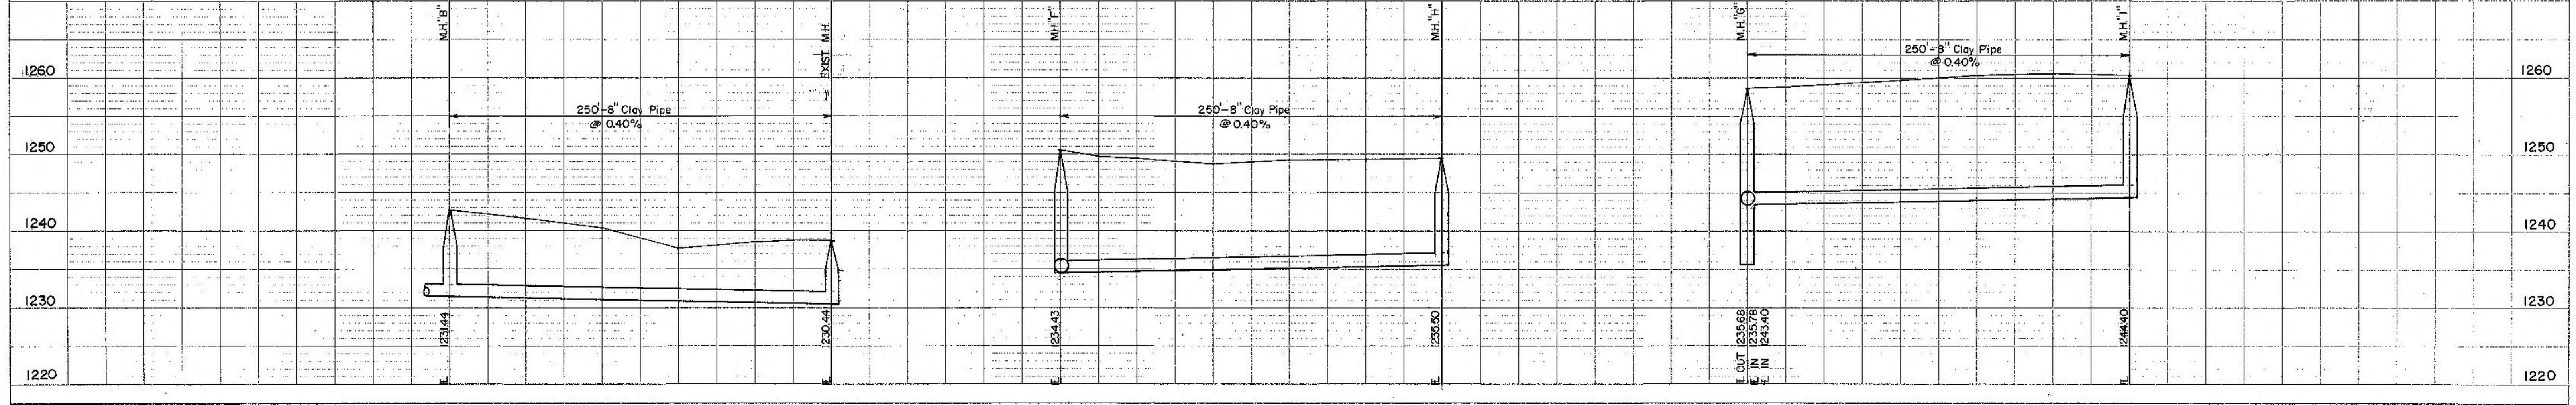
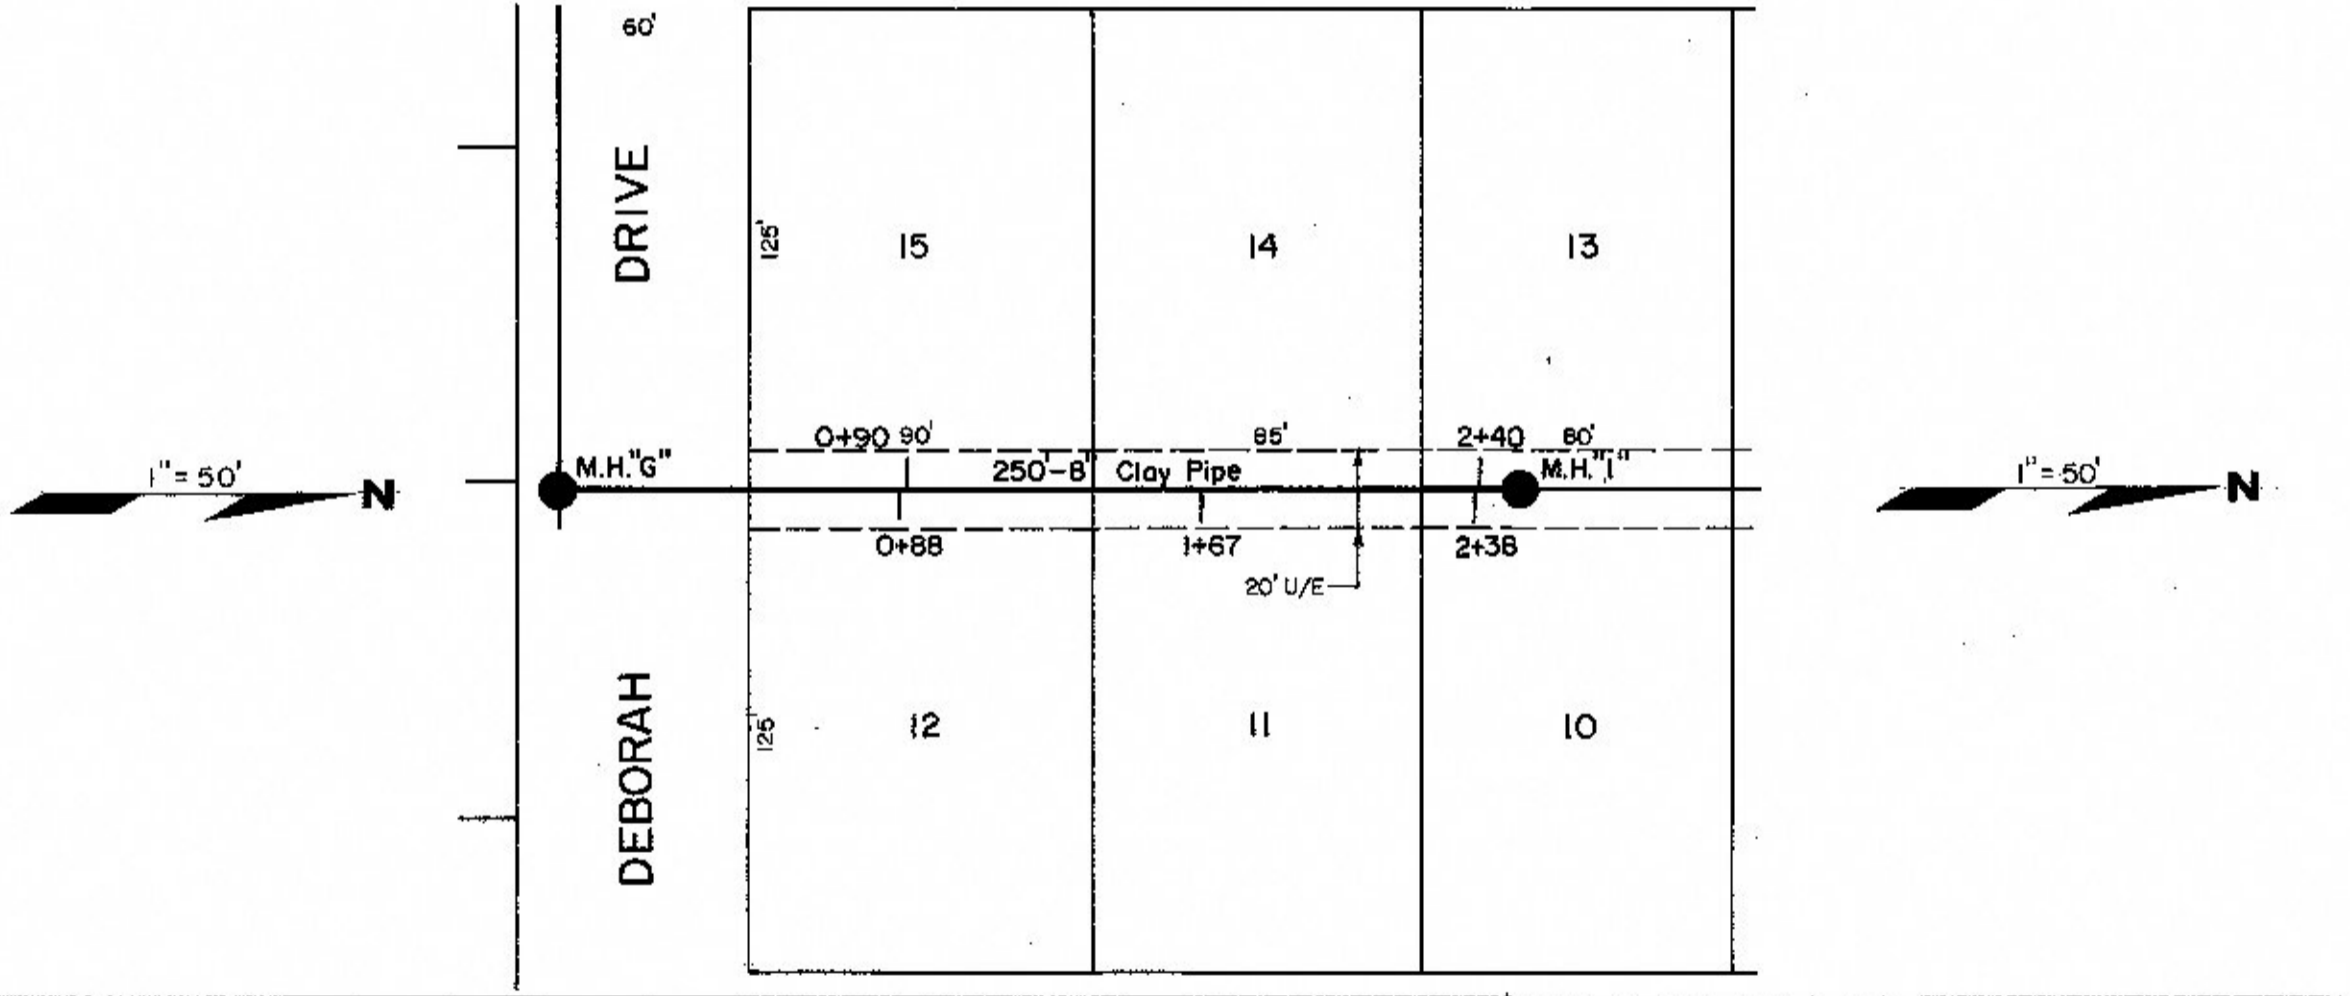
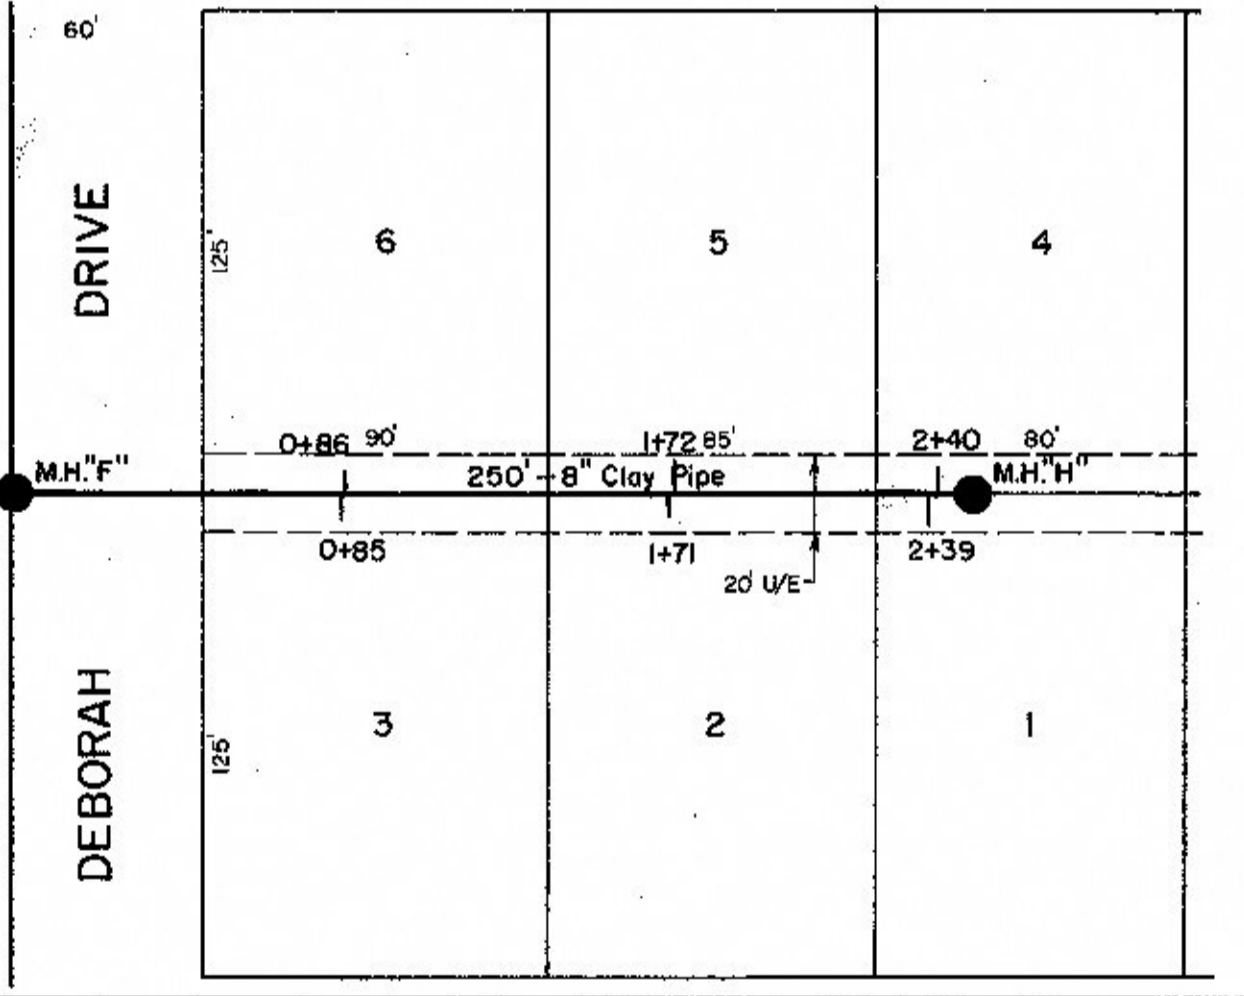
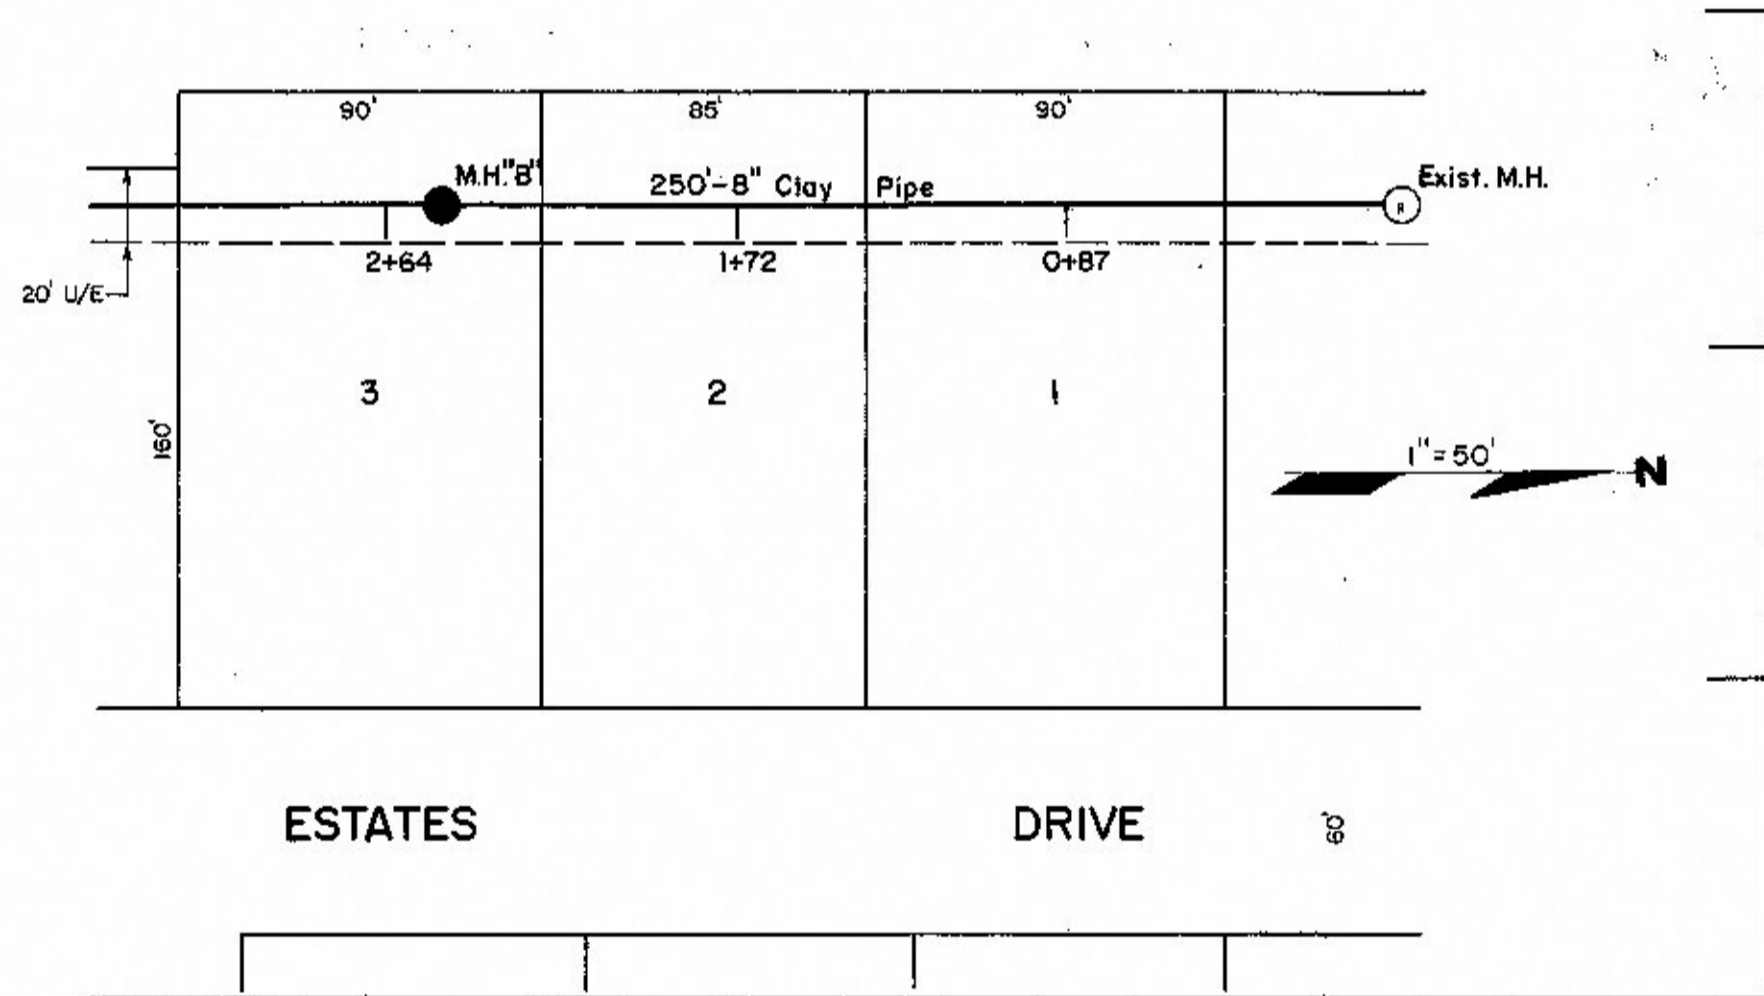
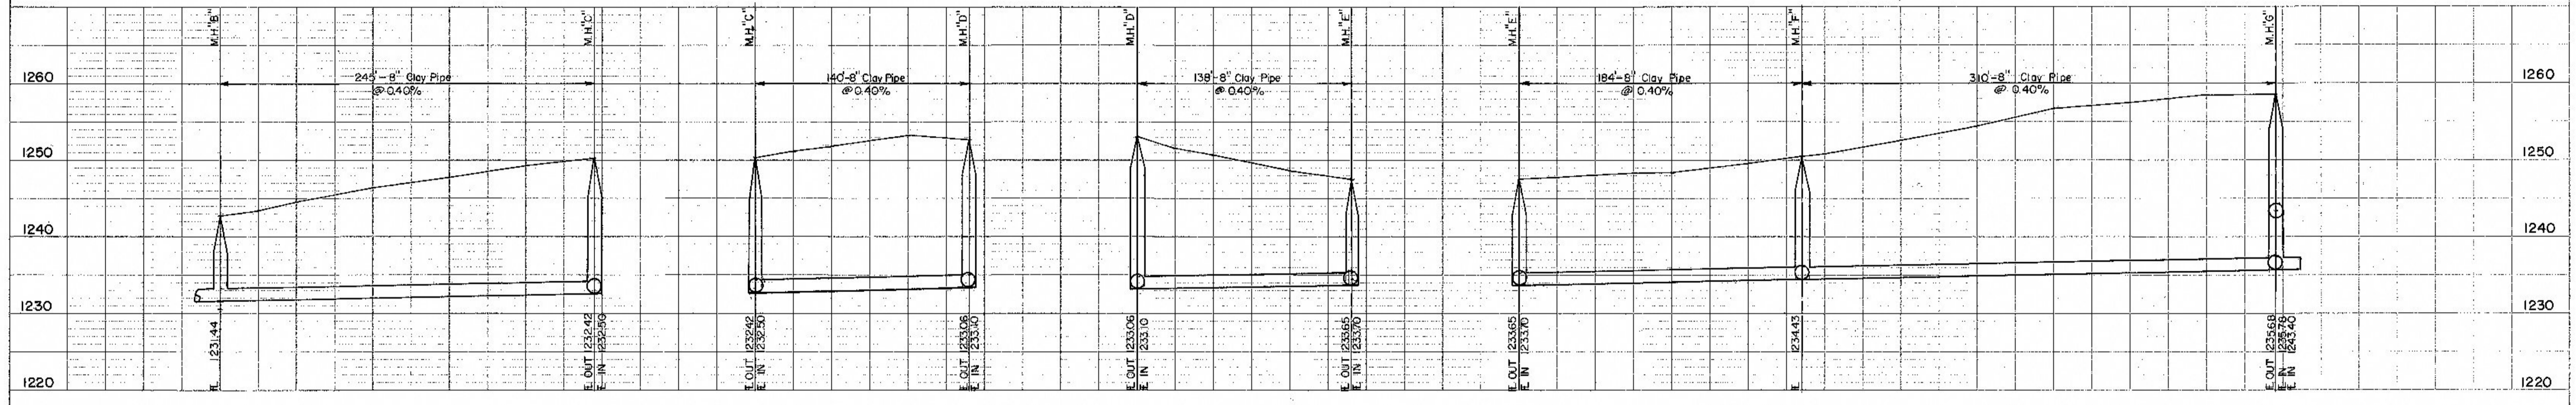


AS BUILT PLANS
PROJECT NO. 77-617
SMOKY HILL INC.
COMP. DATE JAN. 19, 1978

DATE	
BY	
REVISIONS	
NO.	
DESCRIPTION	

PLAN
SURVEYED
ALIGNED
CHECKED
NOTE BOOK
NO.

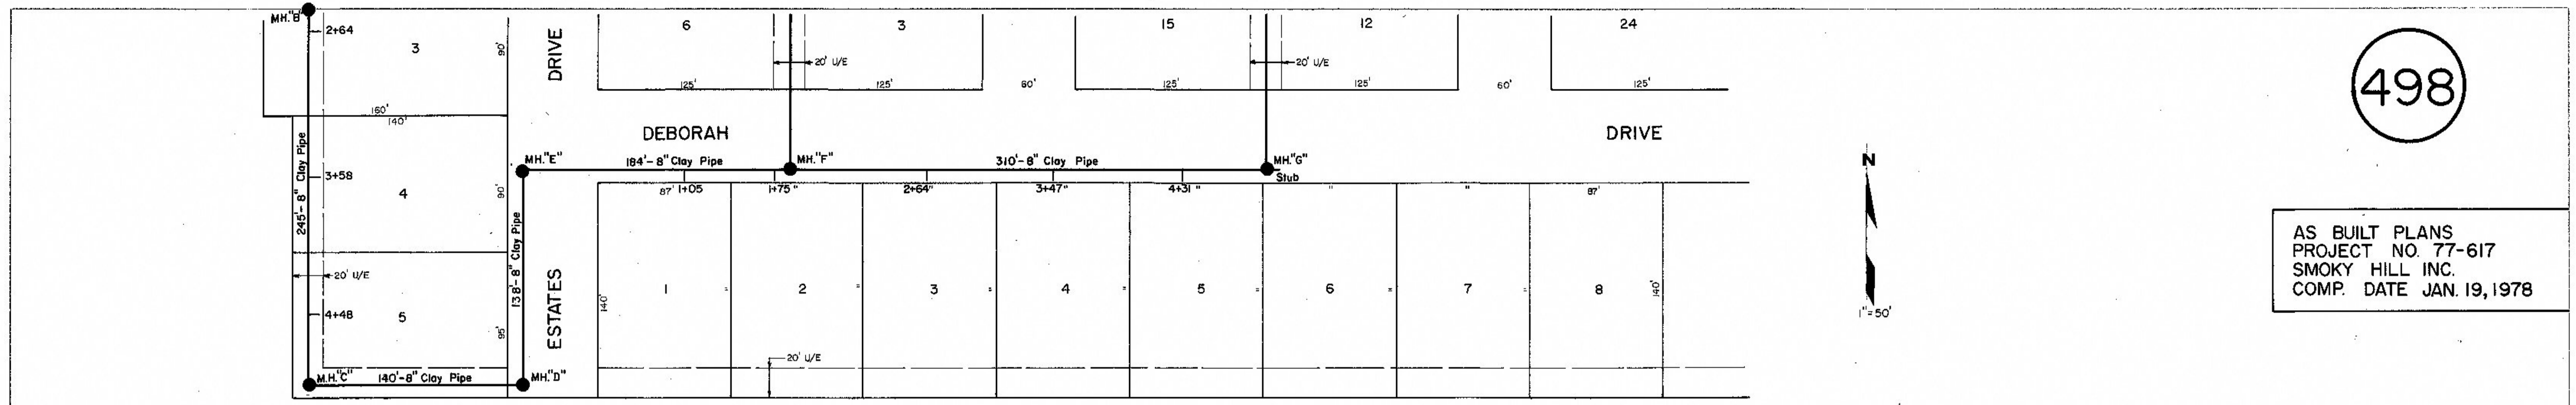

DATE	
BY	
REVISIONS	
NO.	
DESCRIPTION	

PLAN
SURVEYED
ALIGNED
CHECKED
NOTE BOOK
NO.