

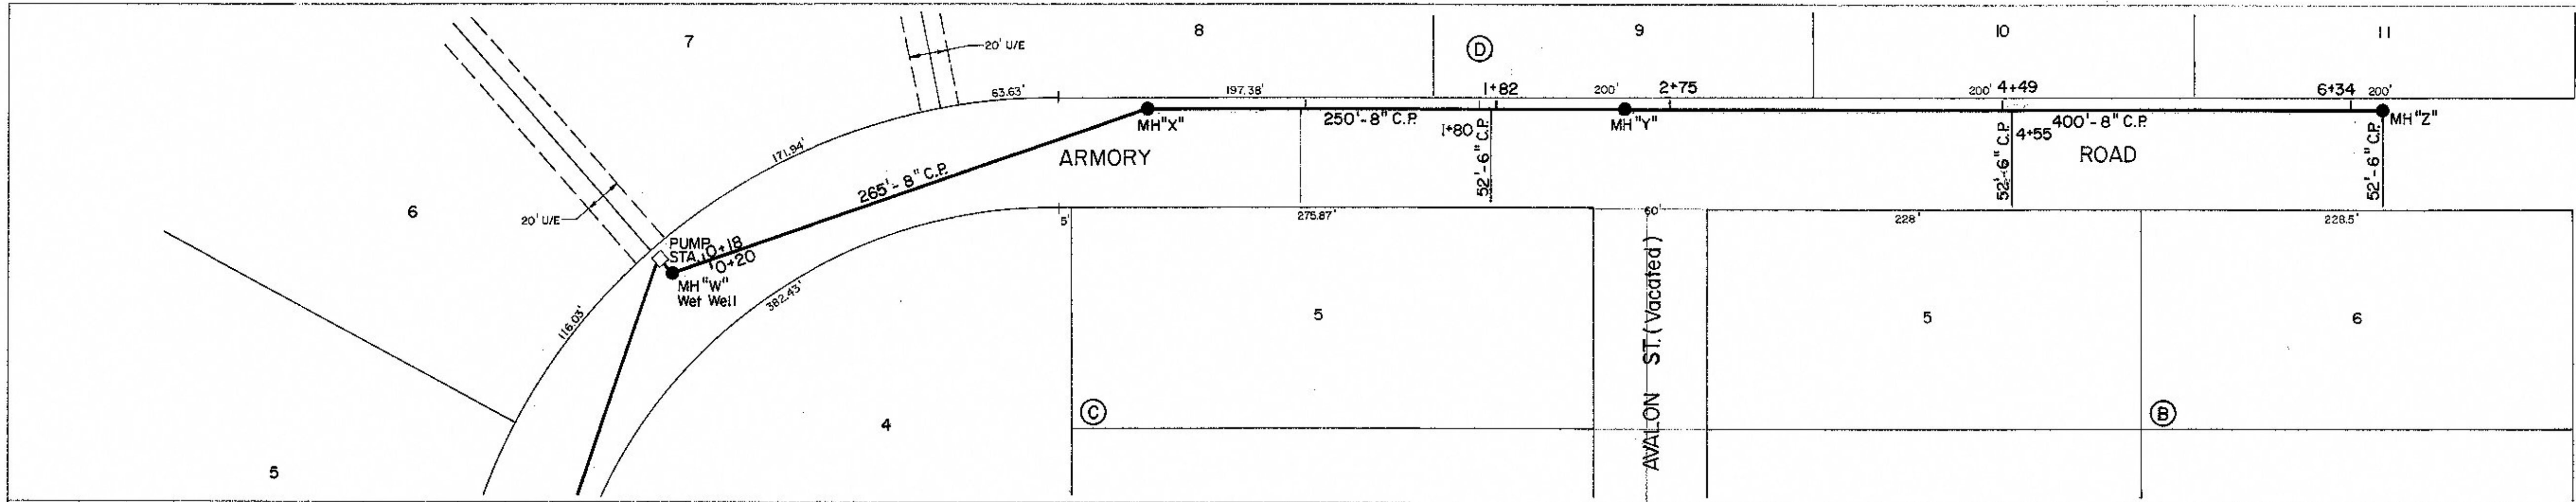


DATE	
BY	
REVISIONS	
NO.	
PLAN	
NO.	
NOTE BOOK	
ALIGNMENT CHECKED	
EST. OF WAY CHECKED	

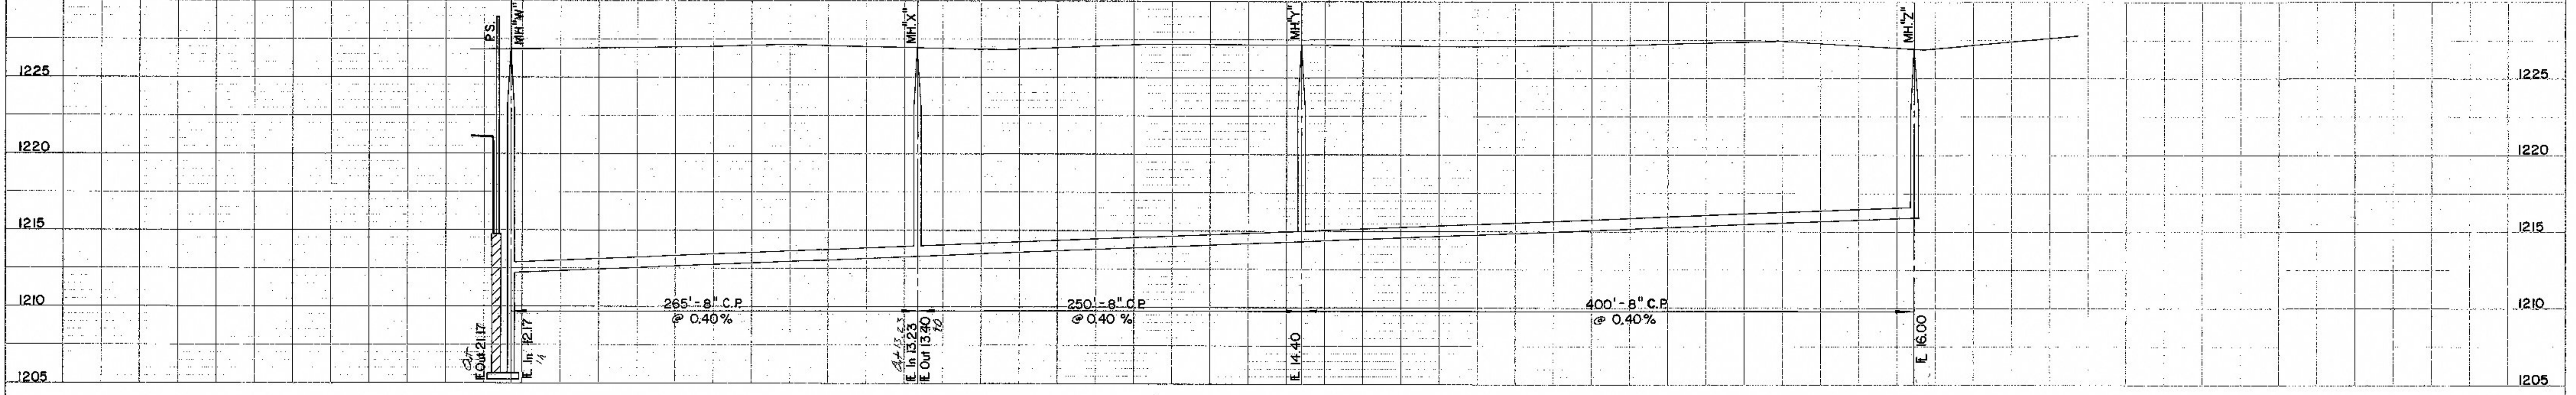


ST. SOUTH


499

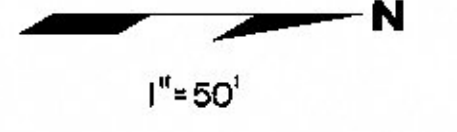

DATE	
BY	
REVISIONS	
NO.	
PROFILE	
NO.	
NOTE BOOK	
GRADES CHECKED	
EST. OF WAY CHECKED	

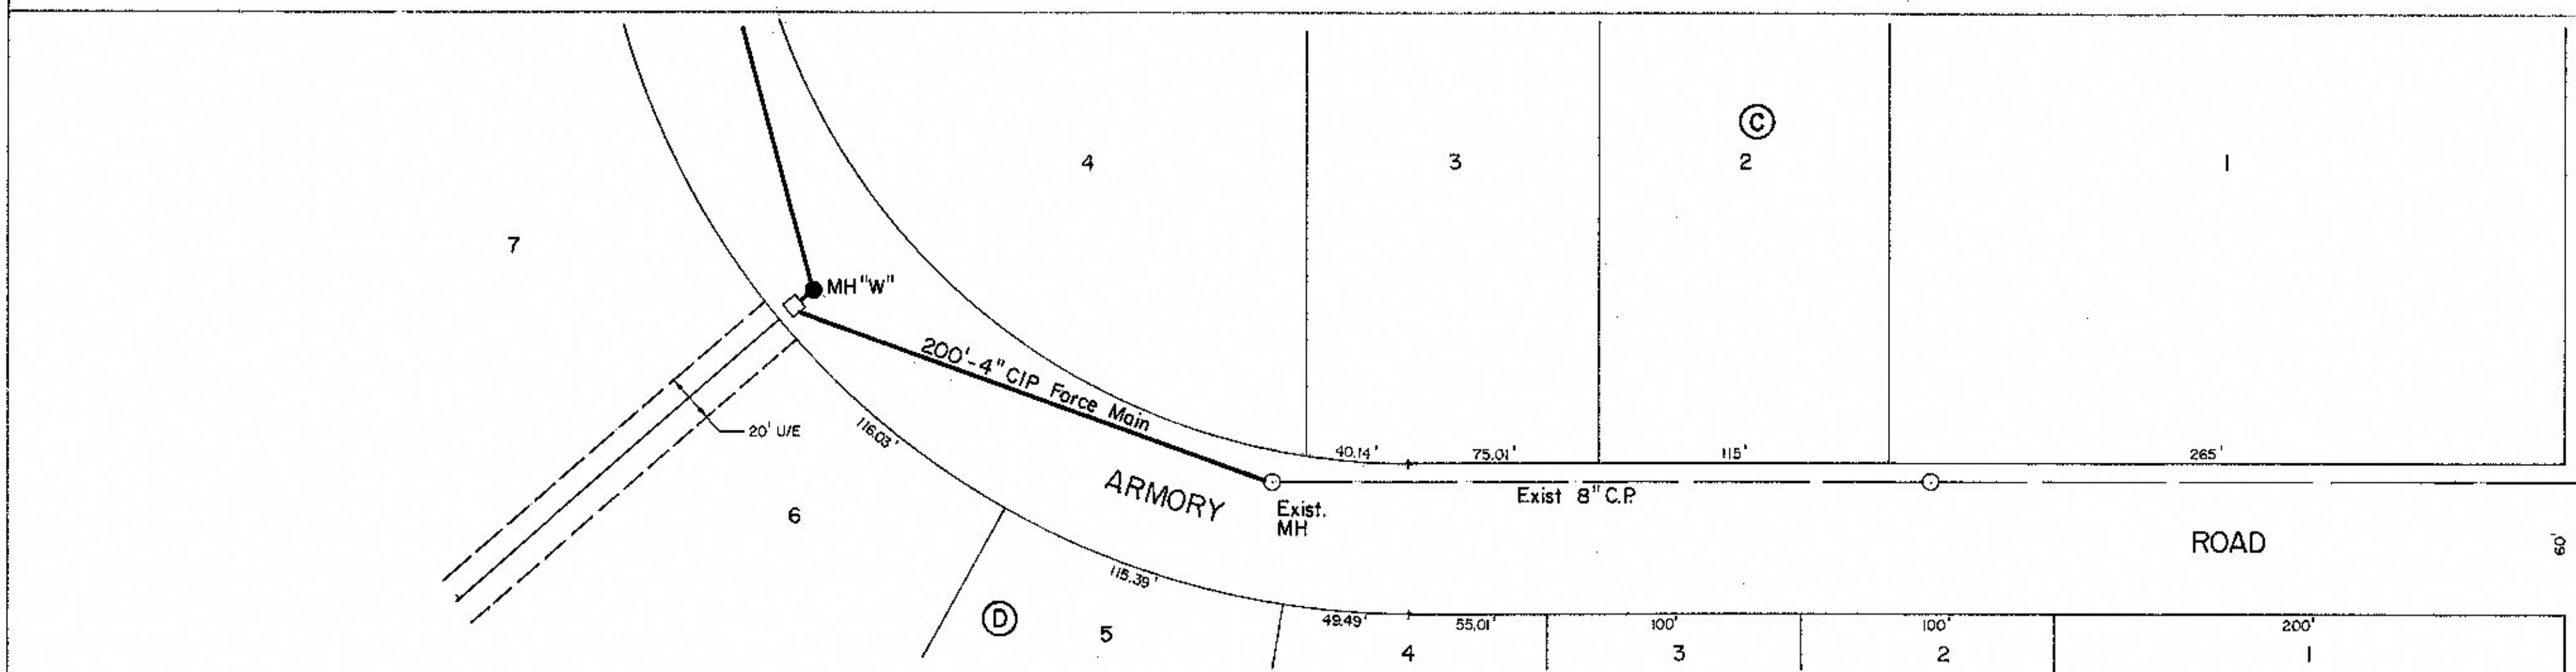

BROADWAY AVE.

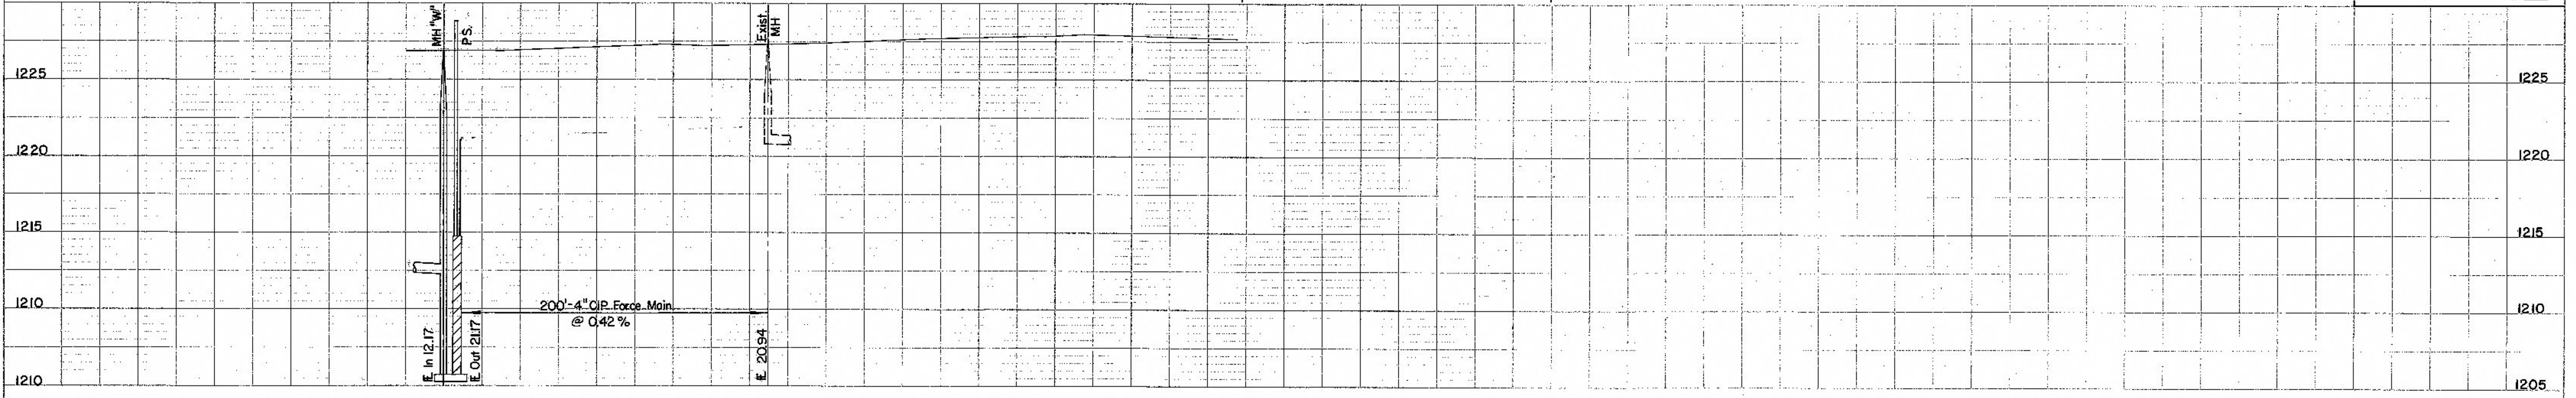

AS-BUILT PLANS  
PROJECT NO. 78-635  
SMOKY HILL INC.  
COMP. DATE 10-78