
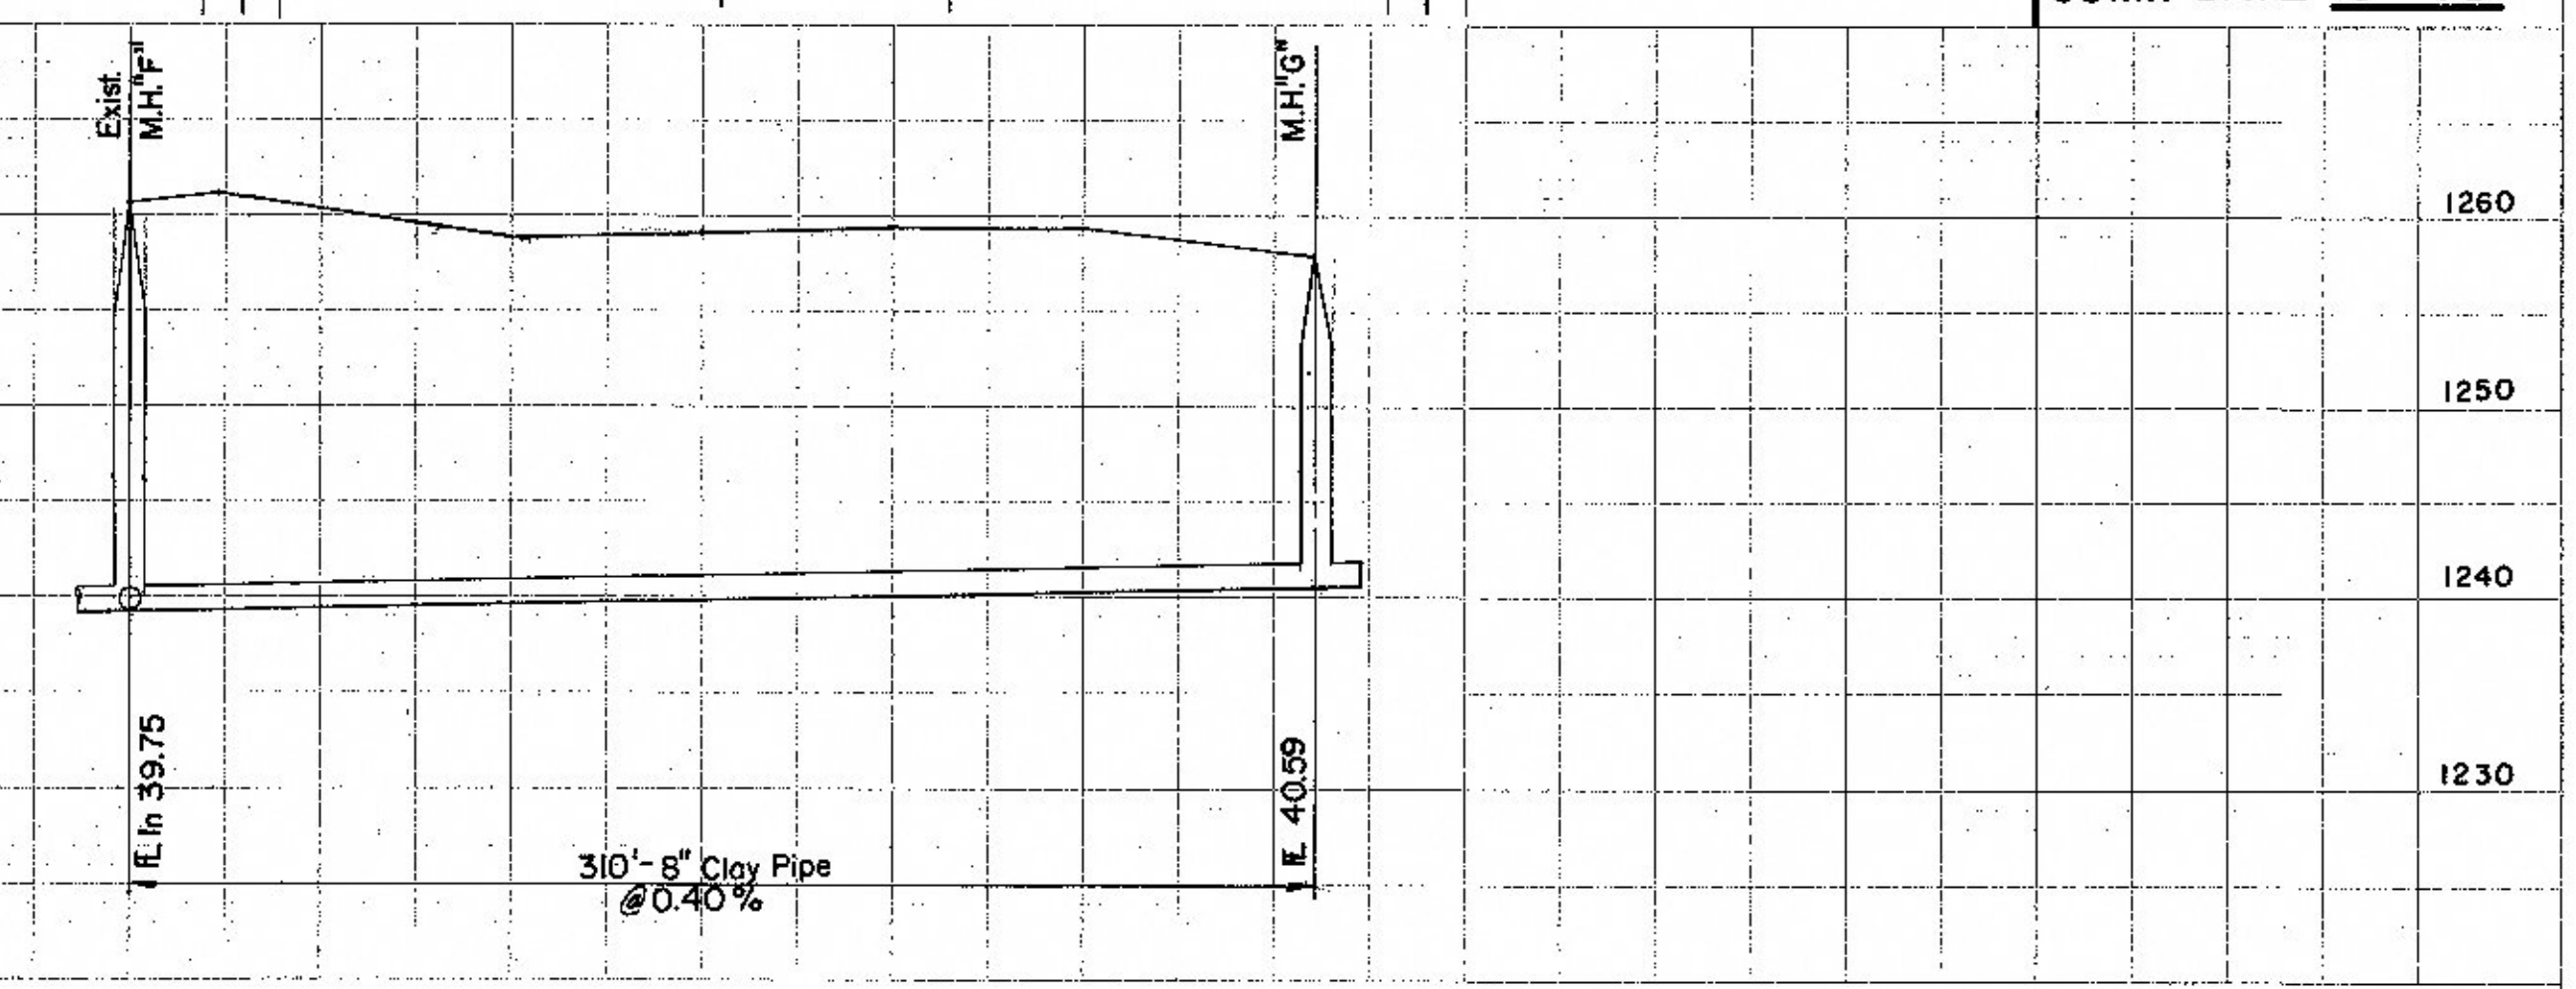
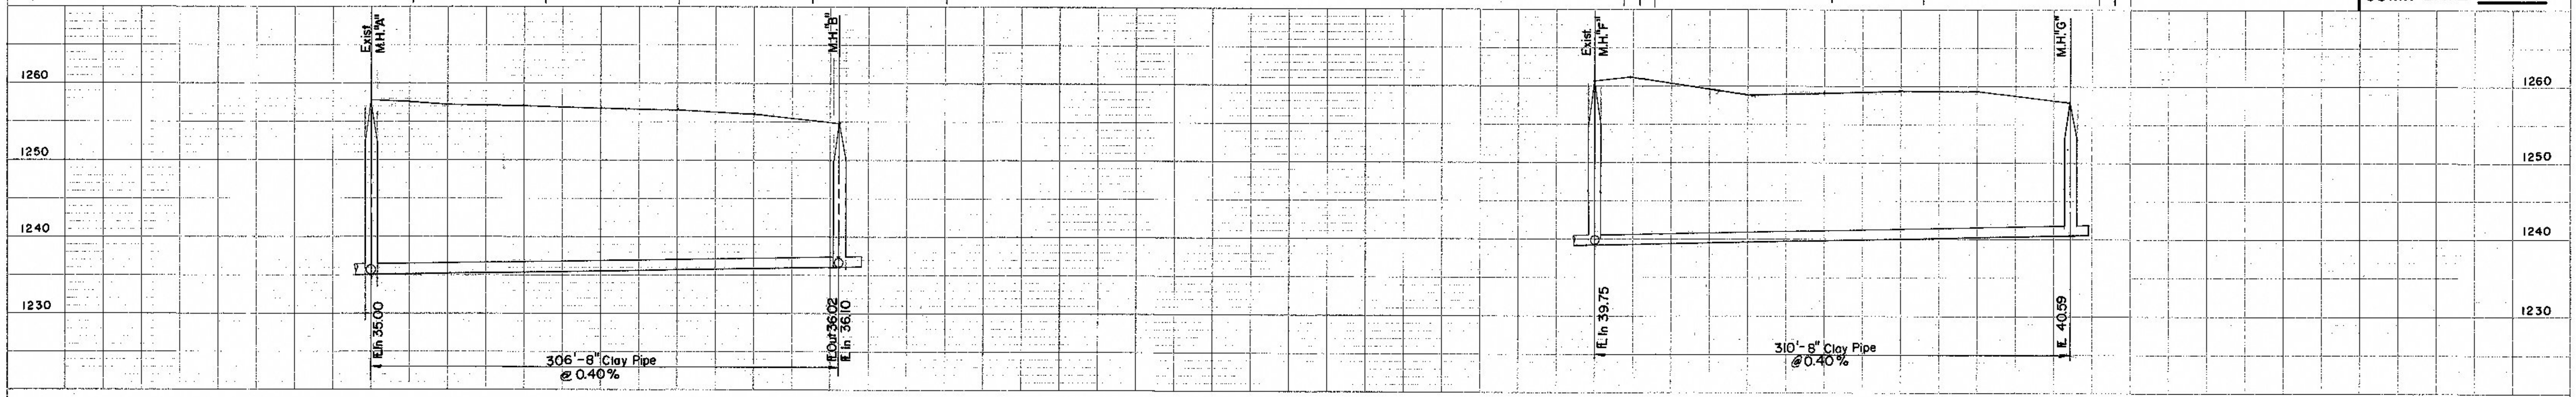
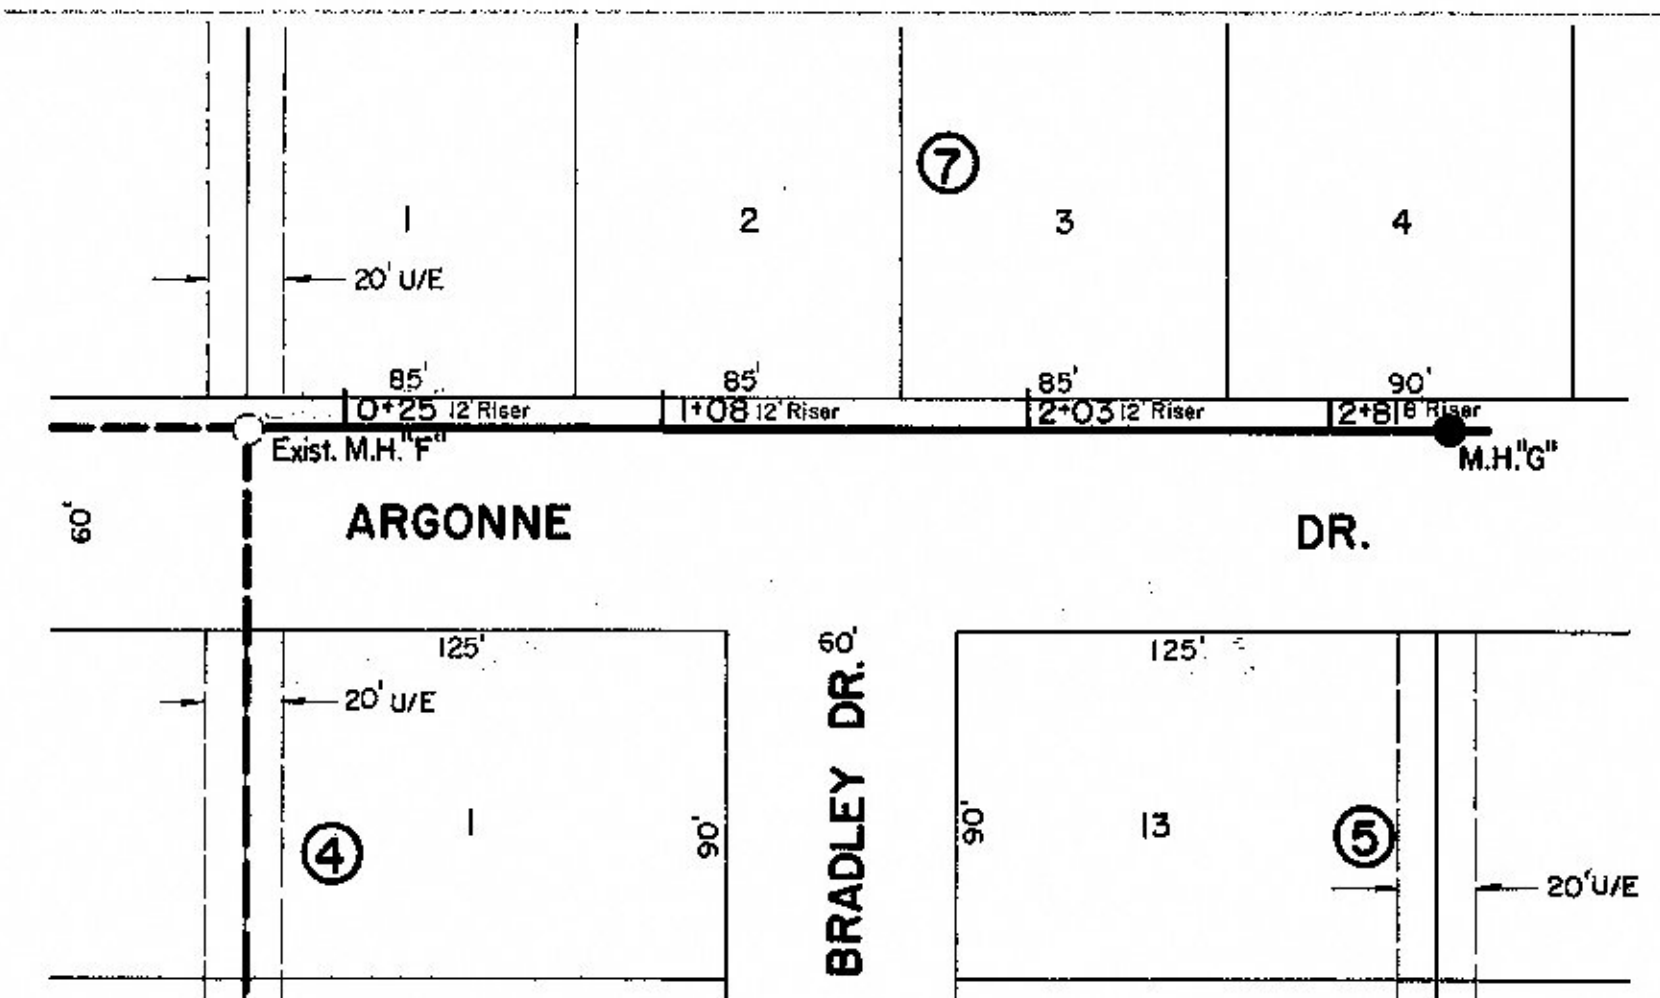
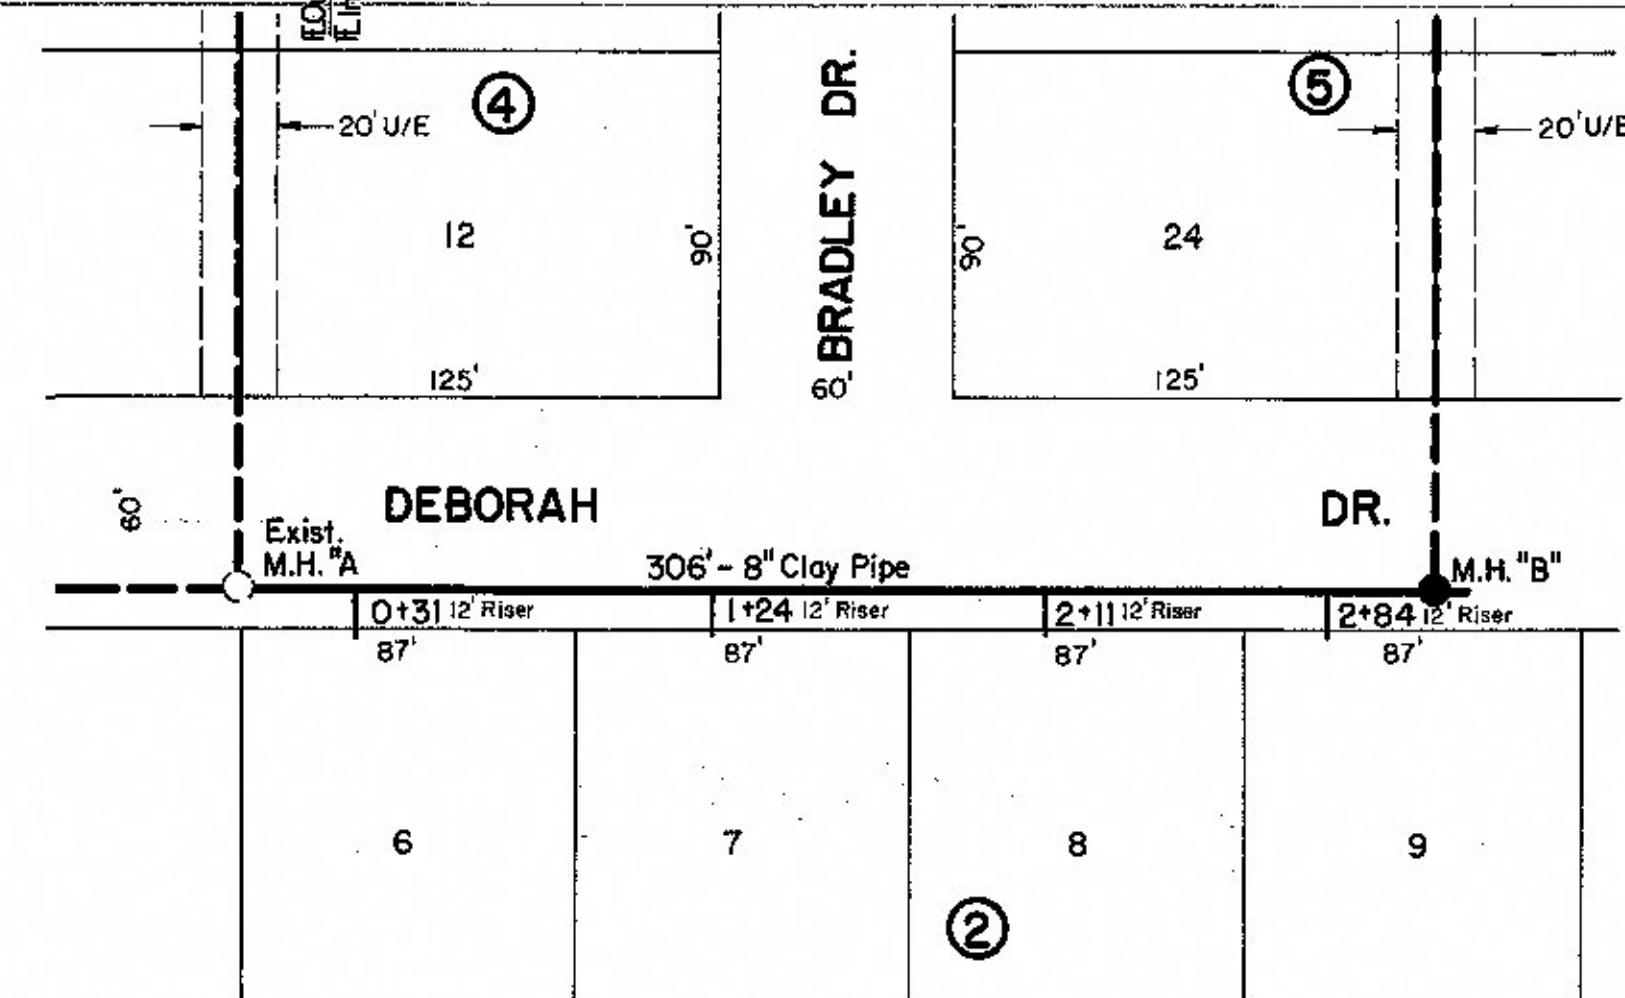
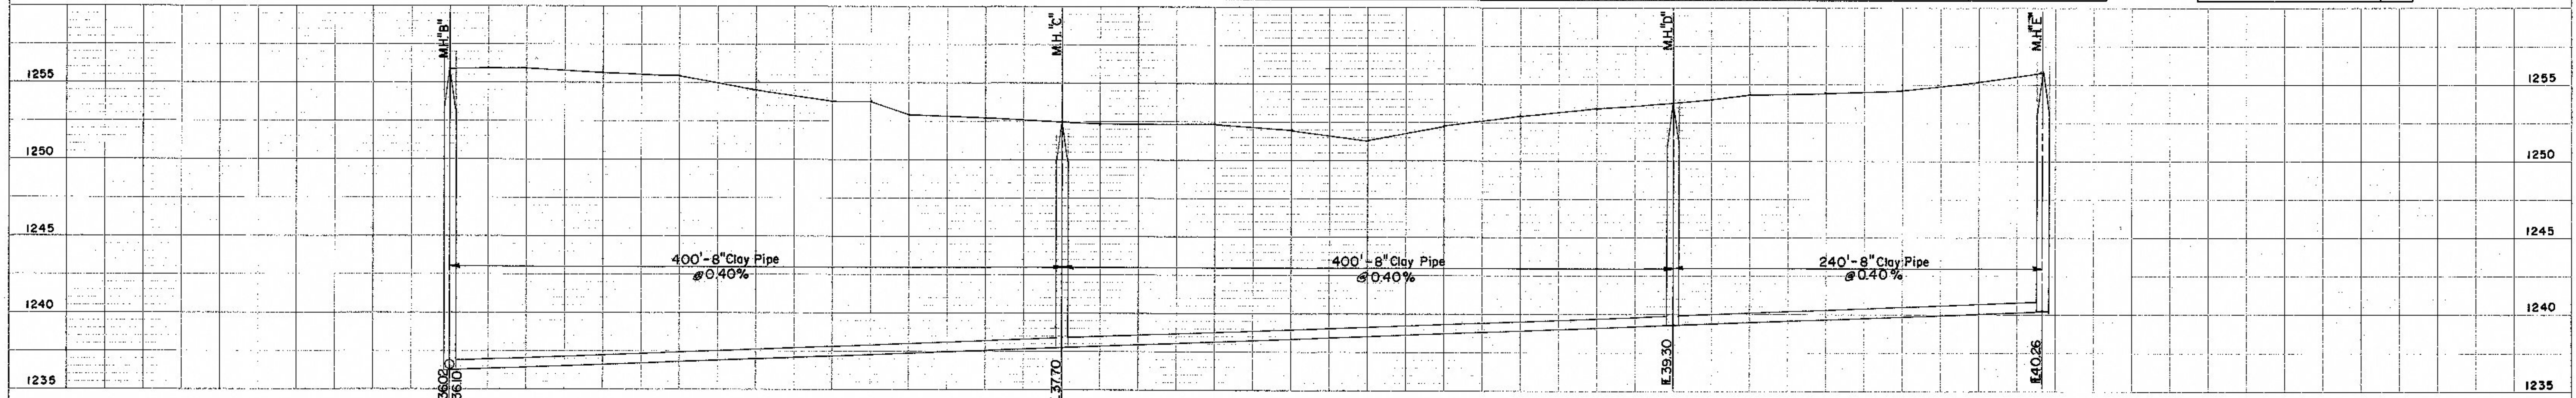


PLAN
 SURVEYED
 PLOTTED
 NOTE BOOK
 ALIGNMENT CHECKED
 BY: []
 DATE: []

PROFILE
 SURVEYED
 PLOTTED
 NOTE BOOK
 GRADES CHECKED
 STRUCTURE POINTS CHG 10
 BY: []
 DATE: []

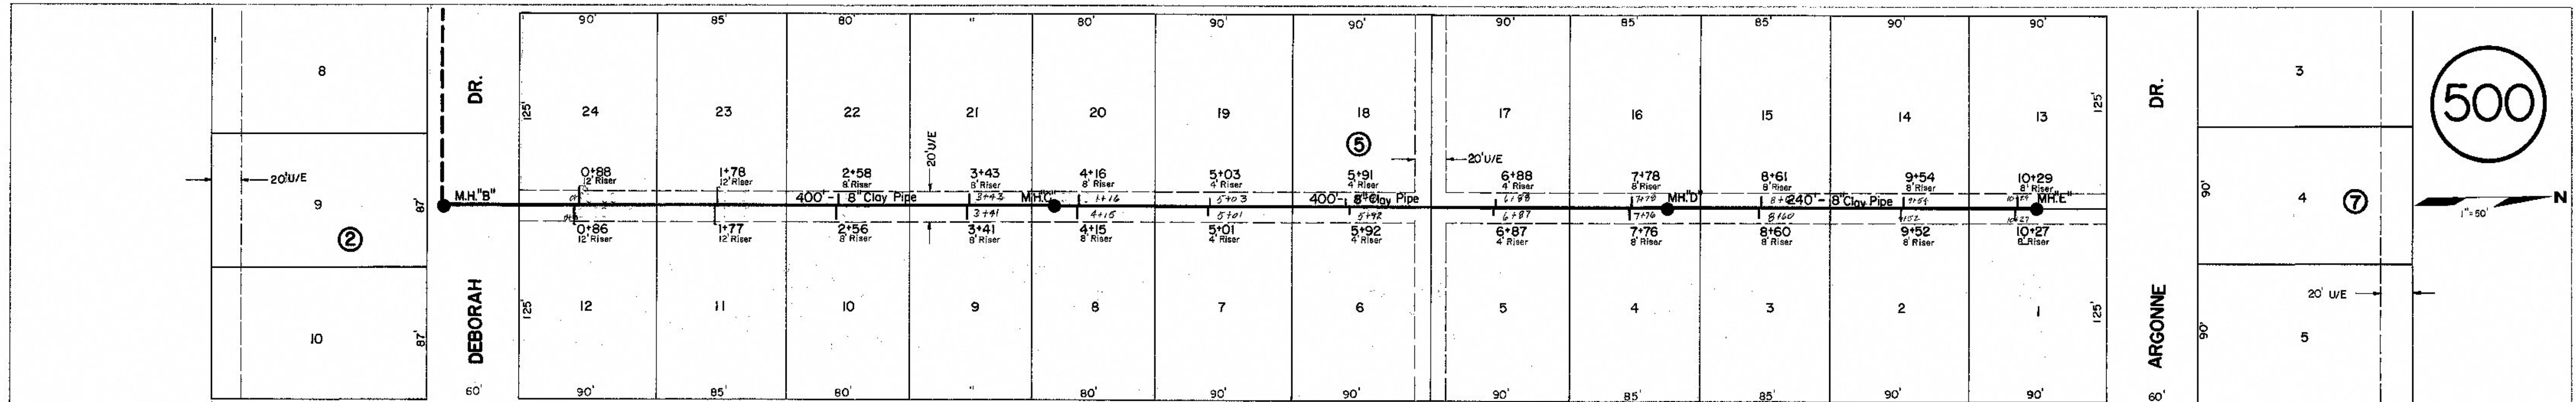

AS-BUILT PLANS
 PROJECT NO. 78-634
 J.S. FRANK CONST. CO.
 COMP. DATE 9-78