


579

CORONADO COMMONS ADDITION 1996

THIS MAIN HAS BEEN DESIGNATED "PRIVATE"
Don Hoff, Dir. City of Salina Utilities
July 18, 2003

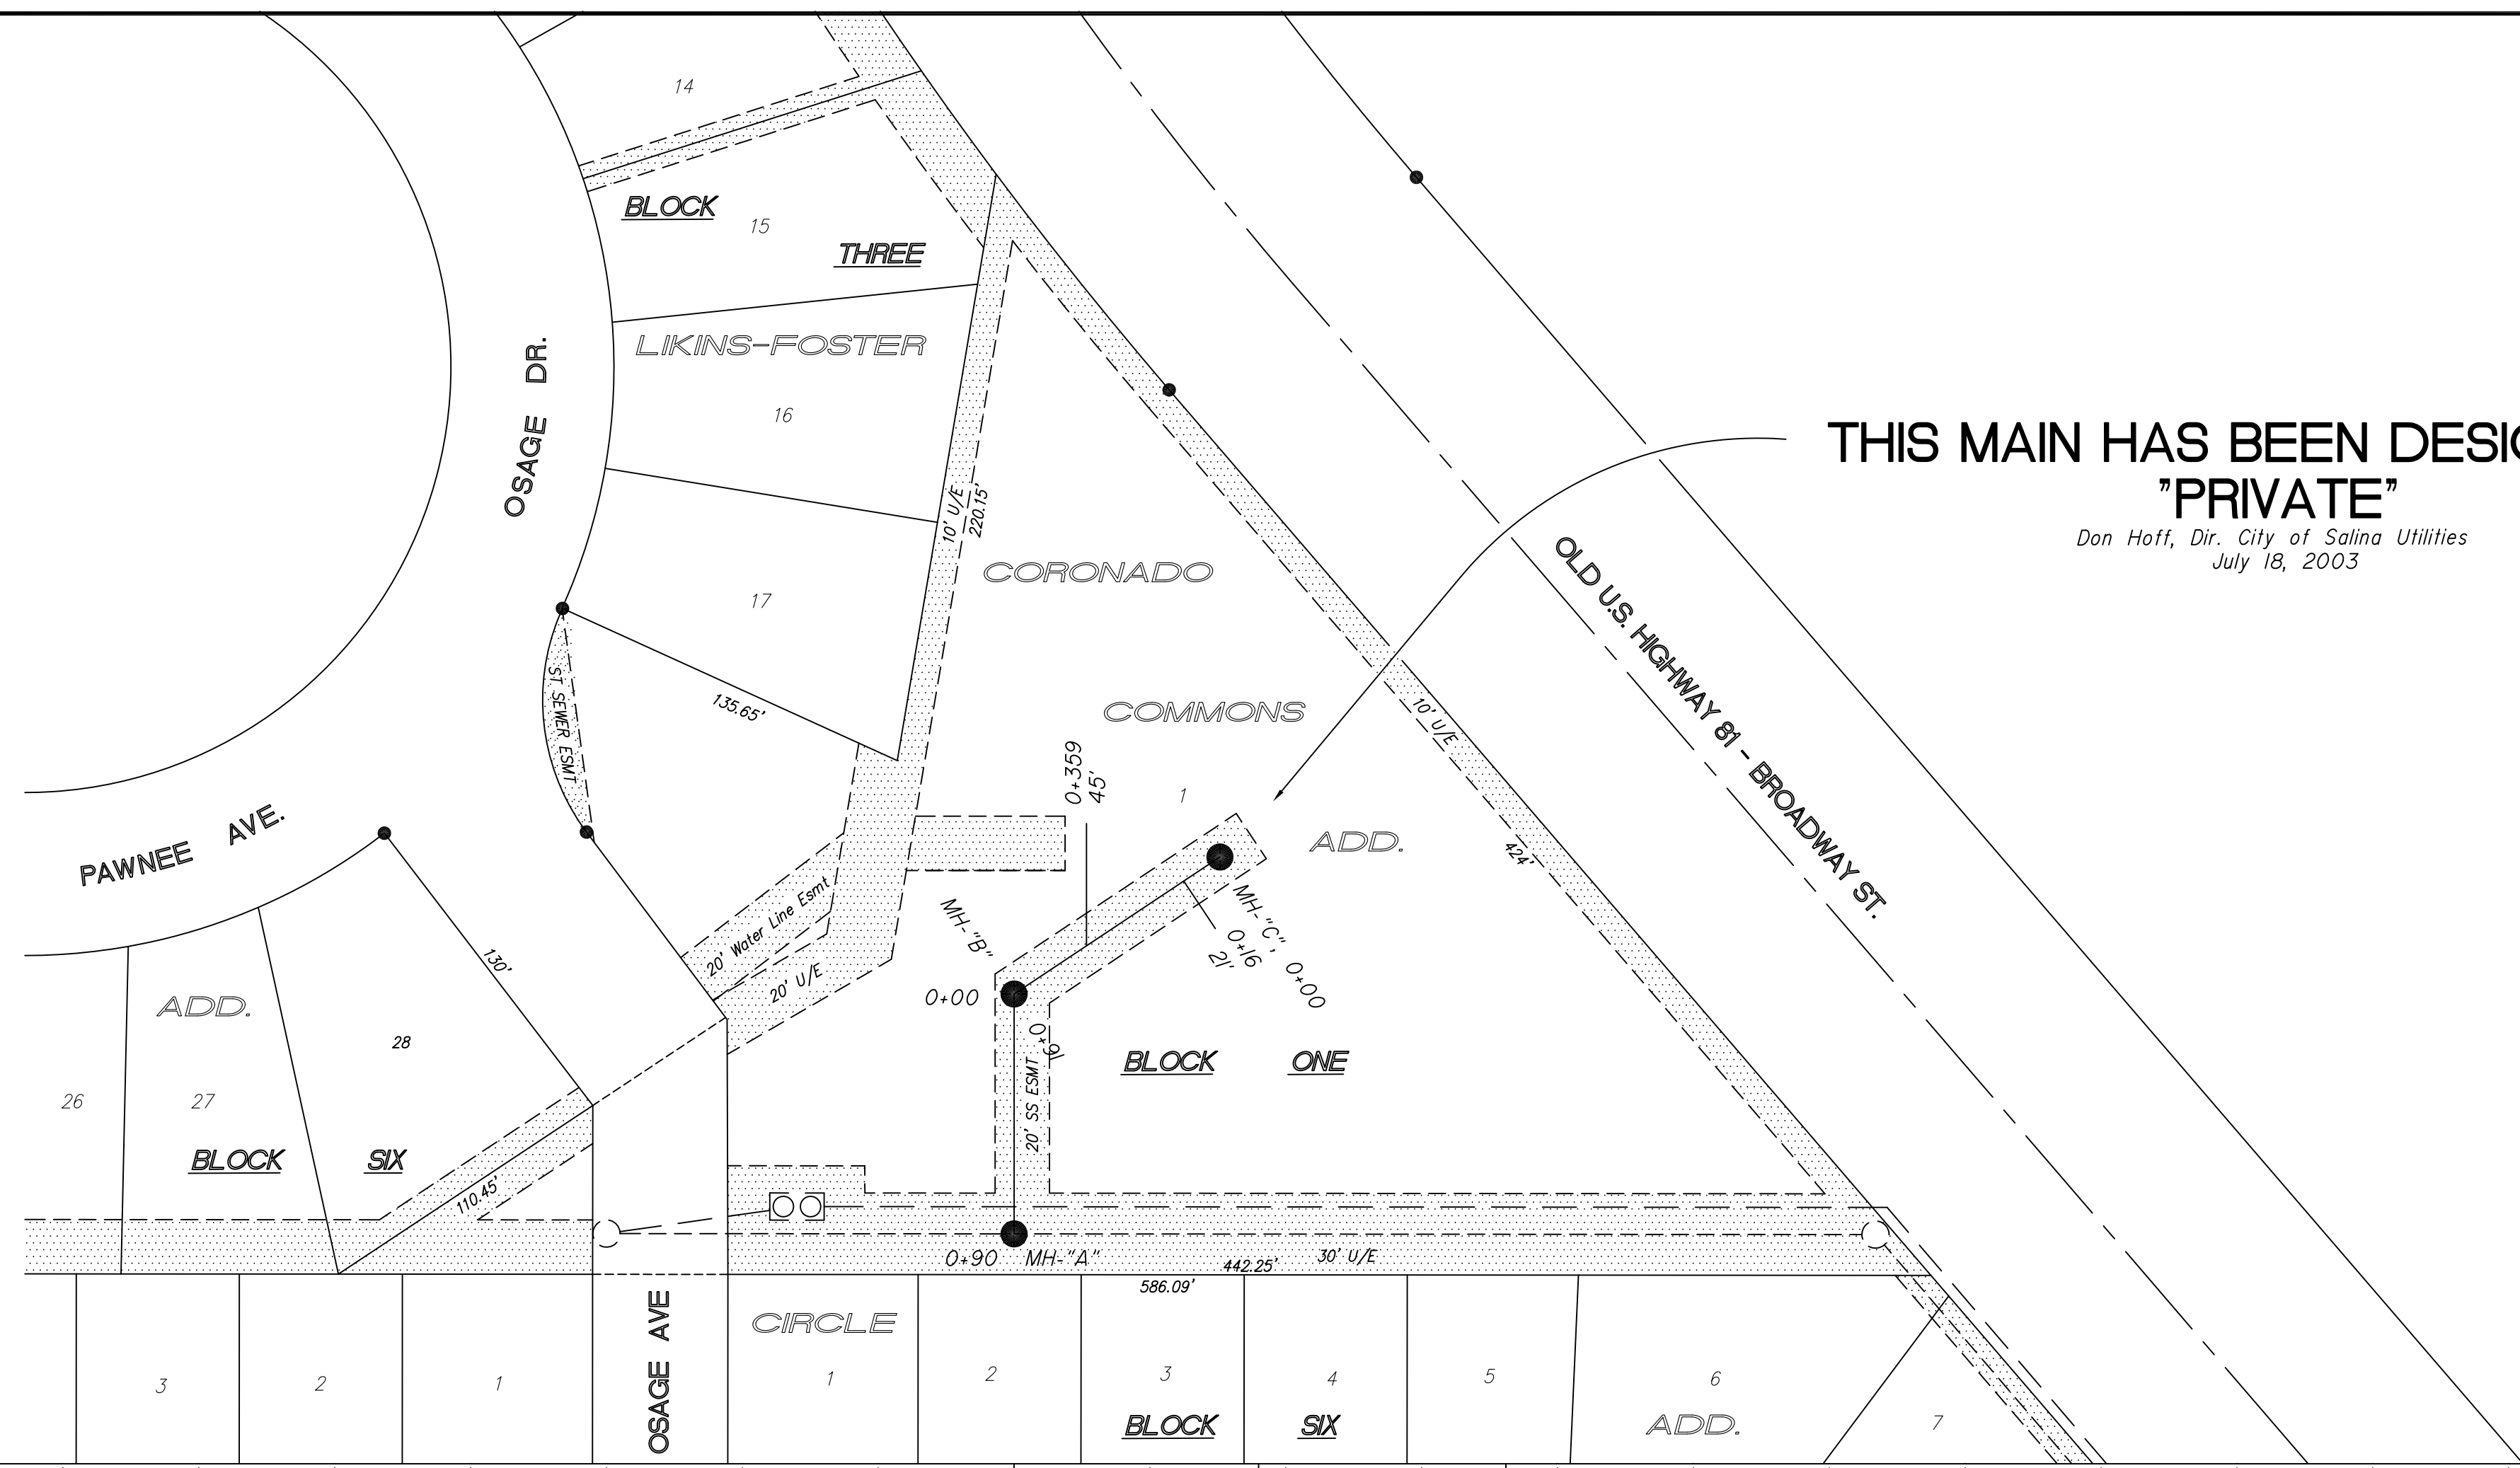


SCALE
PLAN: 1" = 50'
Horiz & Vert
PROFILE: Horiz 1" = 50'
Vert 1" = 5'

NOTE: All Sanitary Sewer mains are 8" unless noted otherwise.

NOTE: Distance from back of curb to property line is based on the street being built in the center of the right-of-way.

NOTE: All Streets are 33' back to back of curb. Right-of-Ways are 60' unless noted otherwise.

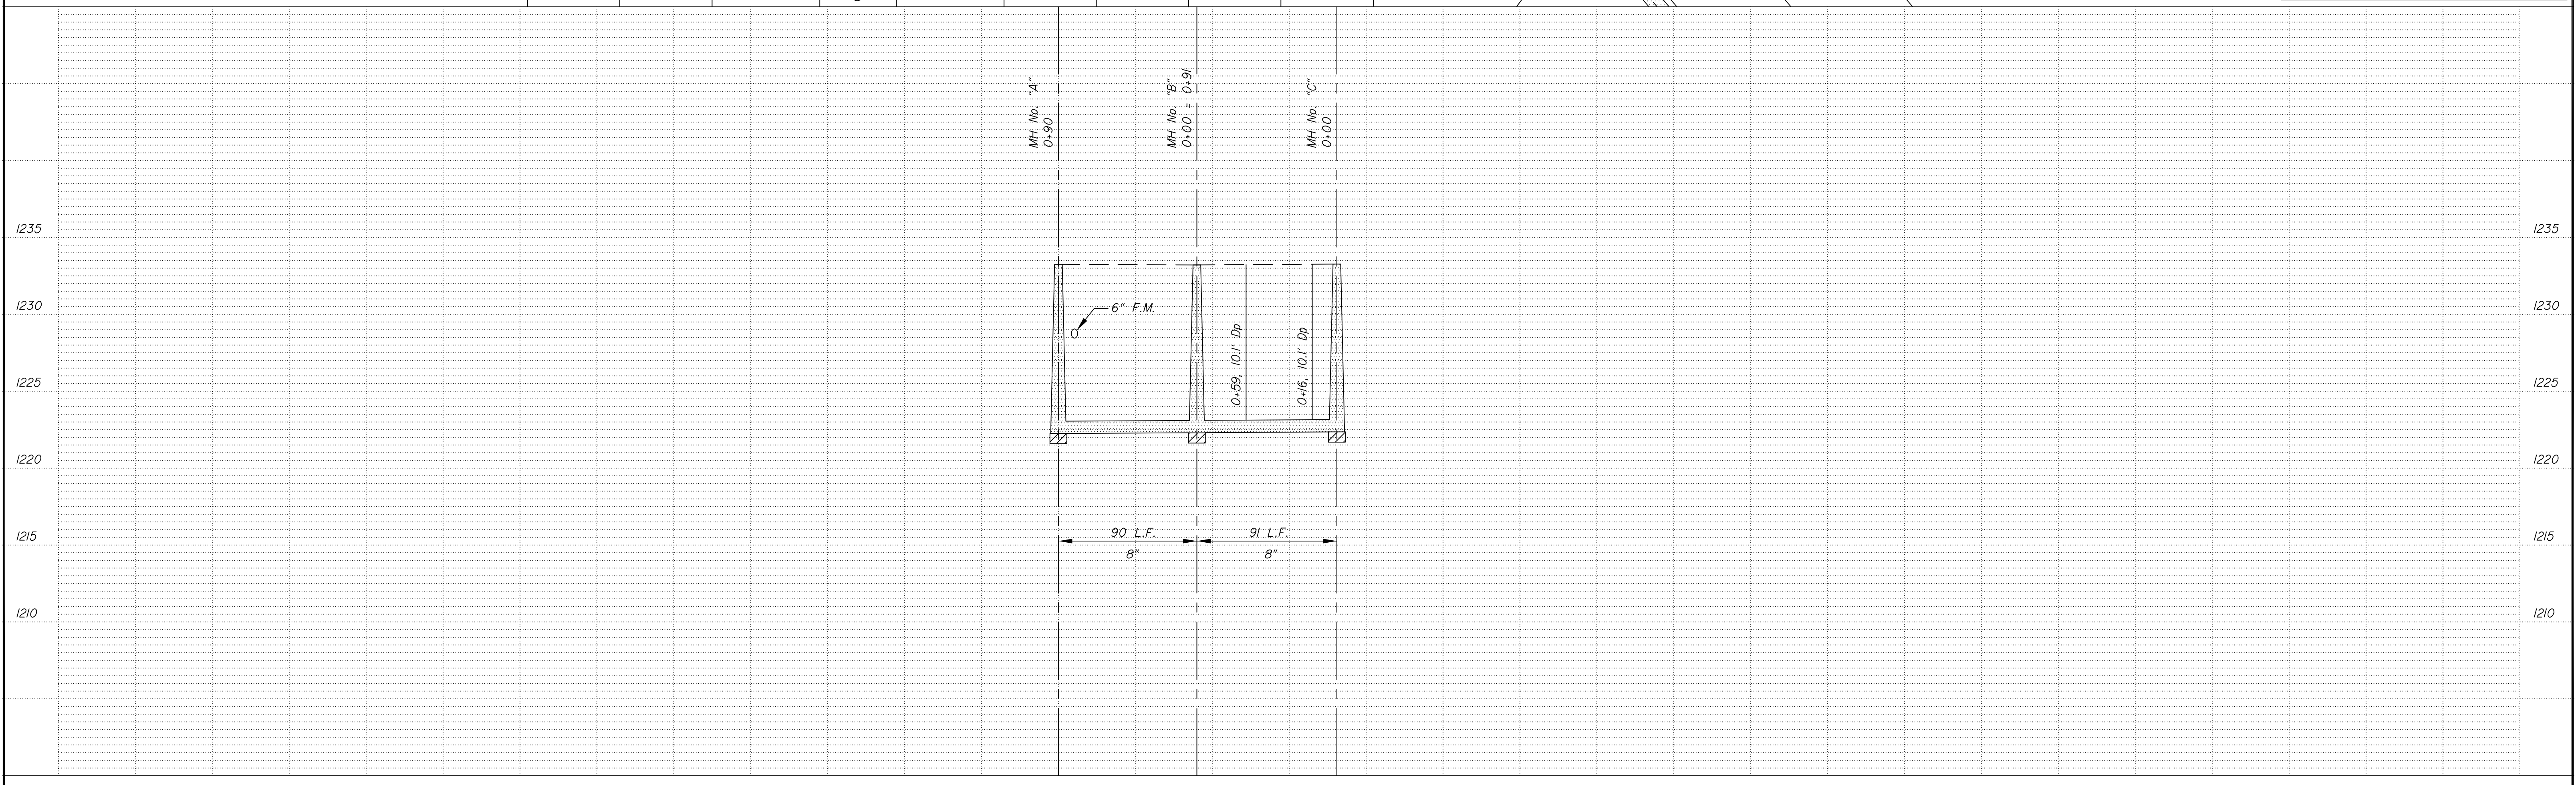

NO.	REVISIONS	DATE	BY

PROJECT TITLE: Sanitary Sewer As-Built Drawing

CONTRACTOR:	DESIGN:	CHECKED:
SCALE: As Shown	DRAWN:	APPROVED:

CITY OF SALINA ENGINEERING DEPARTMENT
300 WEST ASH SALINA, KANSAS 67401
PH: 785.309.5725 FAX: 785.309.5713

DATE: REV: Jun 2003
FILENAME: 579.dwg
PROJ. NO.:
SHEET: OF: