


SCALE
 PLAN: 1" = 100'
 Horiz & Vert
 PROFILE:
 Horiz 1" = 100'
 Vert 1" = 10'

TBM: "M" in Mueller top of fire hydrant
 SE corner Sierra and Mitchell.
 Elev = 1235.67

City BM No. 93: "M" in Mueller top of
 fire hydrant NW corner Sequoia
 and Huntington.
 Elev = 1233.97

NOTE: All Sanitary Sewer mains are 8"
 unless noted otherwise.

NOTE: All Streets are PRIVATE!

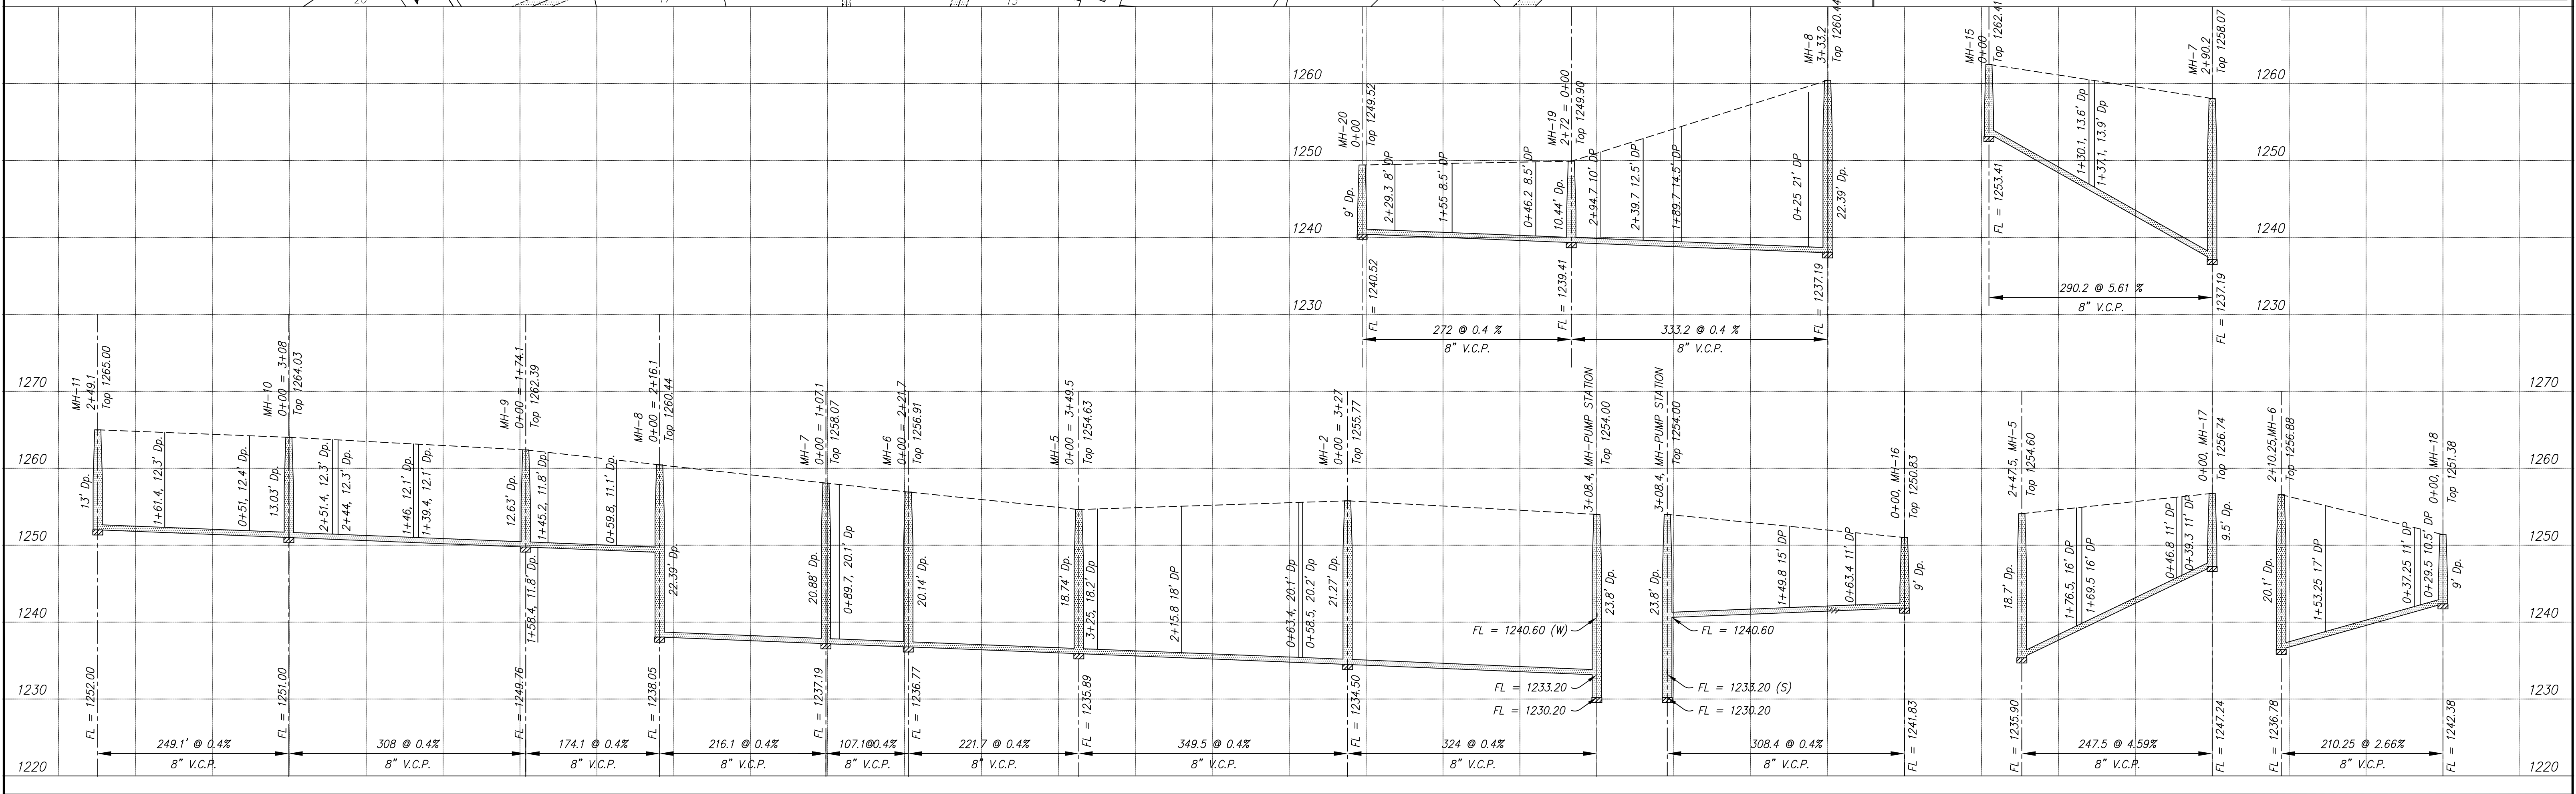

NO.	REVISIONS	DATE	BY

PROJECT TITLE:
Sanitary Sewer As-Built Drawing

CONTRACTOR:
 Stevens Cont.

SCALE:
 As Shown

DESIGN:
 DRAWN:

CHECKED:
 APPROVED:

CITY OF SALINA
 ENGINEERING DEPARTMENT
 300 WEST ASH SALINA, KANSAS 67401
 PH: 785.309.5725 FAX: 785.309.5713

DATE:
 Dec 96

FILENAME:
 582.dwg

PROJ. NO.:
 95-950

SHEET:
 OF